

REFERENCE DATA

CRESCENT REFRACTORIES CO.

CURWENSVILLE, CLEARFIELD COUNTY, PA.

ENGINEERING DEPARTMENT

LAND LEASED FROM, EDWARD KIRK,

LUMBER CITY PA.

ENV. No. ~~0-1~~


SHEET No ~~61~~

55-3-66

DATE 5-25-18

SCALE 1" = 400'

MRS. A. M. HIPPS

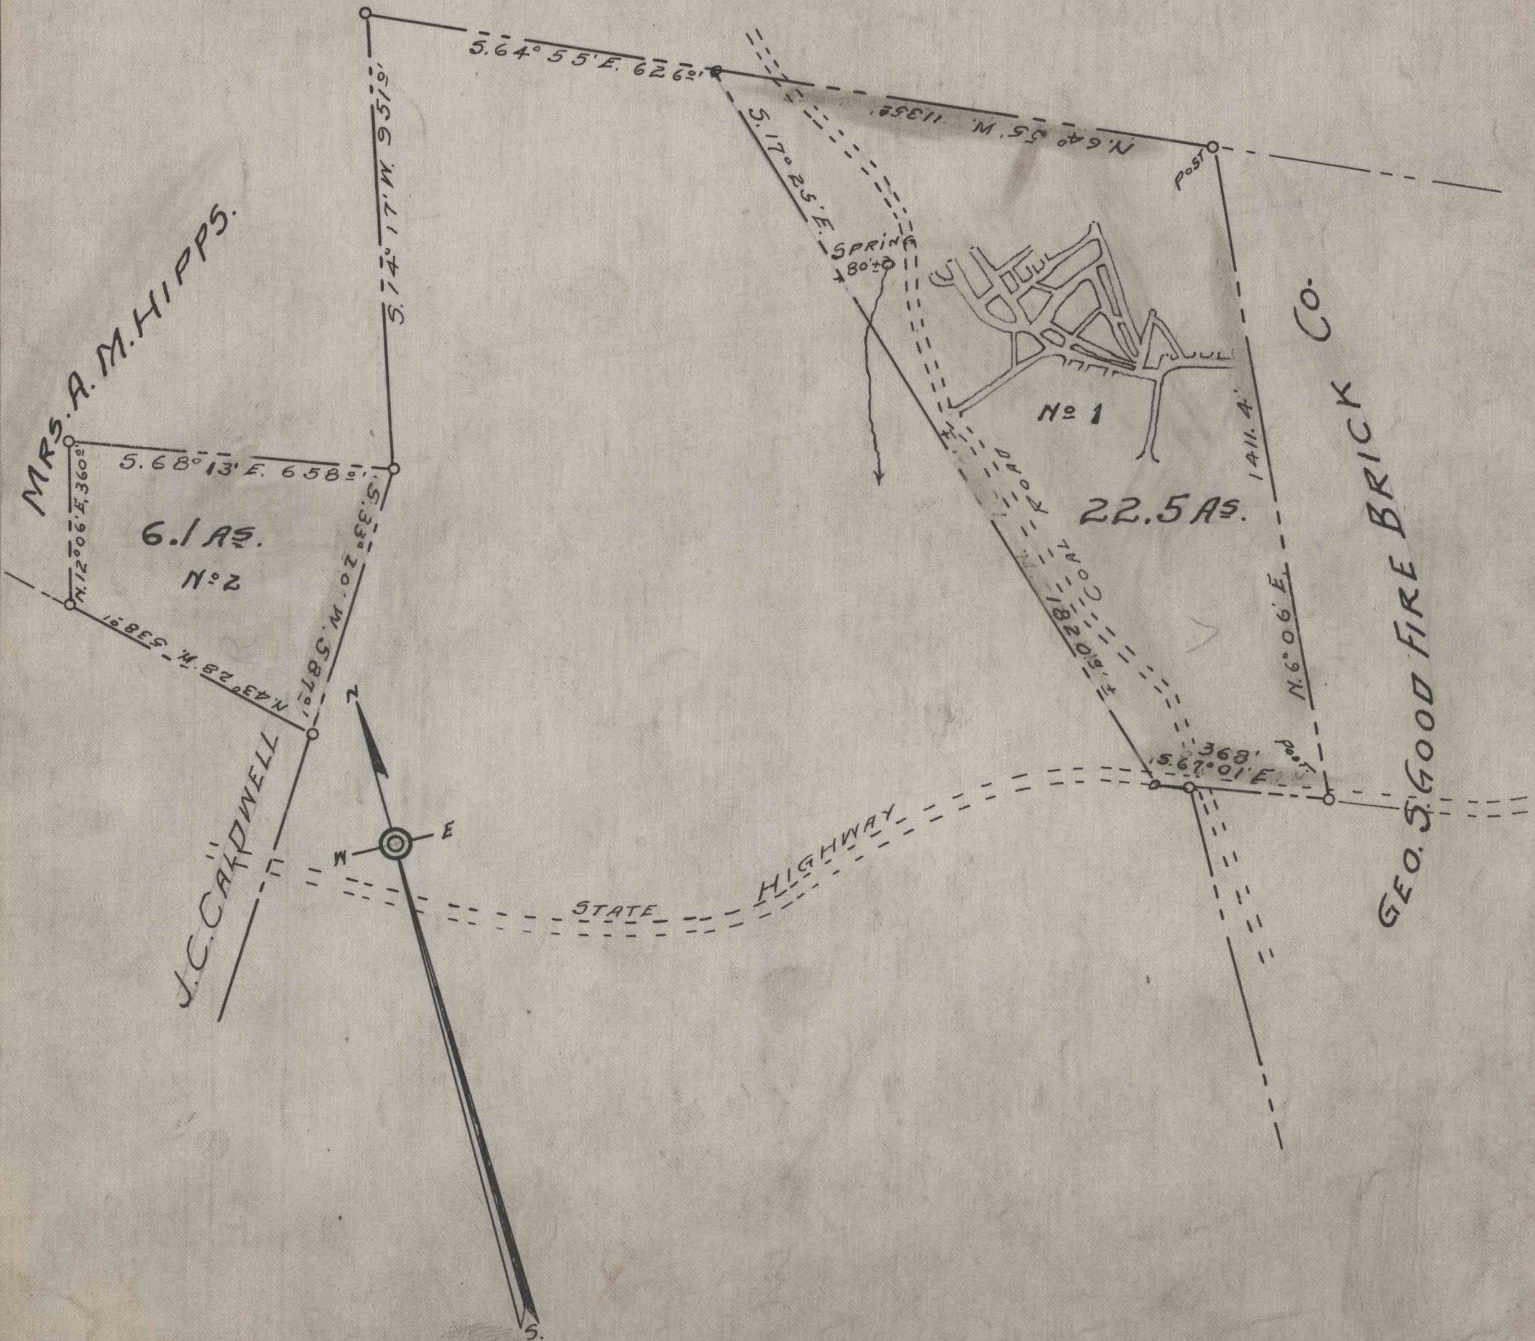

WORKED FROM

DRAWN BY J.B.D.

CHECKED BY R.H.A.

10/107

A