



See 2408-2

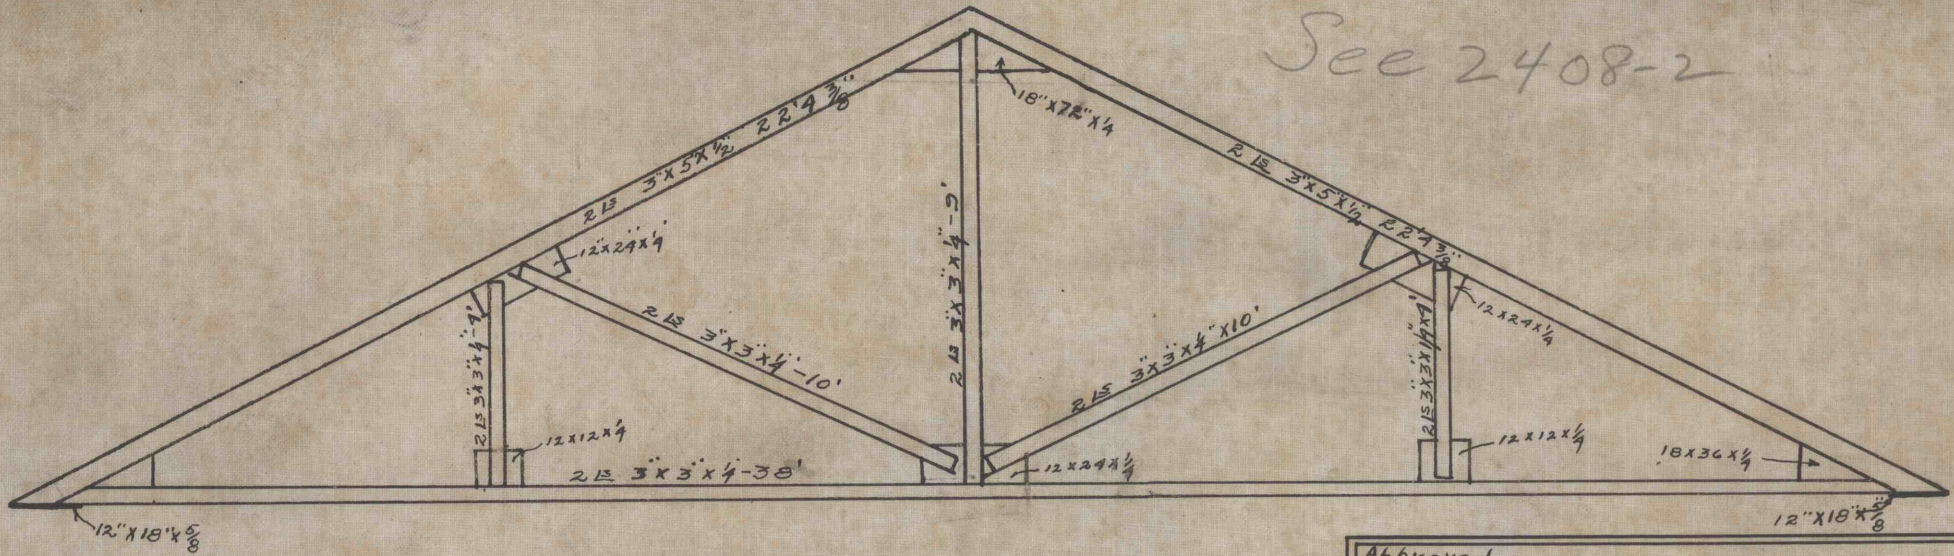

1 TRUSS

4L 3x5x1/2-22'4 3/8"	12.8 lbs.	1144.8 lbs.
2 " 3x3x1/4-38'0"	4.9 lbs.	372.4 lbs.
4 " 3x3x1/4-10'0"	4.9 lbs.	196.0 lbs.
2 " 3x3x1/4-9'0"	4.9 lbs.	88.2 lbs.
4 " 3x3x1/4-9'0"	4.9 lbs.	78.4 lbs.
2 plates 12x18x5/8	25.5 lbs.	76.5 lbs.
1 " 18x72x1/4	15.3 lbs.	91.8 lbs.
3 " 12x24x1/4	10.2 lbs.	61.2 lbs.
2 " 12x12x1/4	10.2 lbs.	20.4 lbs.
Total		2129.7 lbs

4x3x5/16 7.2 = 547.2
372.4
174.

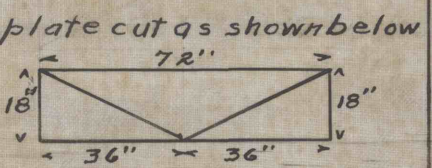

1348
-2304.0
124
2317.8
2327.2
99.2
76.2
22.7

Approved	
Albert Smith Sattsburg Pa.	
GRAFF MINING CO.	
BLAIRSVILLE PA.	
ROOF TRUSS	
FOR	
MACHINE SHOP	
Scale 1/4" = 1'	10-3-19
Drawing	Plant
34-1	1&2

West-~~2448/1~~ -~~1-1~~
5221/1