


INDEX

Letter - Date - Surveyed By - Plotted By  
A - Oct. 13, 1936 - T.E. West - T.E. West

DIAS  
MINE

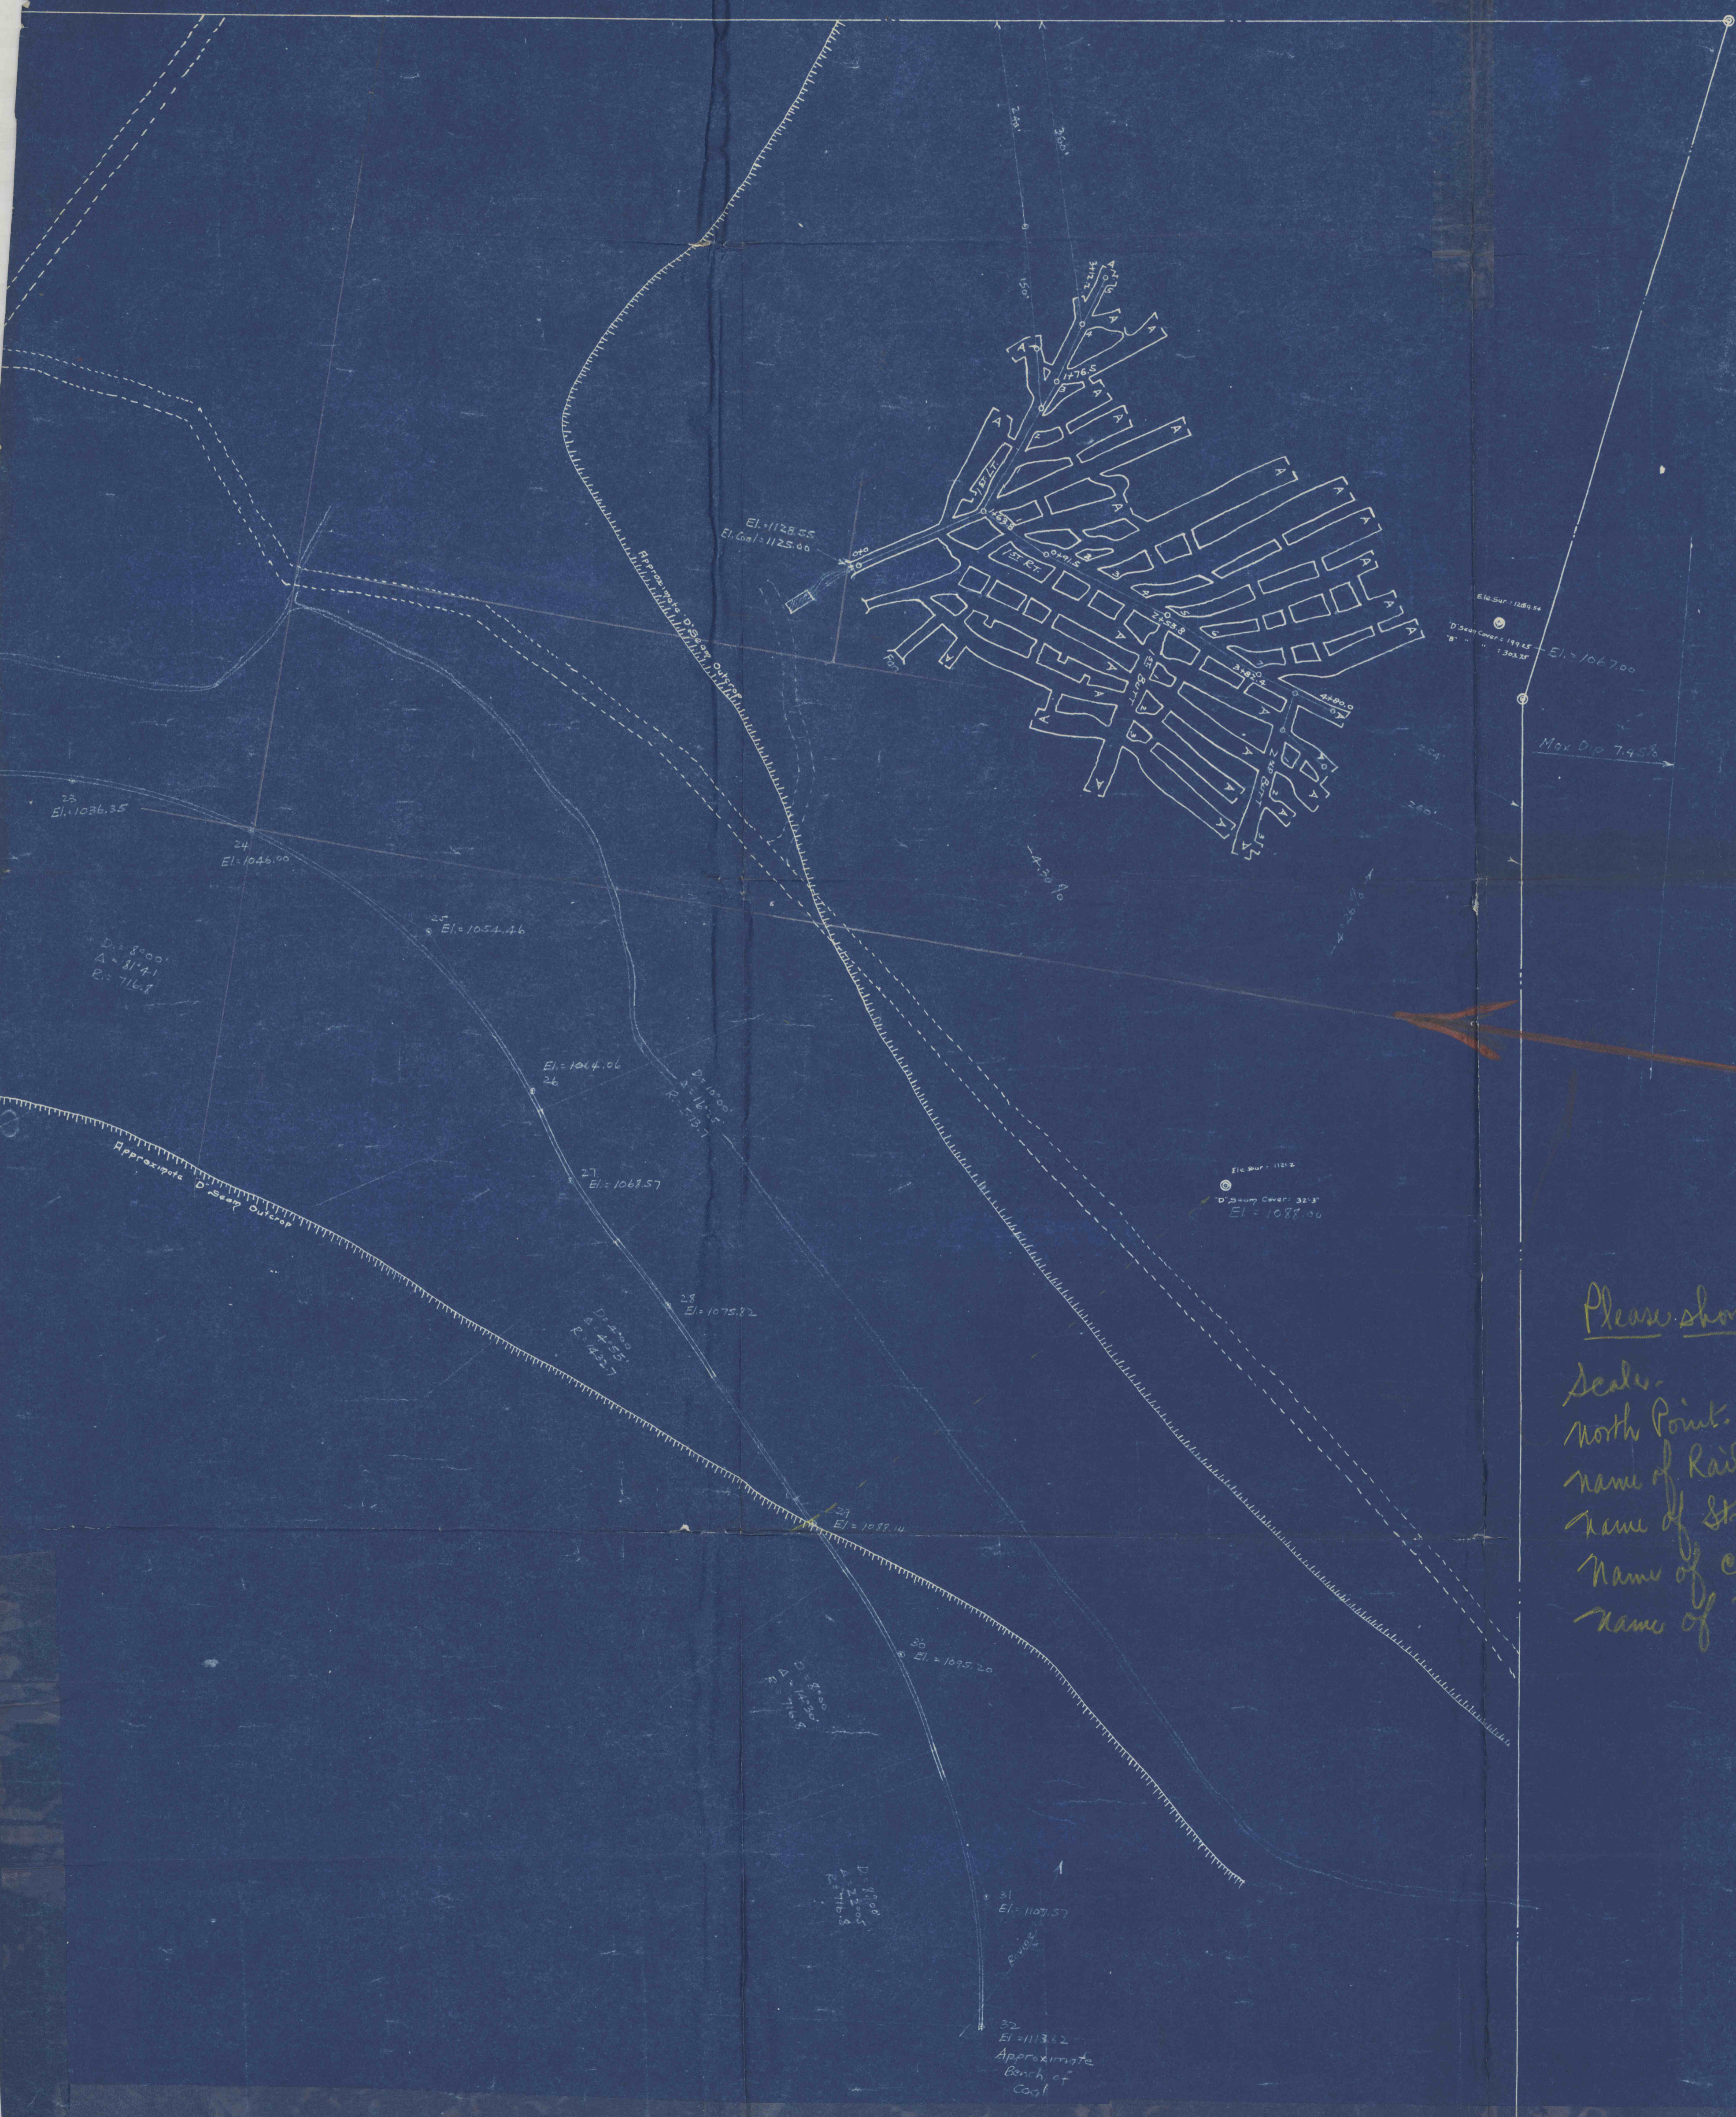

Please show.

- Scale. 1" = 100'
- North Point.
- Name of Railroad Blacklick-Brandy PRR.
- Name of Stream Campbell Run.
- Name of coal seam worked Lower Treaton
- Name of Township West Marshall

1936