


MAP OF  
LARIMER GAS COAL CO

SCALE 1"=100'  
D. C. Walker Law Engr

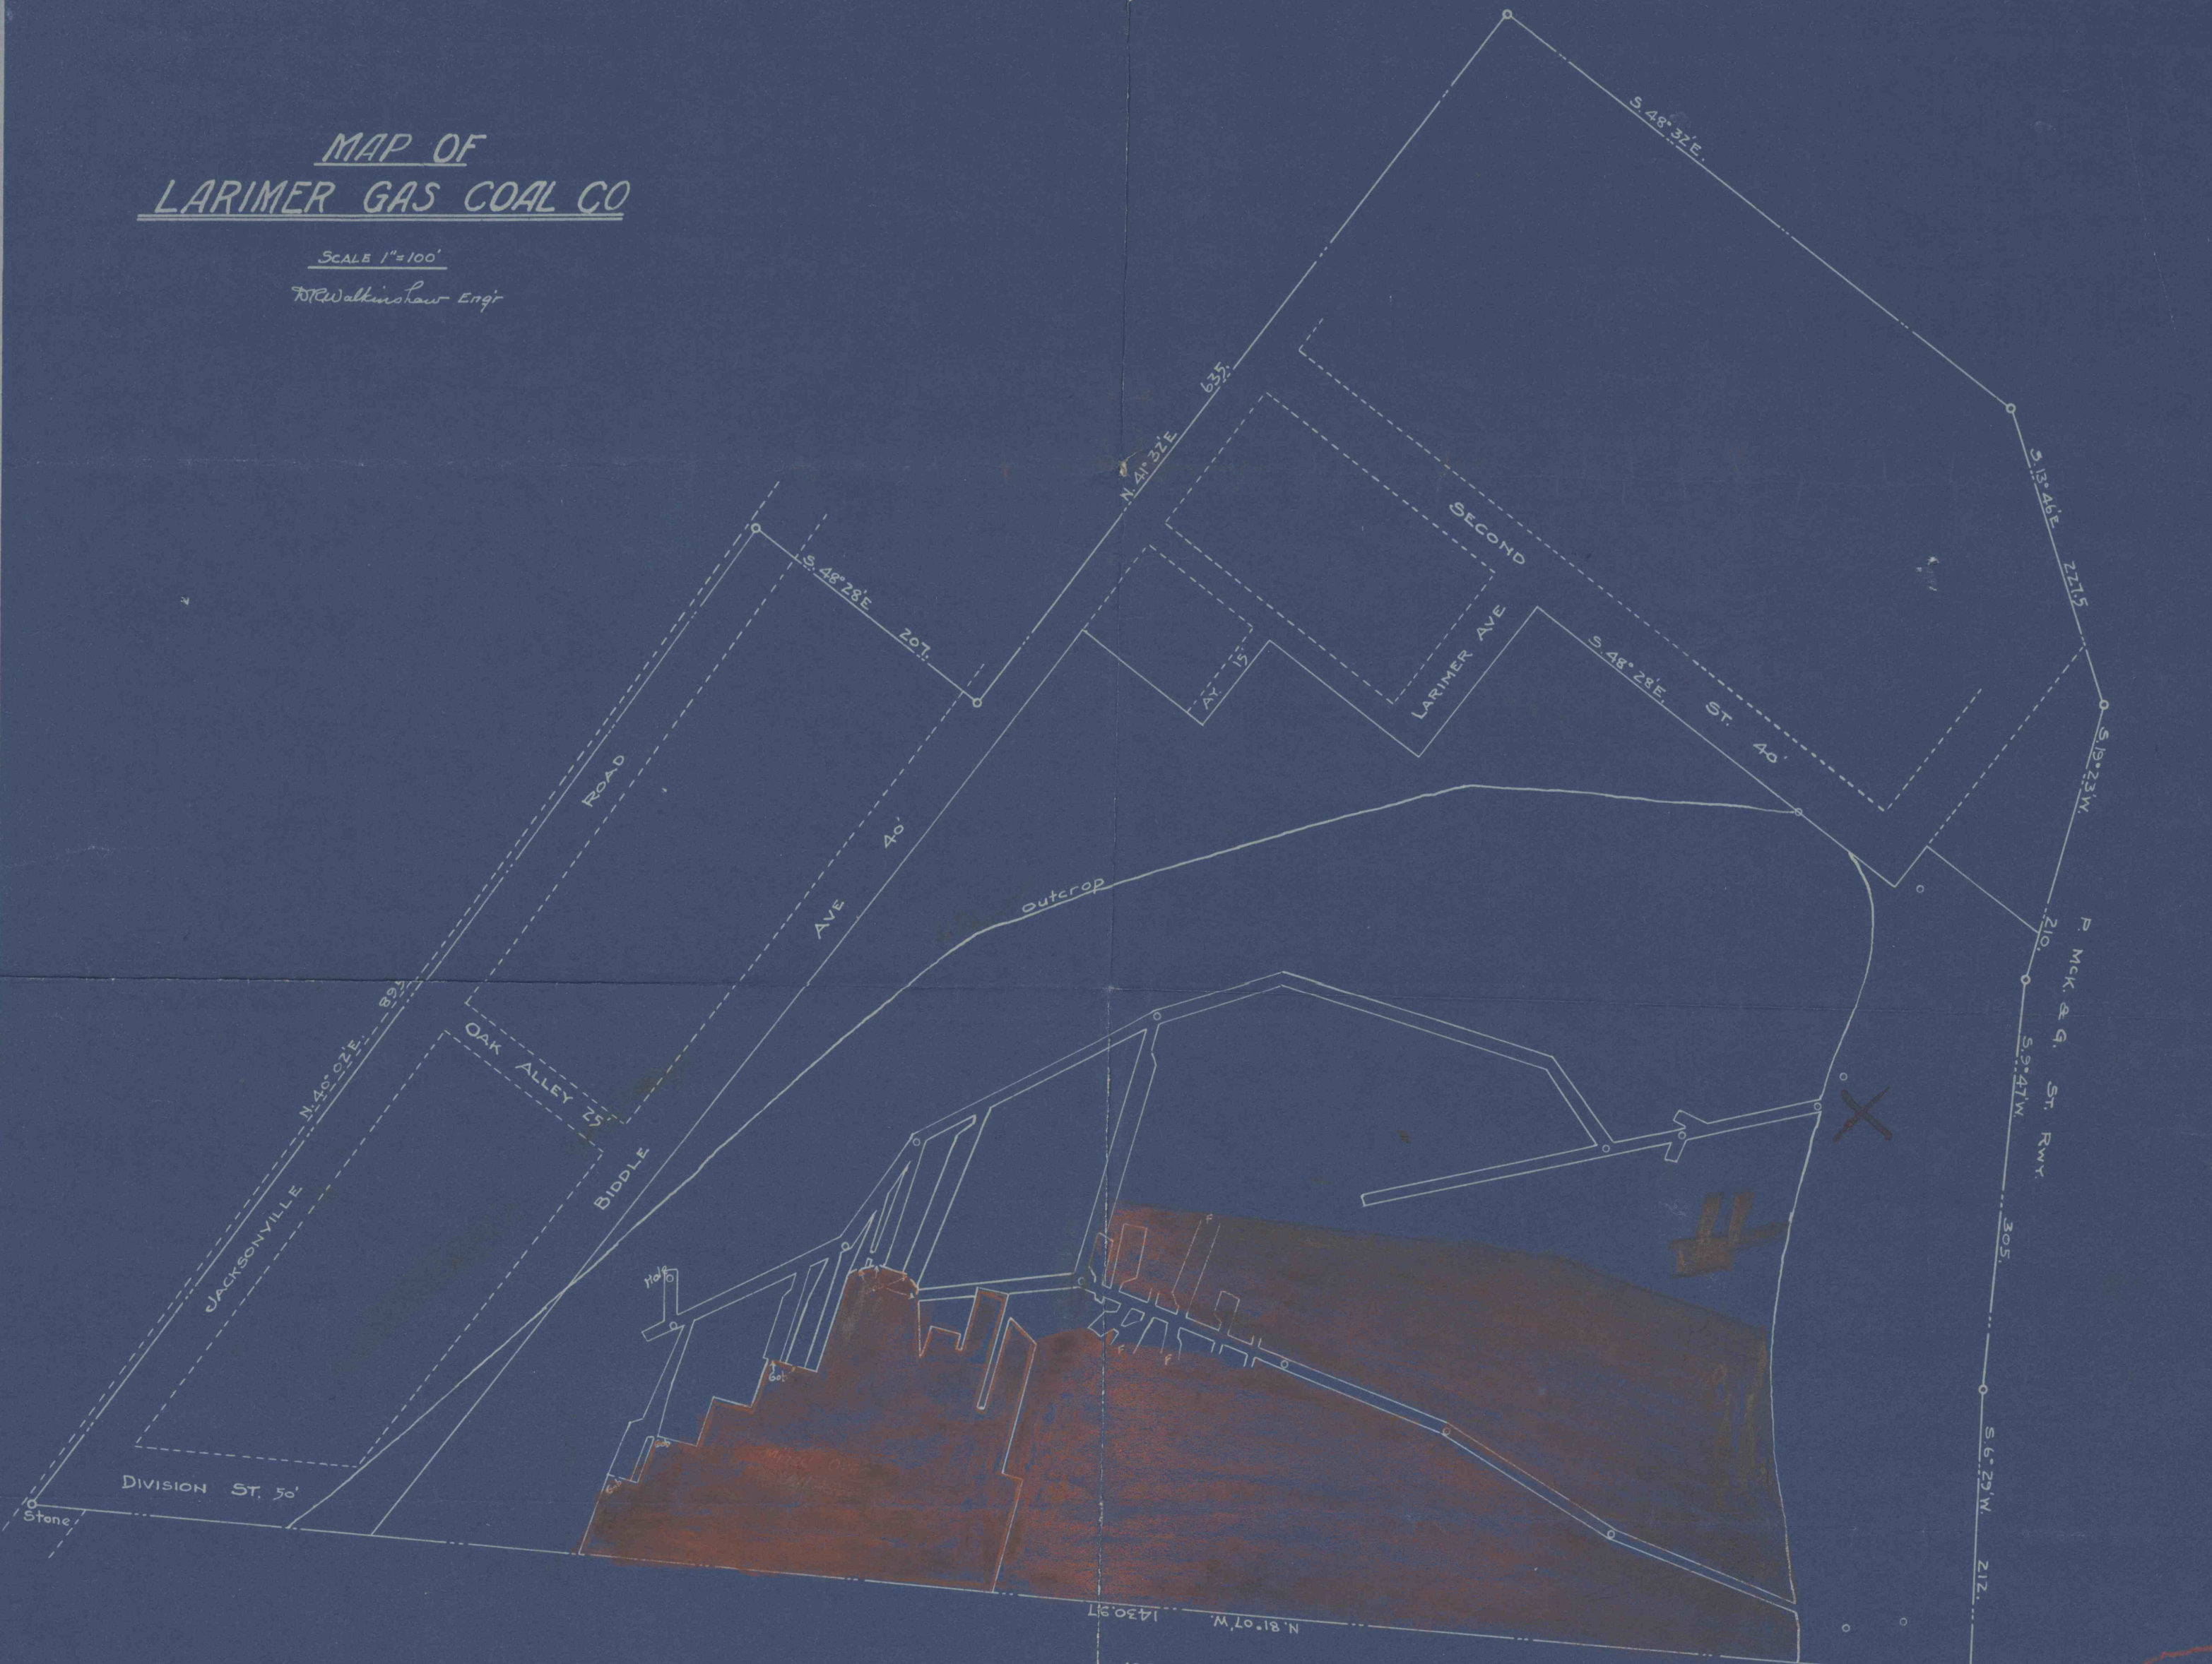

Surface and all coal was purchased, no actual acreage given, but when we opened at mark X and developed main entry we discovered coal marked in red had been mined by Westmoreland Coal Co. some twenty years ago

*(Handwritten signature)*