


Map of
BEDS CREEK No. 1
 SHOWING WORKINGS IN
 MILLER VEIN.

| | |
|--|-------------------------|
| COMMONWEALTH OF PENNSYLVANIA | |
| DEPARTMENT OF MINES & MINERAL INDUSTRIES | |
| HARRISBURG | |
| DATE | 1906 |
| BY | W. B. COLEMAN |
| OF | CHESBIA CO., DISTRICT 4 |
| SCALE | 1" = 100' HORIZ. |
| PRICE | 10 CENTS |

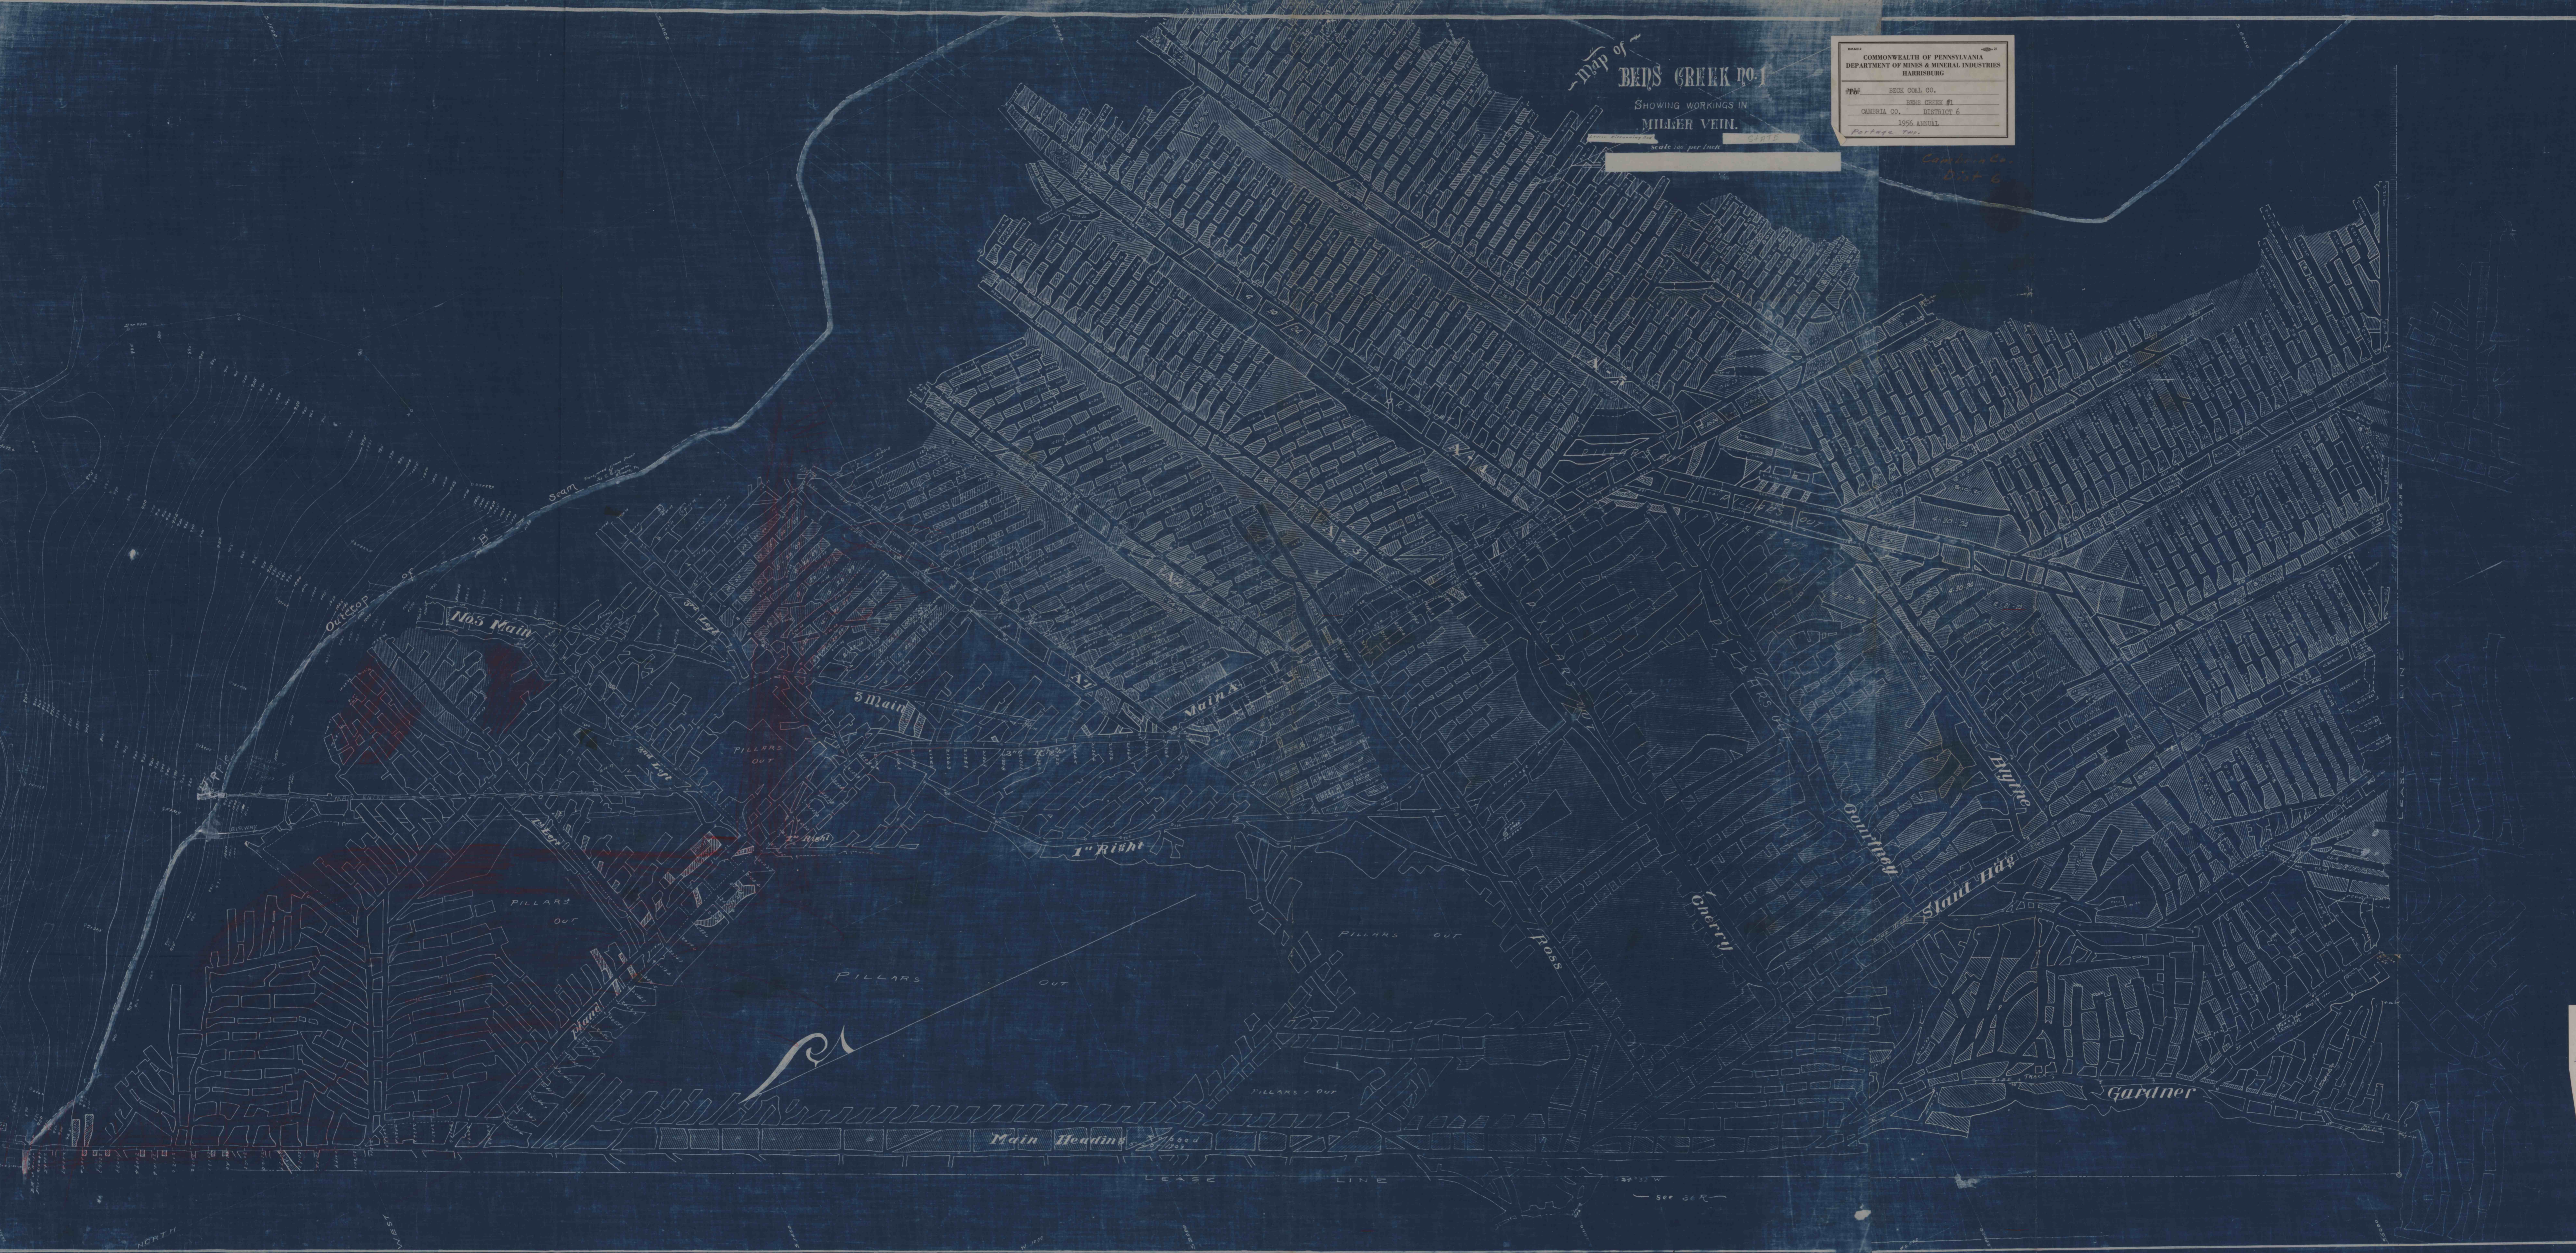

The area outside
 the red line has been
 provided for many years
 we have never been able
 to enter that area
 Francis Bode