




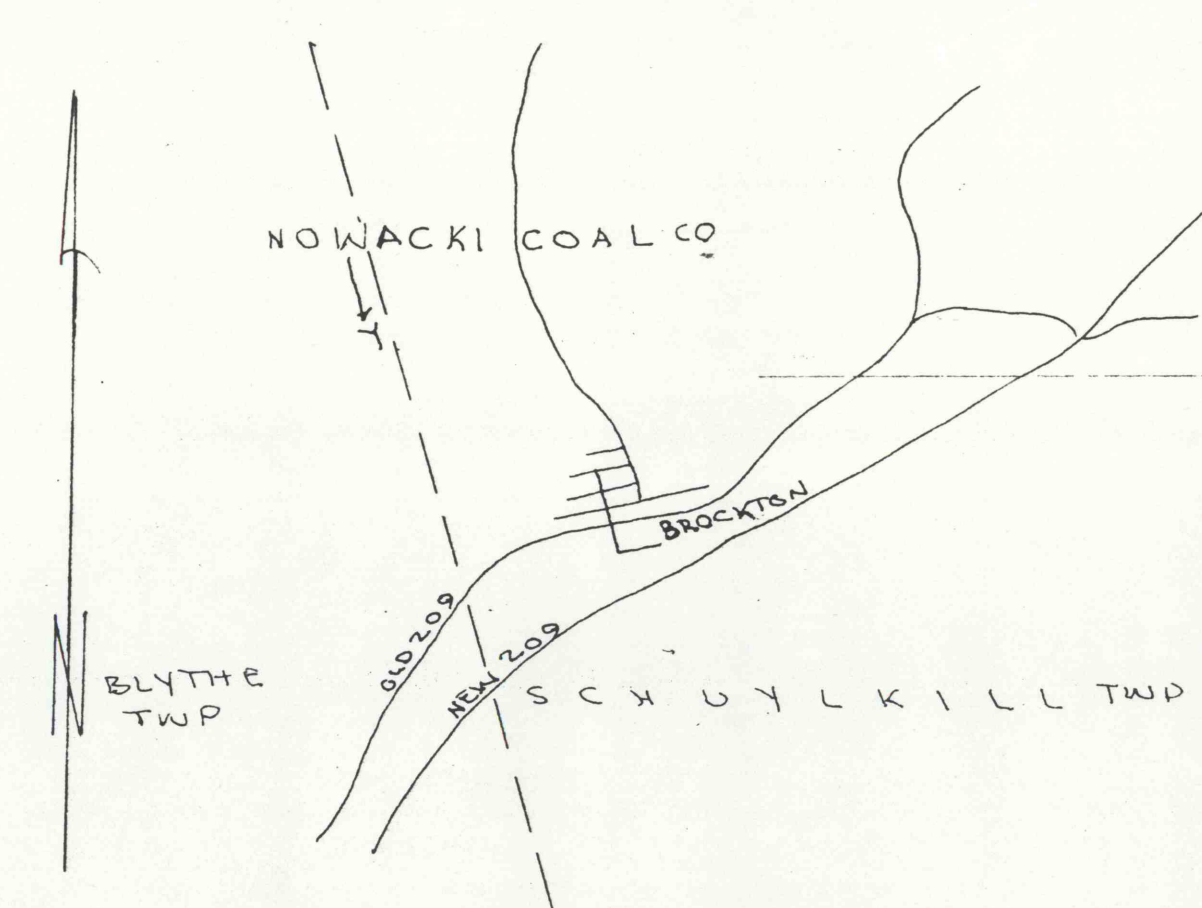

LOCATION MAP
SCALE 1" = 2000'

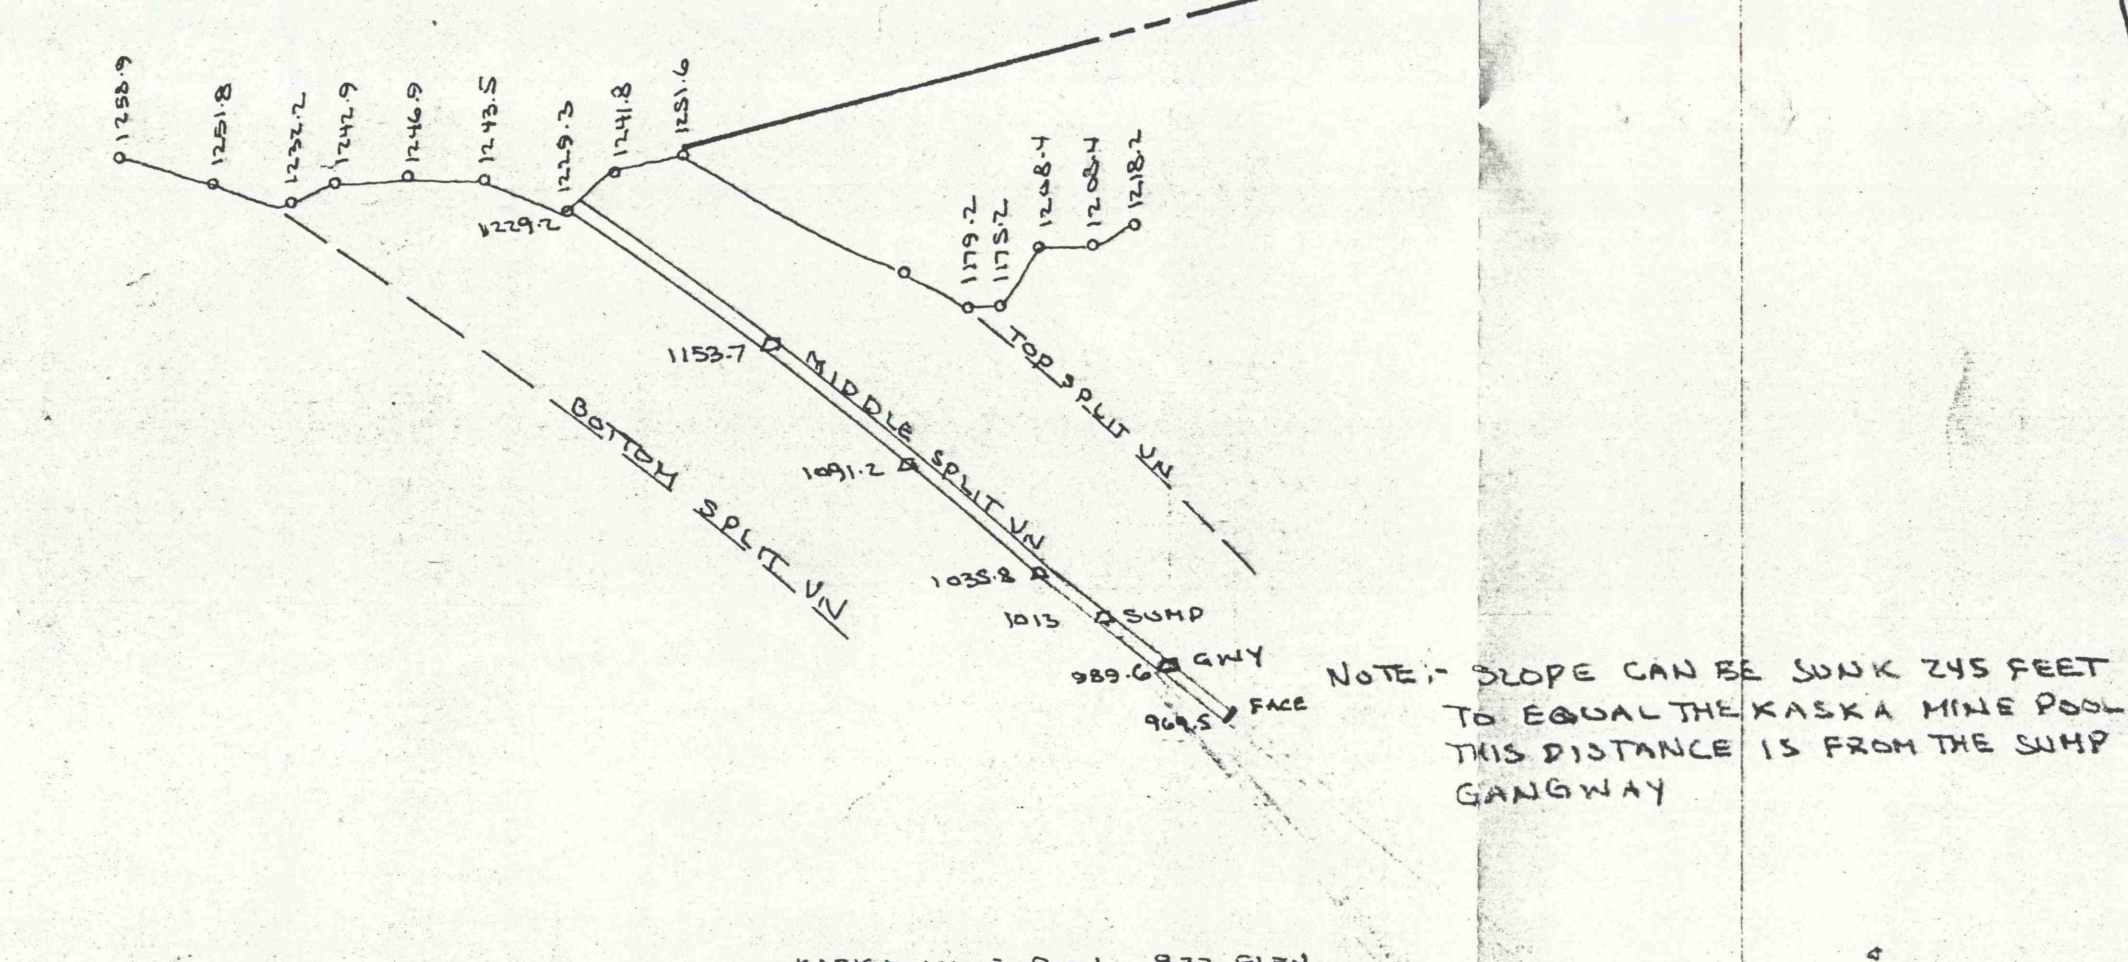

DATUM '780' SCALE 1" = 100' LOOKING EAST
SECTION THROUGH NOWACKI COAL CO. SLOPE
MIDDLE SPLIT VEIN

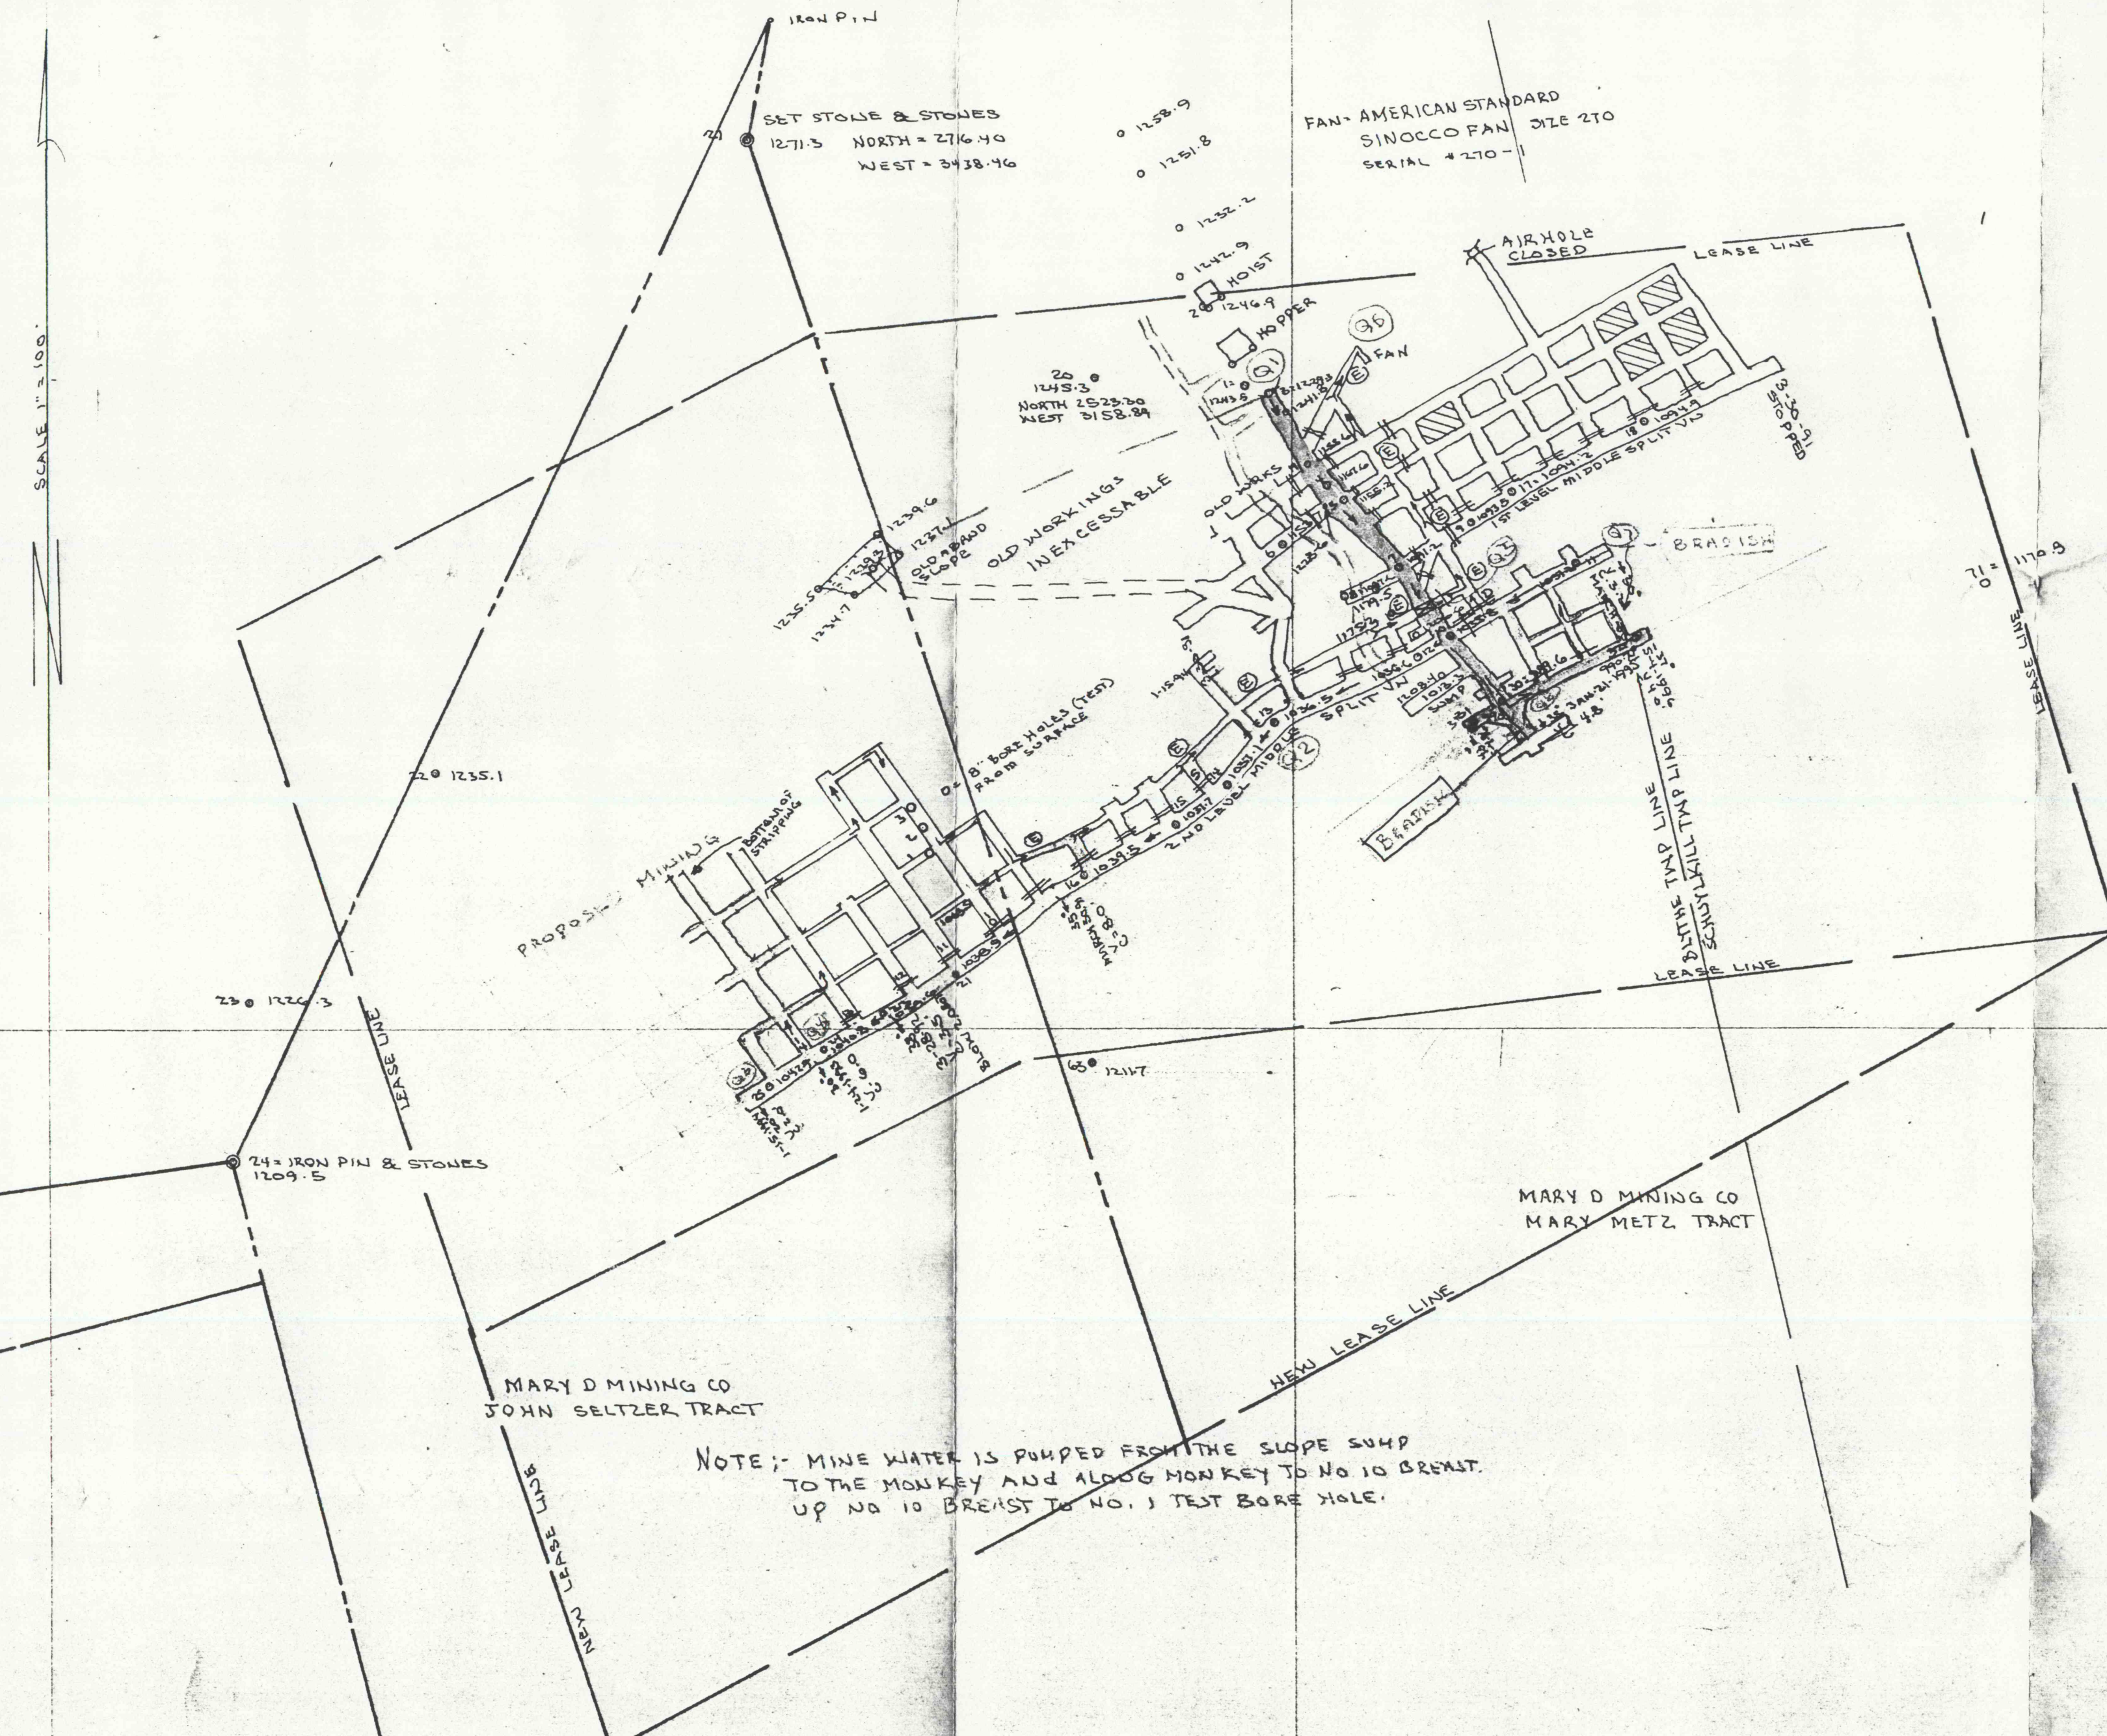


NOTE: MINE WATER IS PUMPED FROM THE SLOPE SUMP TO THE MONKEY AND ALDOG MONKEY TO NO. 10 BENT UP NO. 10 BENT TO NO. 1 TEST BORE HOLE.

NOWACKI COAL COMPANY ID #34-07592 SCHUYLKILL & BLYTHE TWP. SCHUYLKILL CO.
NOTE: THERE IS NO KNOWN POOLED WATER ON THE SURFACE WITHIN THE MAPPED AREA. THE SUB-SURFACE LEVELS ARE AT LOCATIONS & ELEVATIONS SHOWN ON THE MAP. THERE ARE NO A.R. OR PAVED ROADS LEADING TO THE MINE. ACCESS IS FROM A DIRT ROAD SHOWN ON THE MAP. PERMANENT BUILDINGS ON THE SITE CONSIST OF THE HOIST HOUSE AND SURFACE FAN, AS SHOWN ON THE MAP. SURFACE SURVEY TIE IN POINTS ARE SHOWN ON THE MAP.

AIR VOLUME	
71	15,750
31	
32	
33	
34	
35	
36	15,500
37	3,120

NOTE: APPROXIMATE LOCATION SILLIMAN SLOPE IN THE BOTTOM SPLIT VEIN NO MINING INFO. AVAILABLE ON 100' TO 1" MAP. THE INFORMATION ON THE 500' TO 1" MAP SUBMITTED NOVEMBER 5, 1991 IS THE ONLY INFORMATION I CAN FIND AND ONLY SHOWS WORKINGS ON THE BOTTOM SPLIT VEIN.

MIDDLE SPLIT VEIN WORKINGS OF NOWACKI SHOWN IN YELLOW
PROPOSED NEW WORKINGS SHOWN IN RED
BRADISH CLOTH SHOWN IN RED
ELEVATION BASE FROM SET STONE BY HUDSON COAL CO. SITUATE AT THE SOUTH WEST CORNER OF THE ADAM STAHL TRACT.

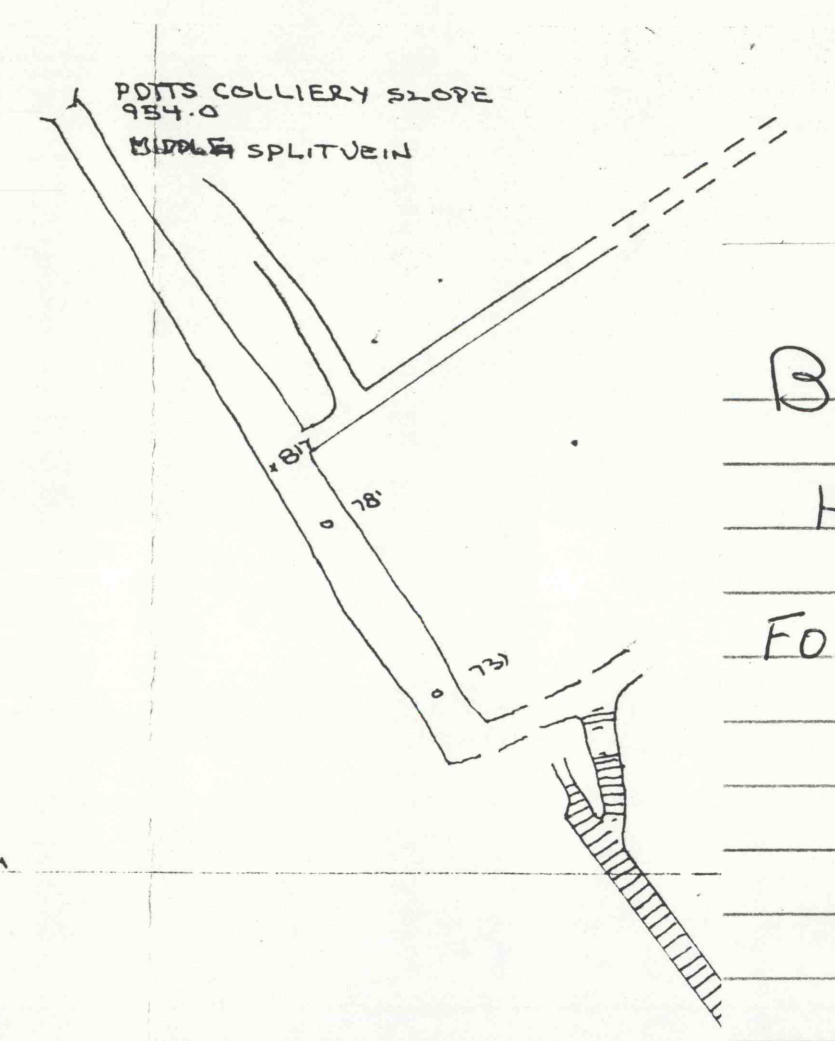

Bob
HERE'S MINE
FOR 1996
TAKE C
ED + RHON

- LEGEND
- DOOR = D
 - STOPPING = ||
 - OVERCAST = []
 - BRATTIC = []
 - DIRECTION OF AIR = →
 - REGULATOR = R
 - CURTAIN OR CHECK = C
 - FAN = F
 - ESCAPE WAY = E
 - BONDED SURFACE AREA
 - PROPOSED NEW WORKINGS

COUNTY LEASE NO. 7A
NOWACKI COAL COMPANY
SITUATE IN SCHUYLKILL & BLYTHE TWP.
SCHUYLKILL CO. PA.
SURVEYED MARCH 30, 1991 SCALE 1" = 100'
WALTER J. HANNAH R. SHIATORE PENNSYLVANIA
MINE I.D. # 34-07592
POSTED JAN. 24, 1993
POSTED JAN. 15, 1994
POSTED JAN. 21, 1995
POSTED MAY 4, 1996