
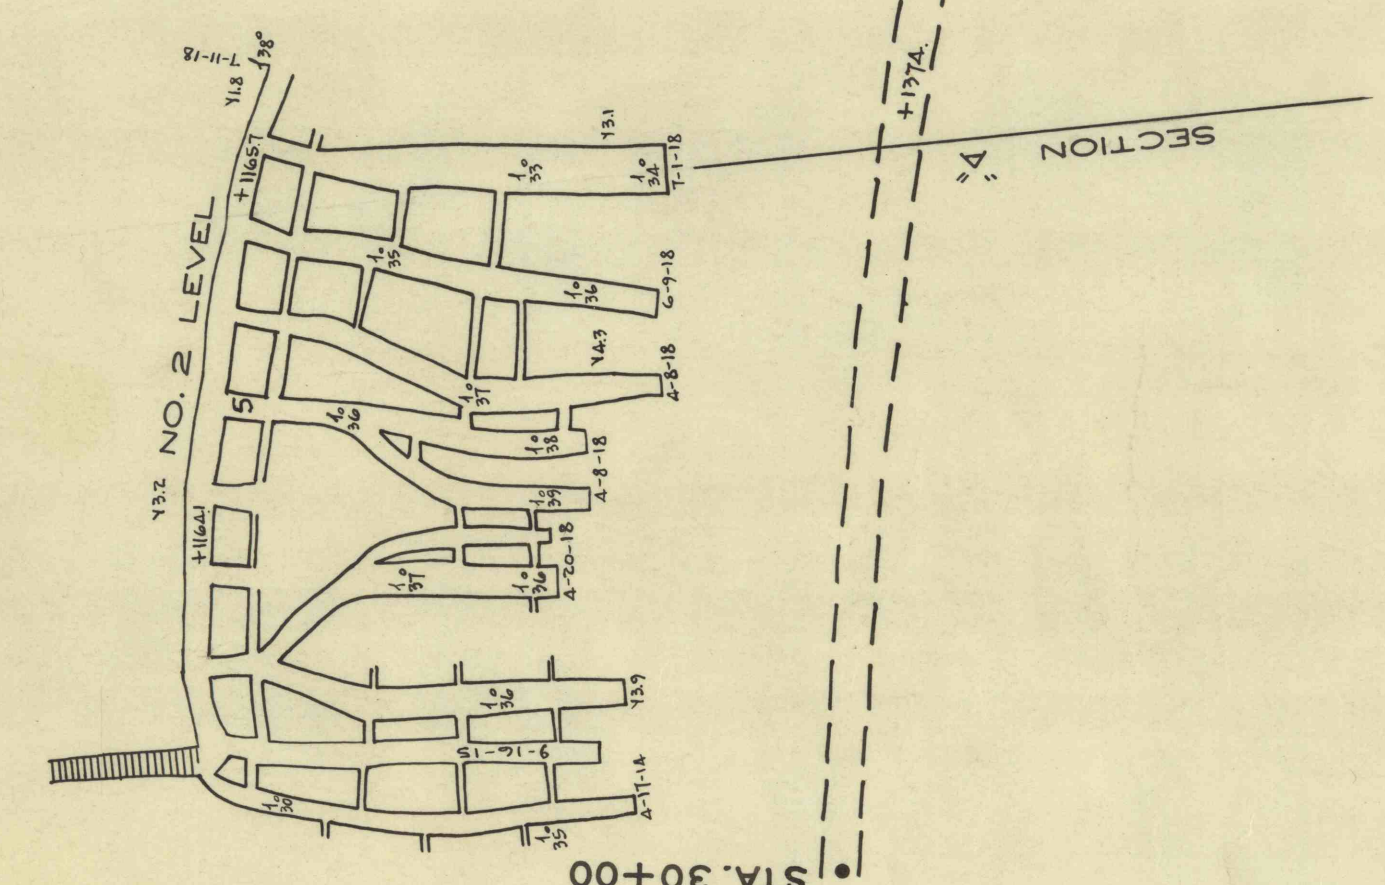
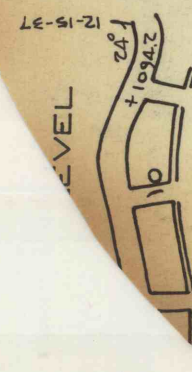


NOTE:-
 AREA ENCLOSED BY SOLID RED LINE TO BE
 DURING THE FOLLOWING MONTHS

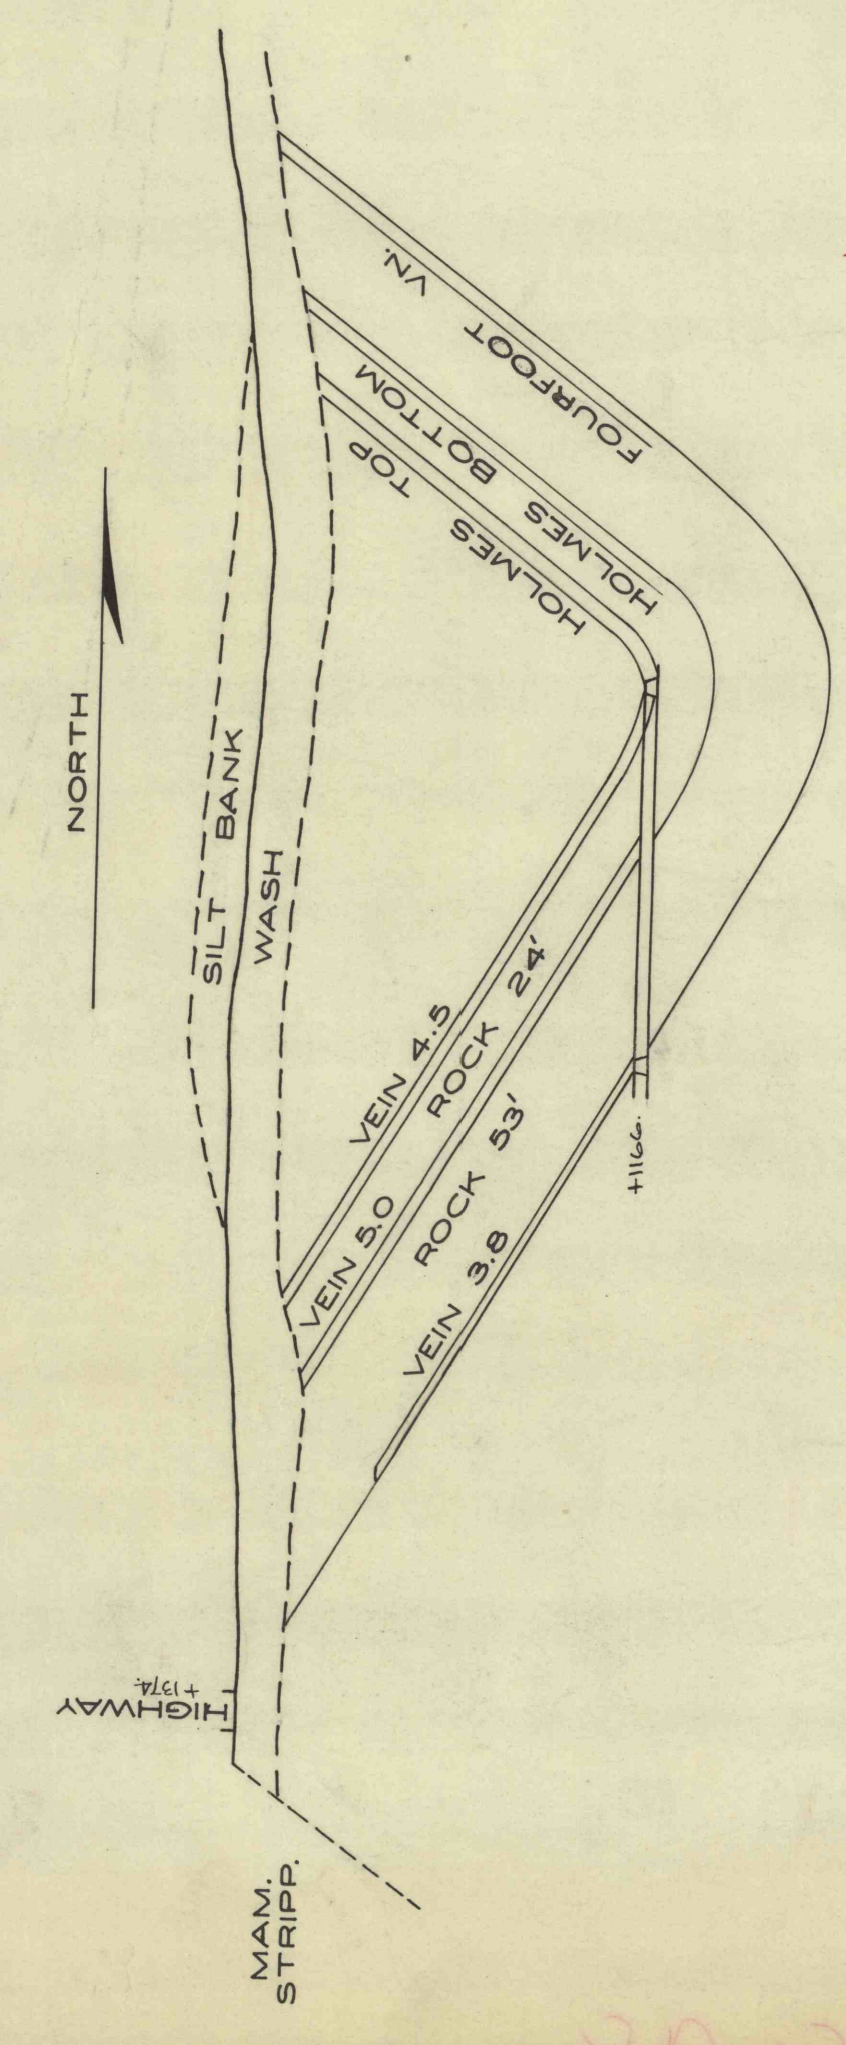

CENTRALIA COLLIERIES CO. INC.
 CENTRALIA, PENNA. LESSEE
 LEHIGH VALLEY COAL CO.
 WILKES-BARRE, PENNA. OWNER
 FOURFOOT VEIN

IN RELATION TO
 STATE HIGHWAY ROUTE NO. 19083

SCALE 1"=100'

SECTION "A" DATUM +1000

SUPT. OF MINING MIN. ENGR.

8880