

NORTH 5000


NORTH 0

NORTH 5000

NORTH 5000



DESIGNED BY: Victor Raczk	APPROVED BY: Lisa M. Mahall, P.E.	REVISIONS:
DATE: 12/08/97	PROJ. NO.: 001	
DWG. NO.: 001	DWG. NO.: COGEN.DWG	

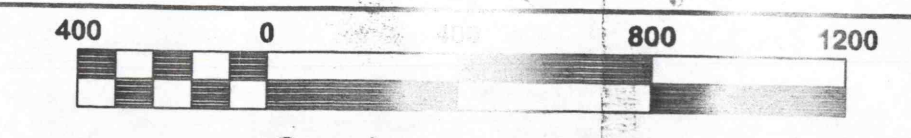

Reading Anthracite Company
200 Mahantongo Street
Pottsville, PA 17004

PROJECT: As Built Survey of
Schuylkill Energy Resources

SHEET NAME: Property Map

SHEET NO.: 1