



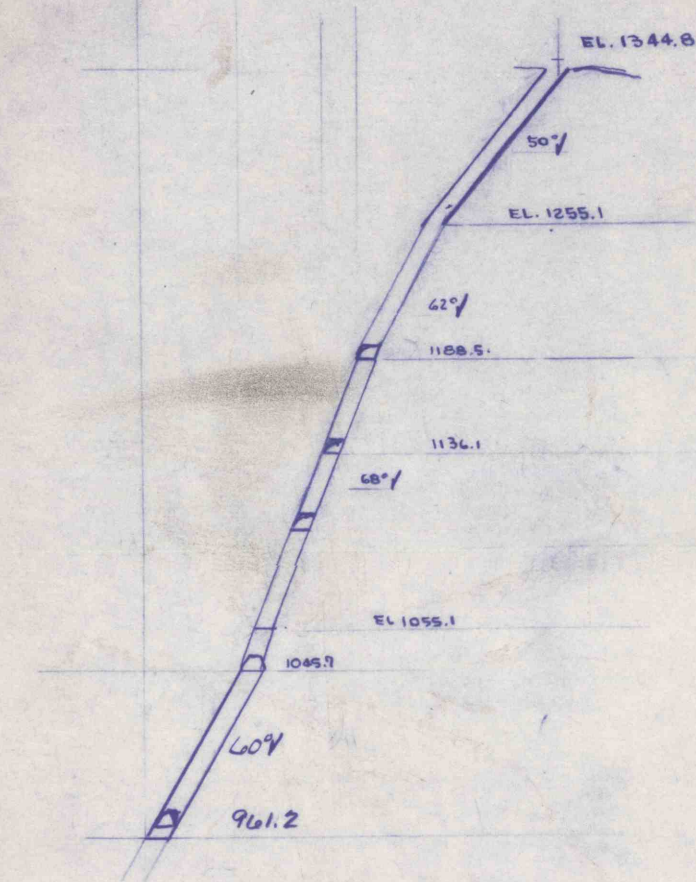

~~TREVERTON ESTATE
ASSOCIATE LANDS~~

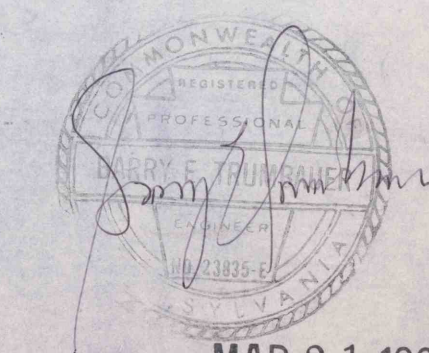

Gwy - STOPPED
BAD CODE
MARCH 7, 1959

SBM
R SNYDER

PLAN OF OPERATION FOR ^{SBM}SNYDER COAL ~~CO~~ JAN. 7 1985

LEGEND

← INTAKE AIR
↔ EXHAUST AIR
= STOPPING
⊙ ESCAPE
⊙ MAIN FAN
R REGULATOR

5/17/77
~~SNYDER~~ COAL ~~80~~
ZERO VEIN
ZERBE TWP. TOWNSHIP
NORTHUMBERLAND CO. PA.
I.D. 36-05495
SCALE 1"=100'-0"
M & R SLOPE

88

556