



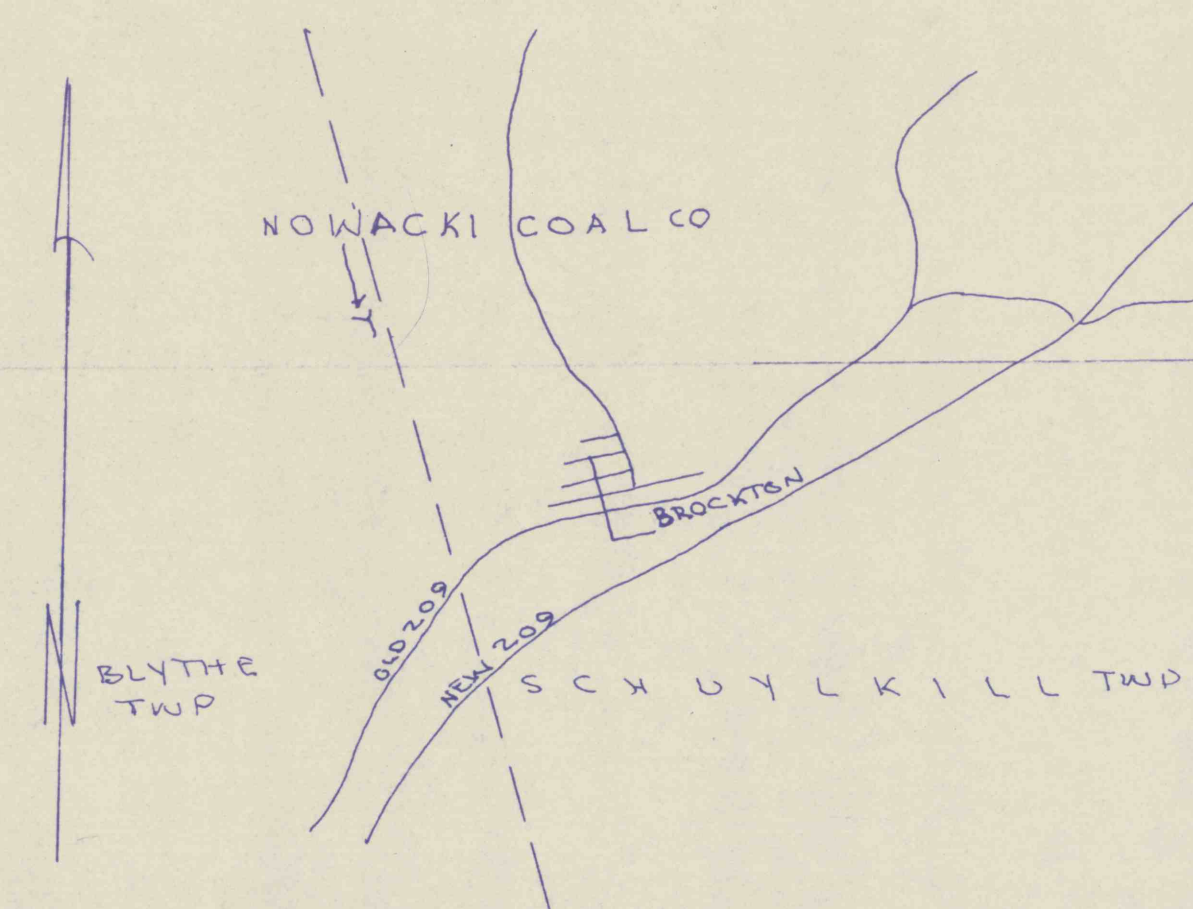

LOCATION MAP
SCALE 1"=2000'

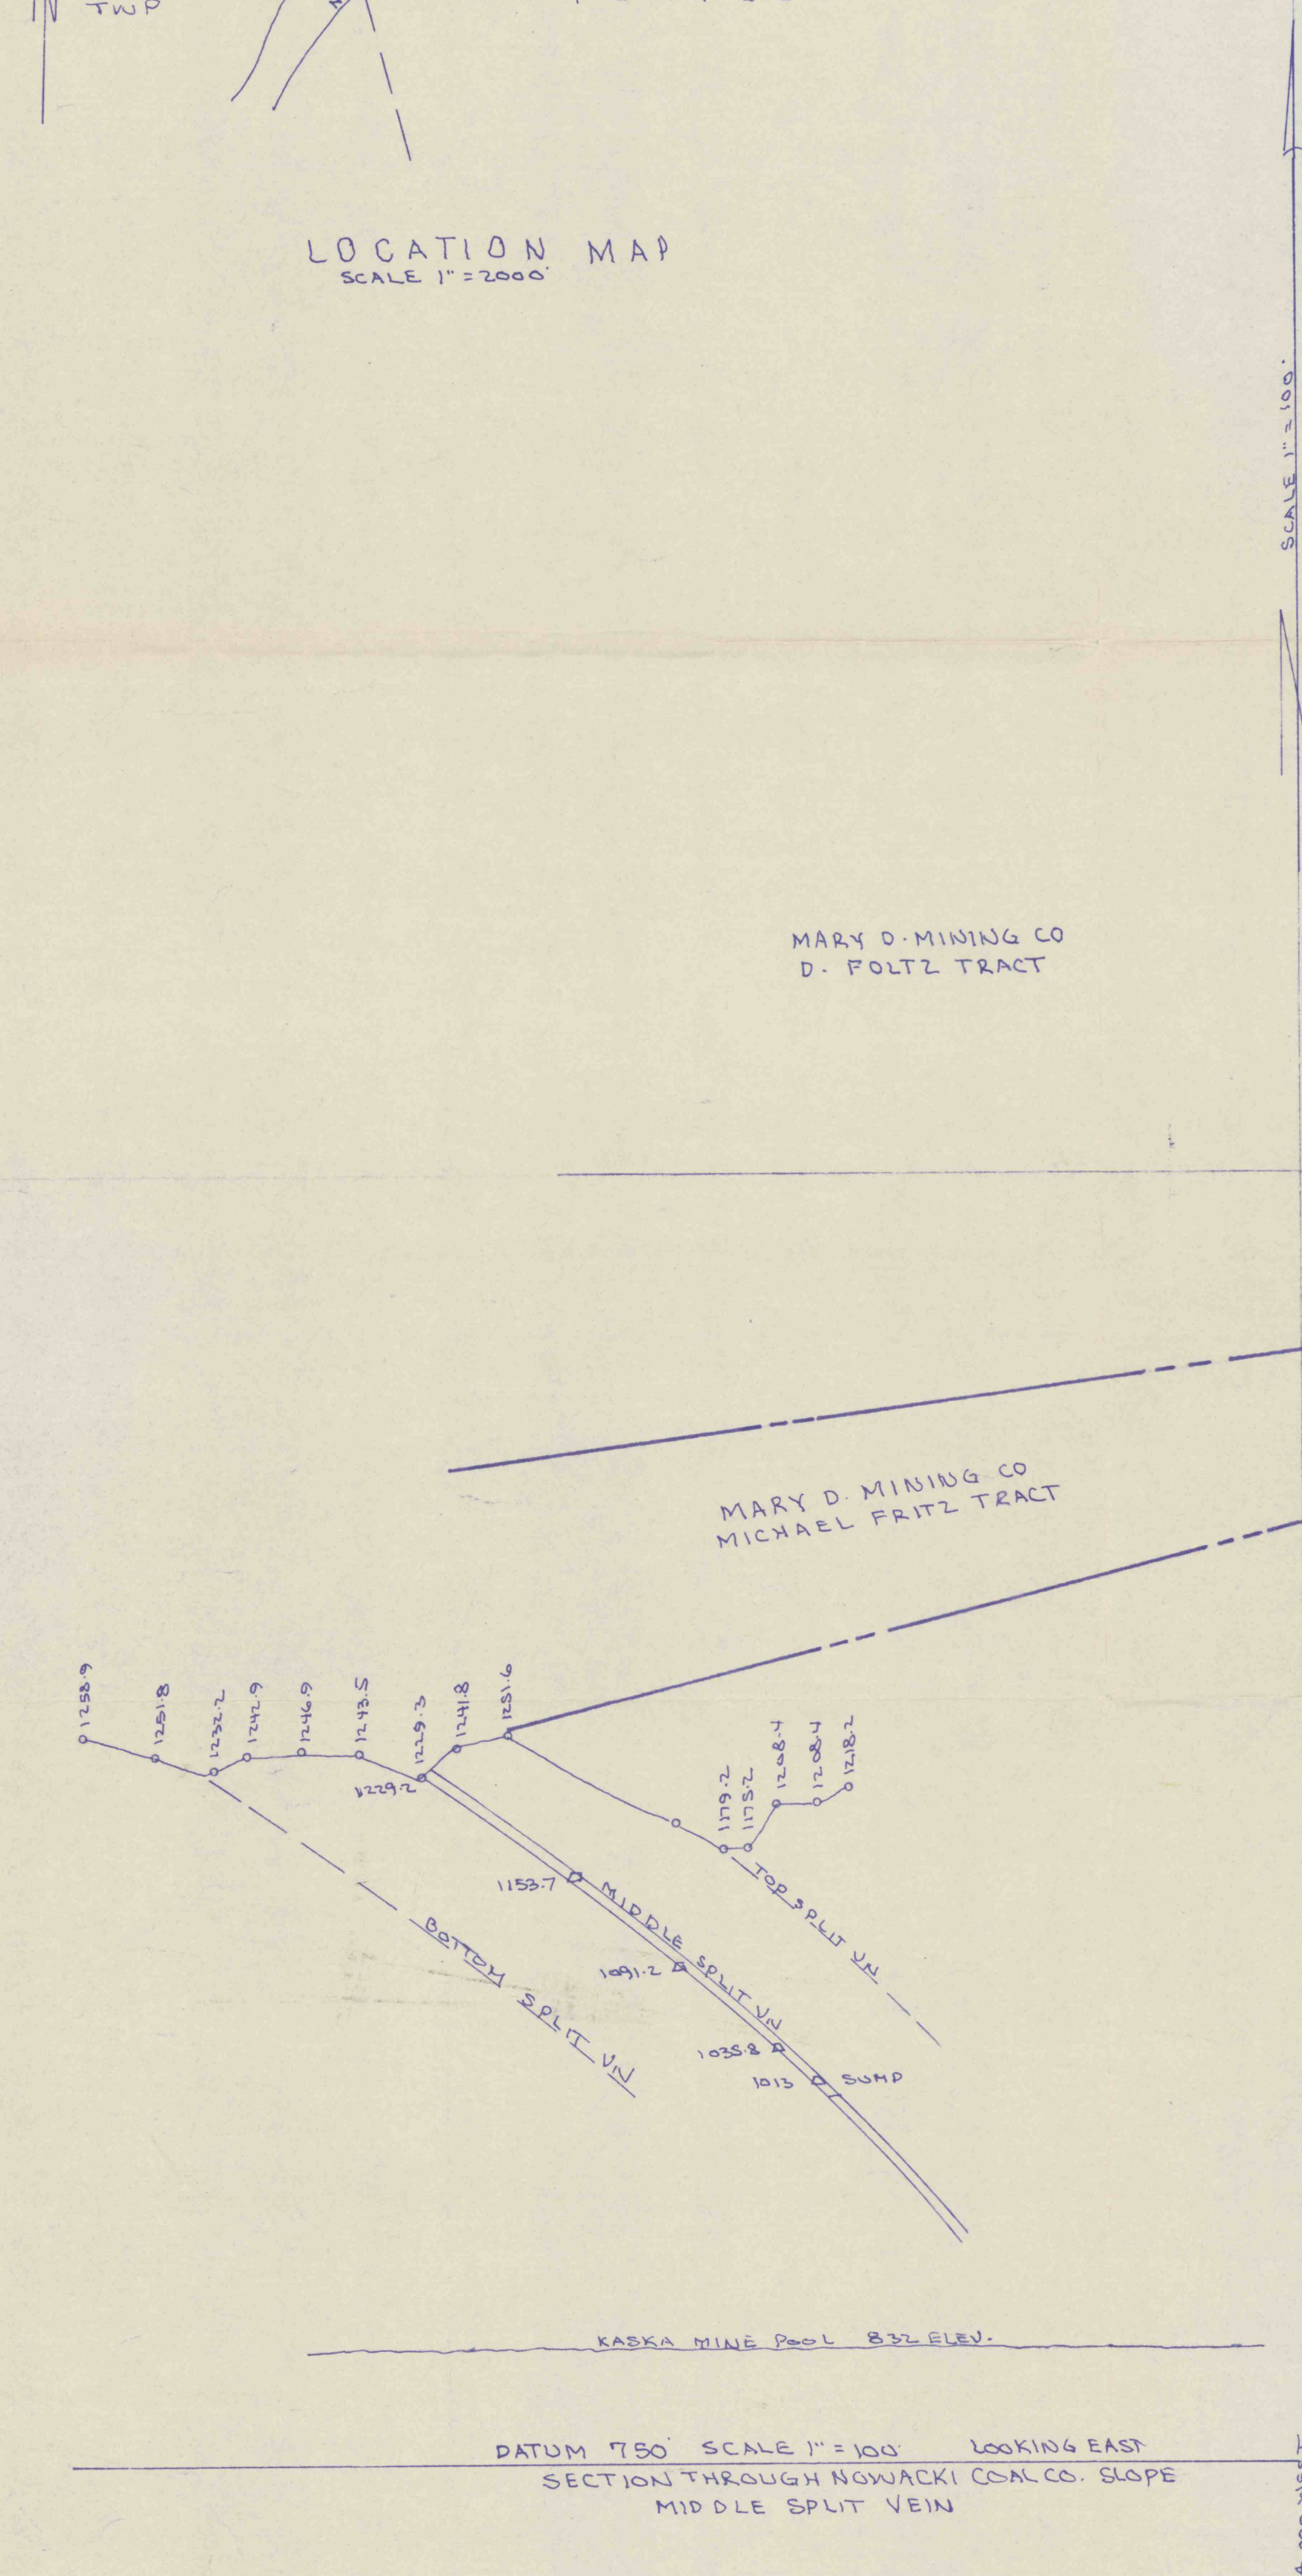


NOWACKI COAL COMPANY ID #36-07592
SCHUYLKILL & BLYTHE TWP. SCHUYLKILL CO.
NOTE: THERE IS NO KNOWN POOLED WATER ON THE SURFACE WITHIN THE MAPPED AREA.
THE SUB-SURFACE LEVELS ARE AT LOCATIONS & ELEVATIONS SHOWN
ON THE MAP. THERE ARE NO R.R. OR PAVED ROADS LEADING TO THE MINE. ACCESS
IS FROM A DIRT ROAD SHOWN ON THE MAP. PERMANENT BUILDINGS ON THE SITE
CONSIST OF THE HOIST HOUSE AND SURFACE FAN, AS SHOWN ON THE MAP.
SURFACE SURVEY TIE IN POINTS ARE SHOWN ON THE MAP.

AIR VOLUME
Q1 = 14000 CFM INTAKE FAN AT PORTAL
Q2 = 5400 CFM PILLAR-VEIN VENT IN GANGWAY
Q3 = 1500 CFM TO 1000 CFM (FACES)
Q4 = 5200 CFM LAST OPEN X-CUT WAY
Q5 = 6800 CFM OVERCAST
Q6 = 22000 CFM - FAN EXHAUSTING
Q7 = 5800 CFM - FACE EAST GWT.


MARY D. MINING CO.
MARY METZ TRACT

FAN - AMERICAN STANDARD
SINGOCO FAN DIE 210
SERIAL # 210-1

MARY D. MINING CO.
MARY METZ TRACT

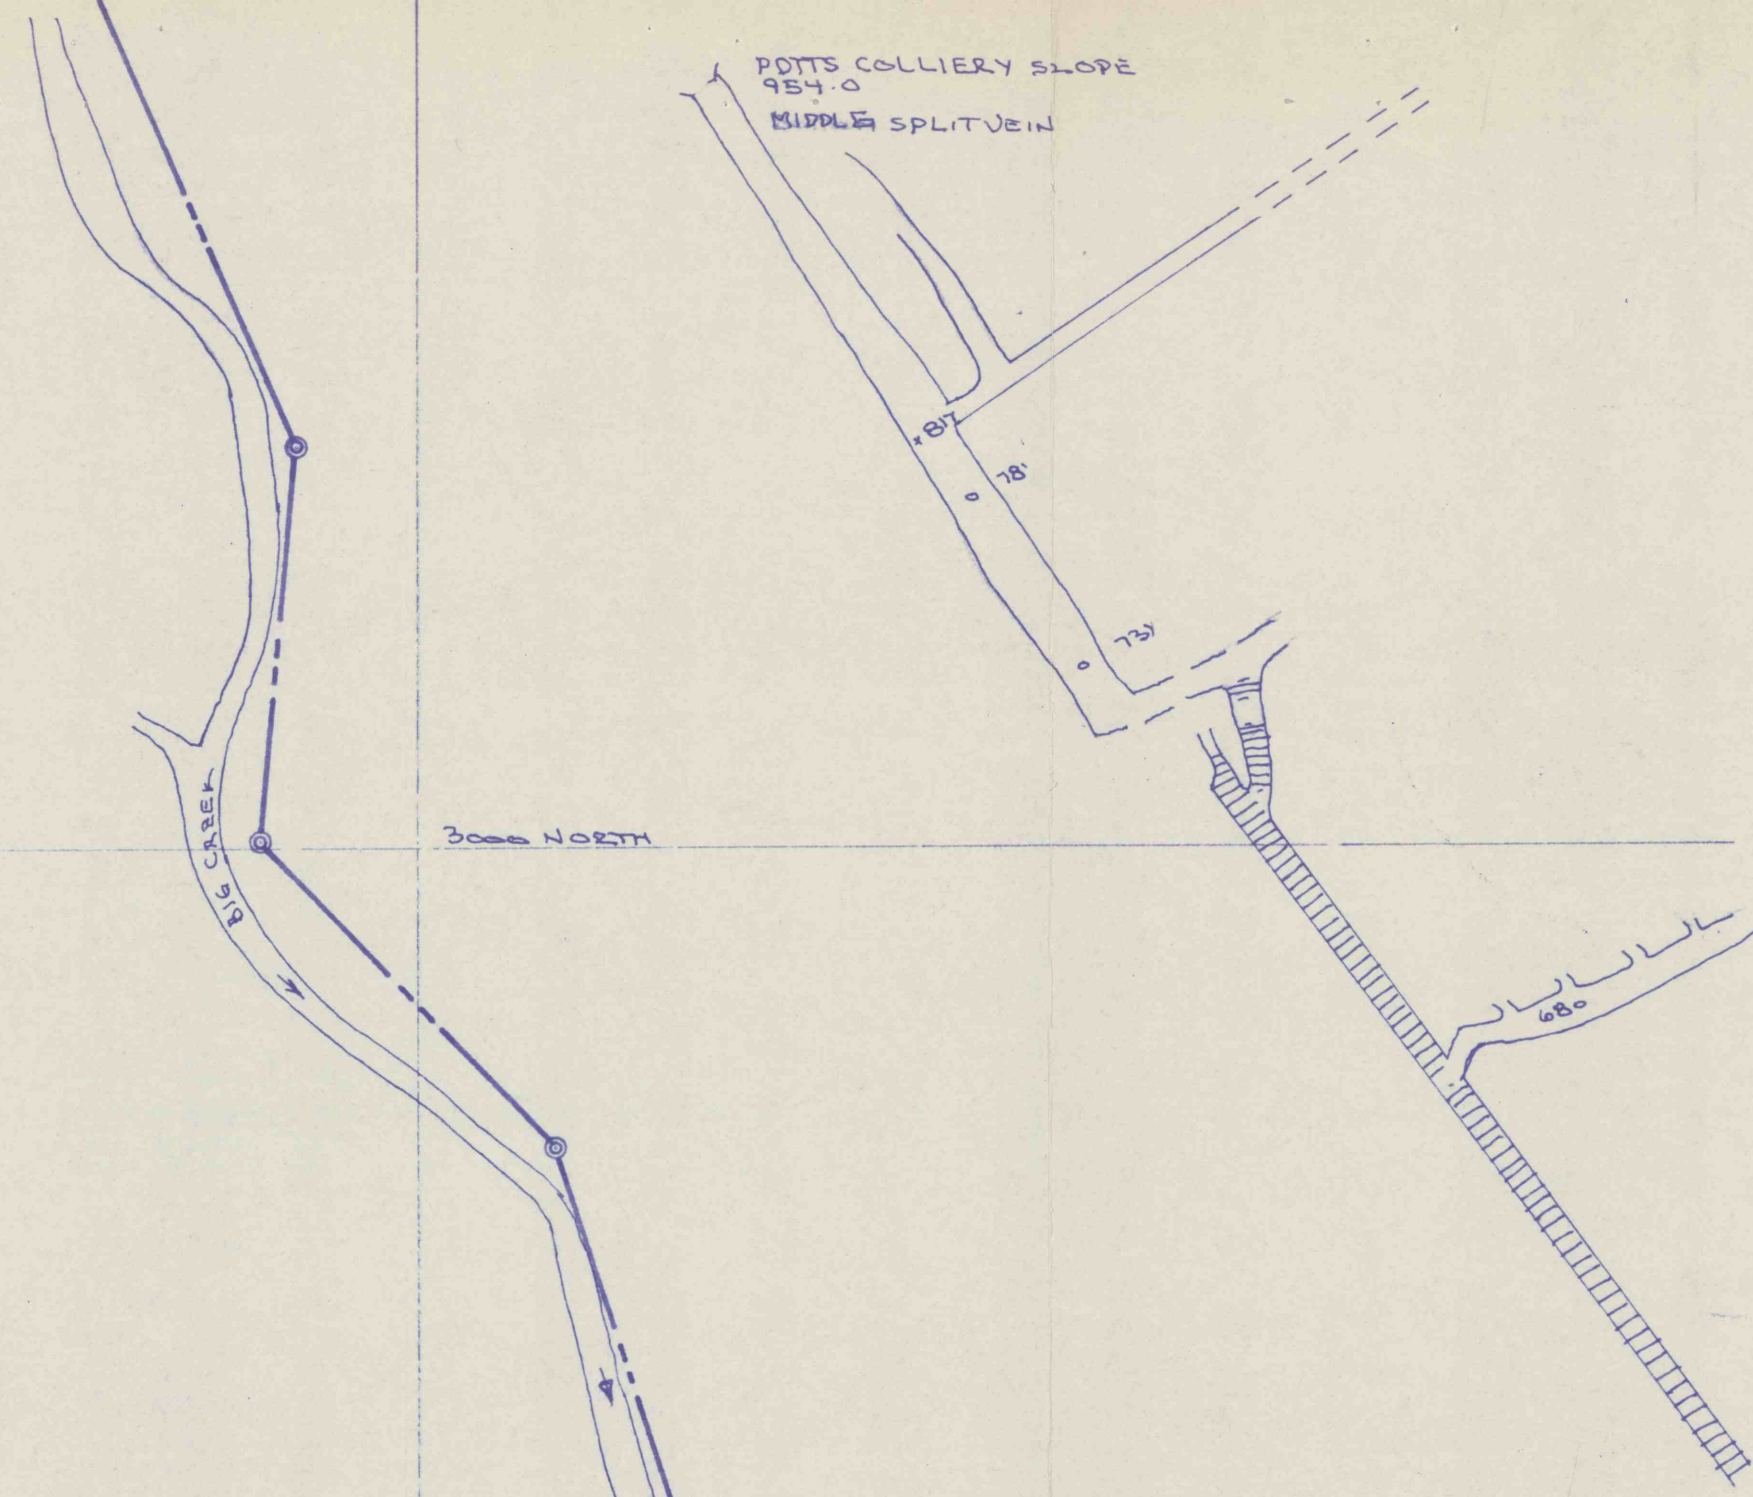

MARY D. MINING CO.
MARY METZ TRACT

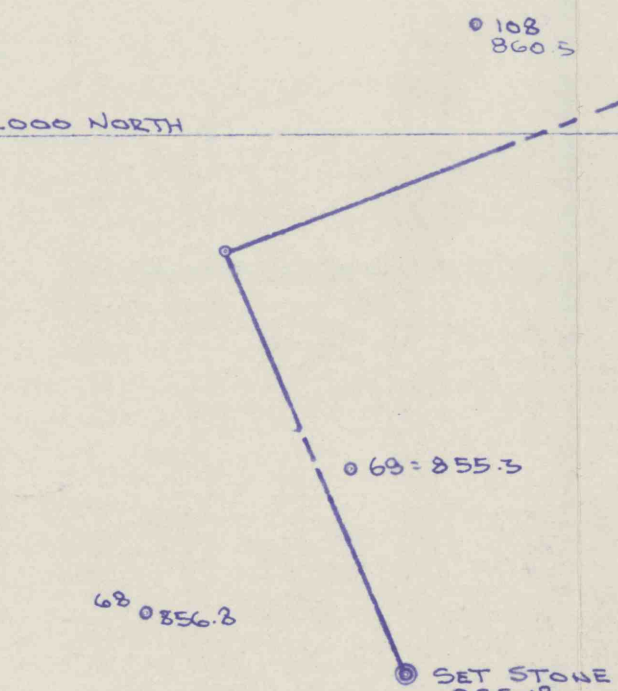

LEGEND
DOOR = D
STOPPING = ||
OVERCAST = ||
BRATTIC = ||
DIRECTION OF AIR -> INTAKE
REGULATOR - R
CURTAIN OR CHECK - C
FAN - 27 CENTRIFUGAL SINGOCO FAN
F = 22,000 CFM
ESCAPE WAY - E
BONDED SURFACE AREA
PROPOSED NEW WORKINGS - - -



COUNTY LEASE NO. 7A
NOWACKI COAL COMPANY
SITUATE IN SCHUYLKILL & BLYTHE TWP.
SCHUYLKILL CO., PA.
EXAMINED MARCH 28, 1991 SCALE 1"=100'
WALTER J. MARSHALL R.S. 18147086 PL 1198K
MINE I.D. # 36-07592

MIDDLE SPLIT ON WORKINGS OF NOWACKI SHOWN IN YELLOW
PROPOSED NEW WORKINGS SHOWN IN BROWN
BRADISH CLOTH SHOWN IN RED
ELEVATION BASE FROM SET STONE BY HUDSON
COAL CO. SITUATE AT THE SOUTH WEST CORNER
OF THE ADAM STAHL TRACT.

Nowacki Coal Company
Nowacki Coal Company
36-07592

RECEIVED
JAN 13 1992
POTTSVILLE, PA.