


Mine Opening No 9
Mine Opening No 8
Pen No 8 Mine
Mine Opening No 7
Mine Opening 6th level 7th level 8th level
Mine Opening No 10
Power line from Power house to No 8 Mine
Mine Opening No 6
Mine Opening No 3
Mine Opening No 3
Store
Mine Opening No 1
Top of Plane
Bottom of Plane
Power House
Pump Ho. for Water Supply for boilers
Pump Ho.
Reservoir
Kettle C. C. Co. Railway
Lead Color: Solid Coal area
Black dotted: Pillars Standing area
Red lines: Pillars drawn area
Geological designation: 8 or Lower Kittanning, Average coal height: 60 inches

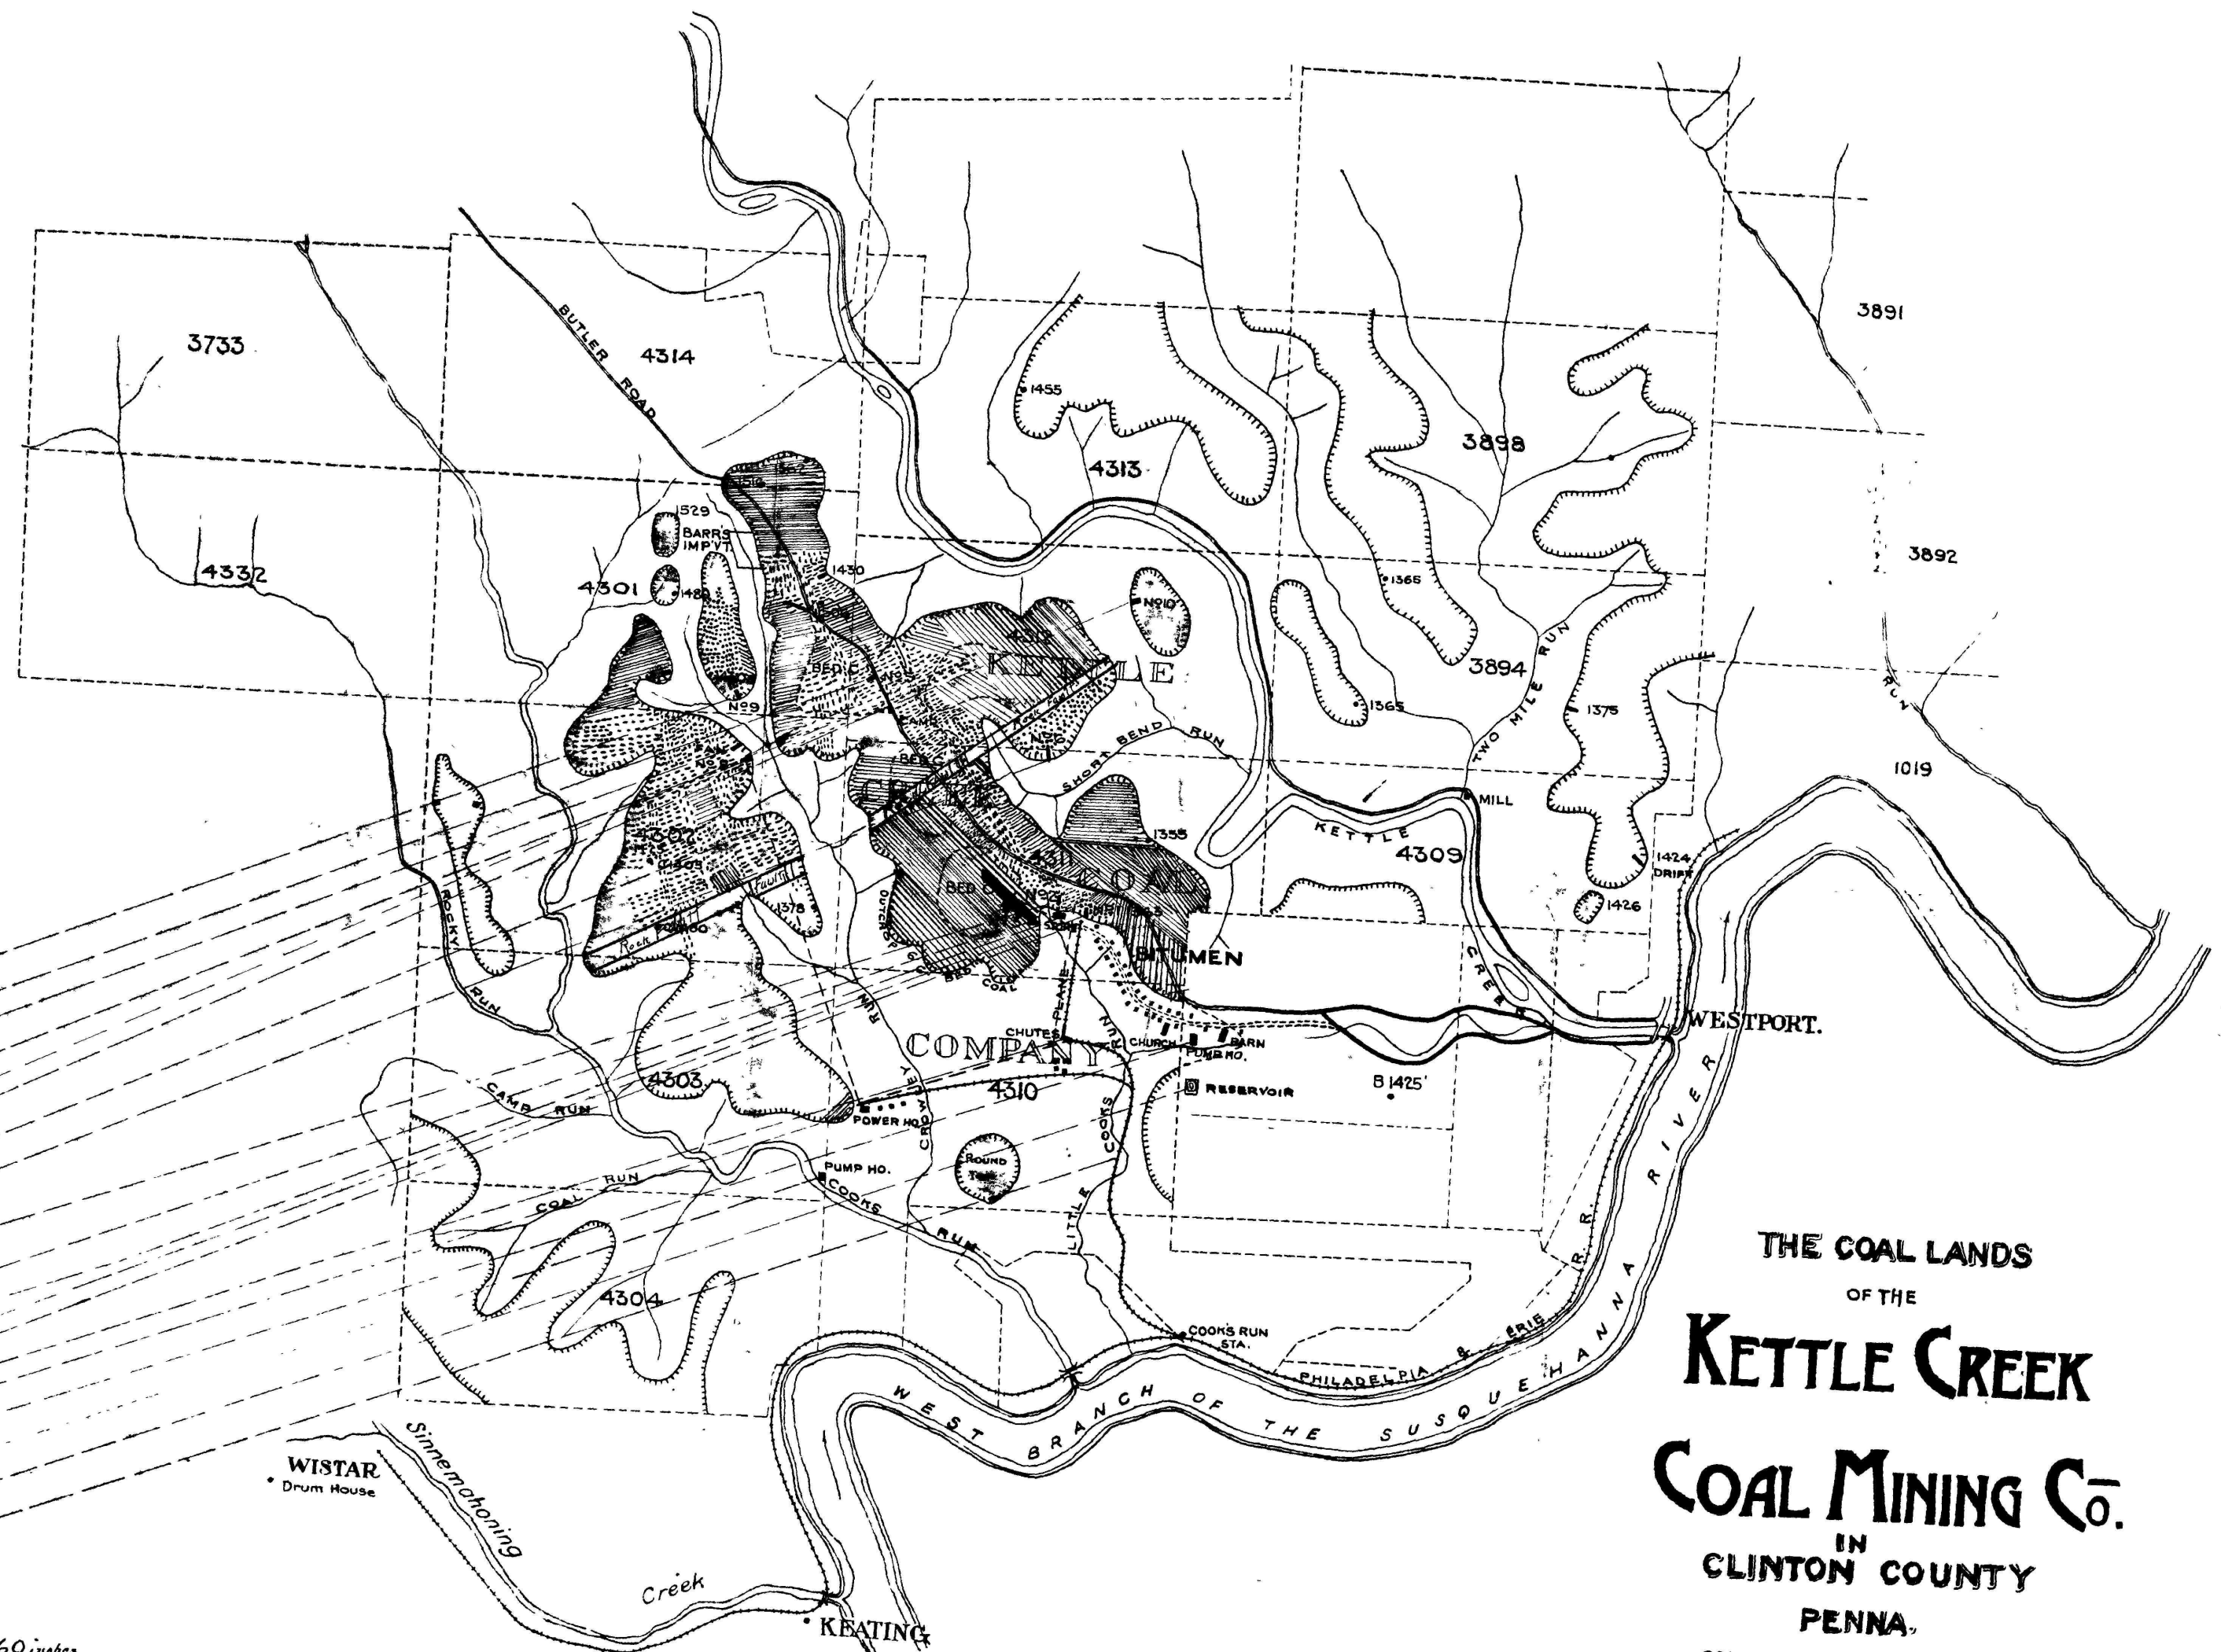

THE COAL LANDS
OF THE
KETTLE CREEK
COAL MINING CO.
IN
CLINTON COUNTY
PENNA.

SCALE: 150 RODS TO 1 INCH.
0 100 200 300 400 500 600 700 800 900 1000
1000 2000 3000 4000 5000 6000 7000 8000 9000 10000
1 MILE 2 MILES
FEET