



SECTION 1
Scale: 1 in. = 100 ft.

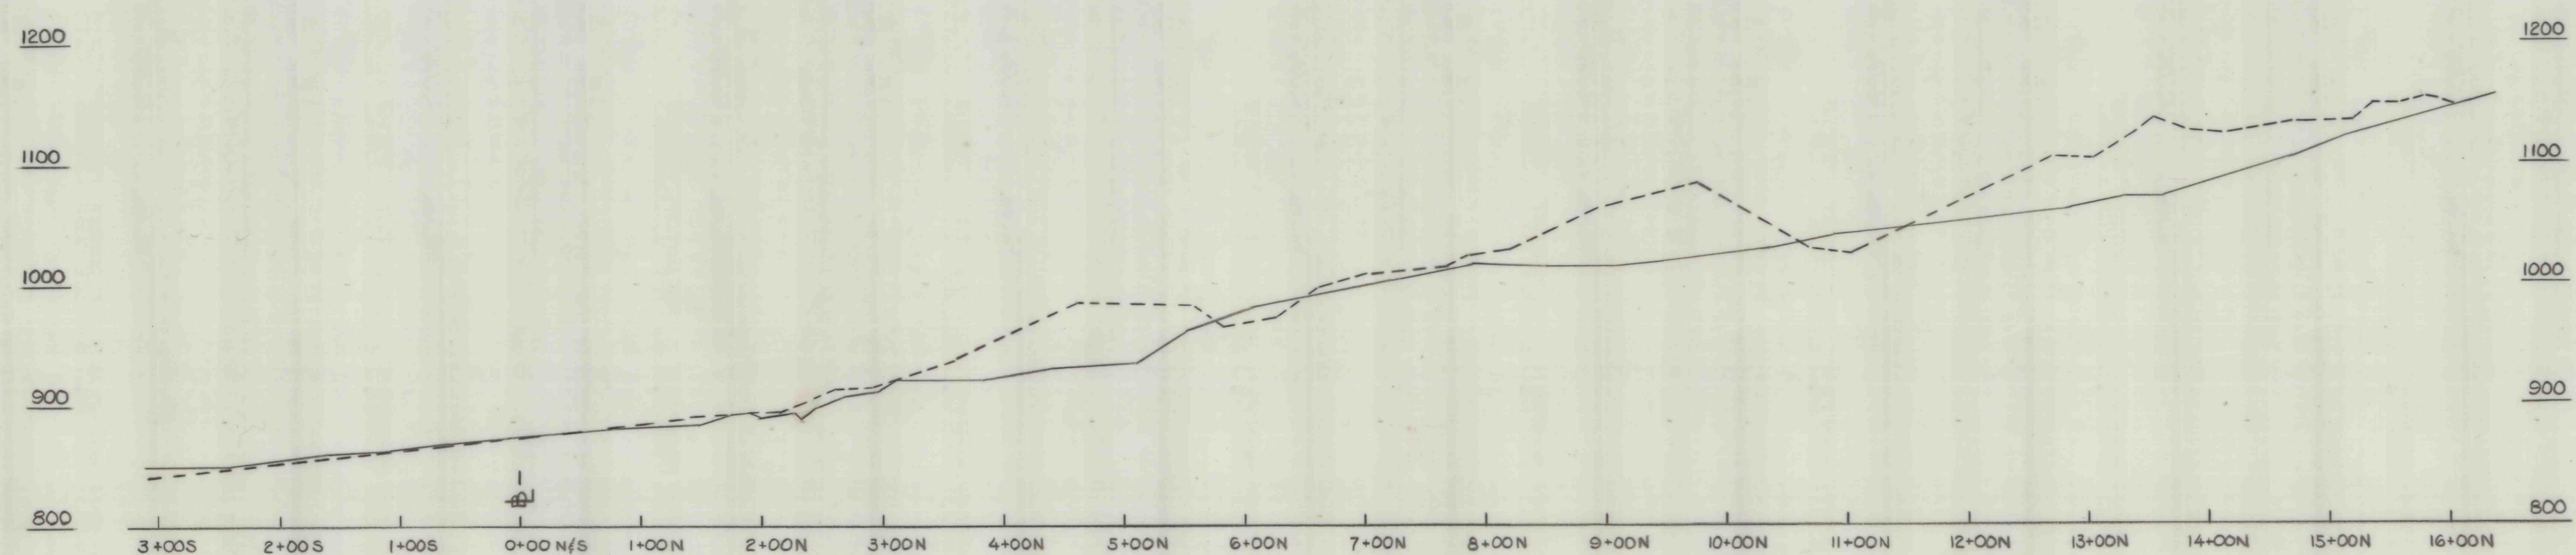

SECTION 2
Scale: 1 in. = 100 ft.

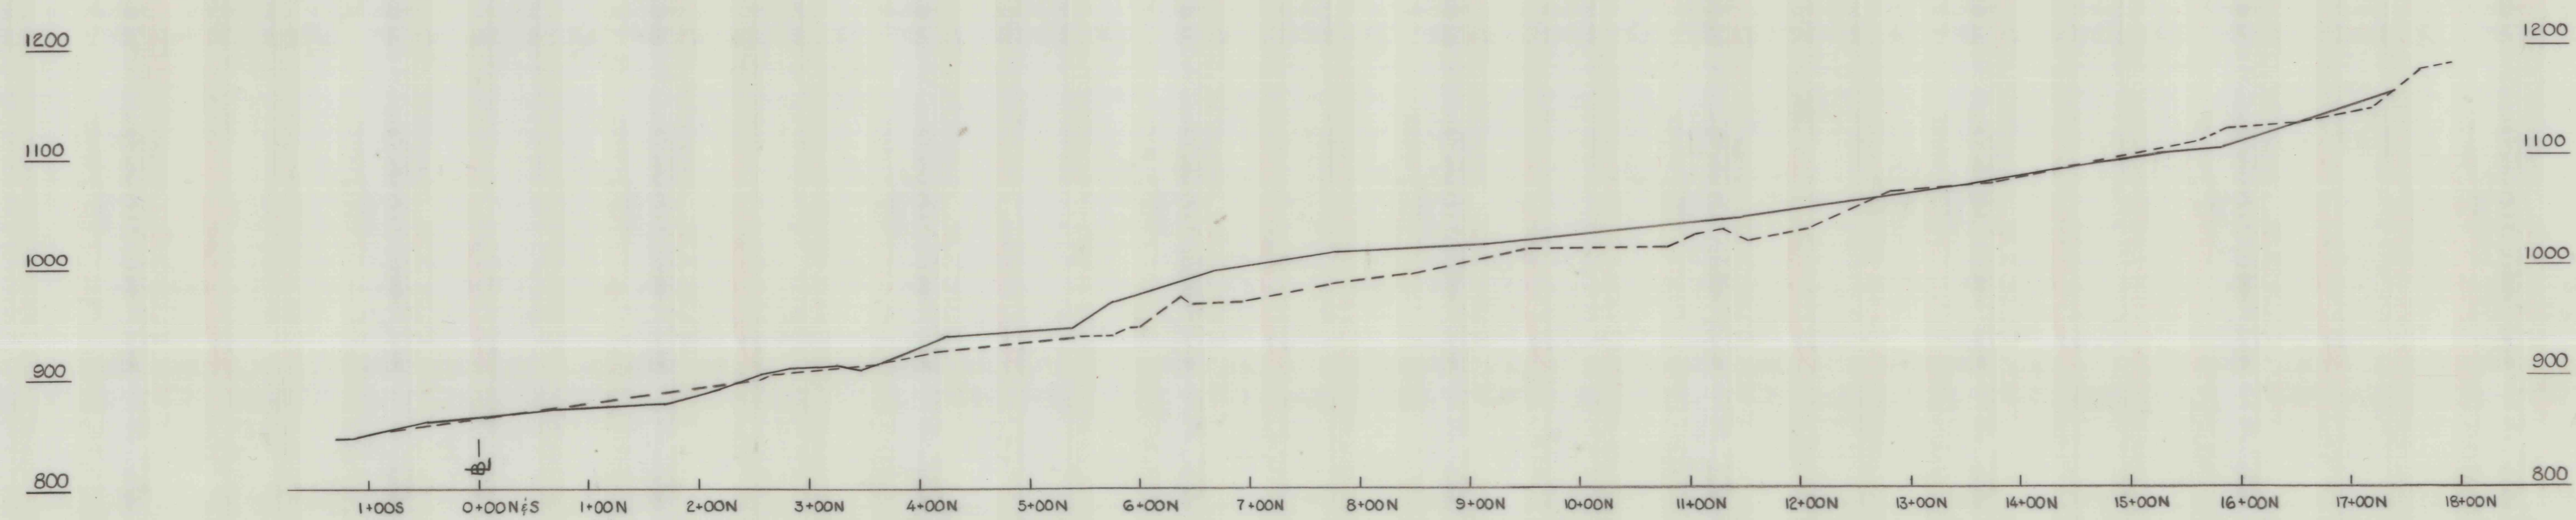


SECTION 3
Scale: 1 in. = 100 ft.

LEGEND
 - - - ORIGINAL SURFACE
 _____ FINAL GRADE (AS-BUILT)

NO.	DATE	REVISION	APPR.

SUBMITTED _____
 DESIGN ENGINEER
 APPROVED *M. Vaccino*
 DISTRICT ENGINEER
 APPROVED _____
 DIRECTOR - BUREAU OF DESIGN

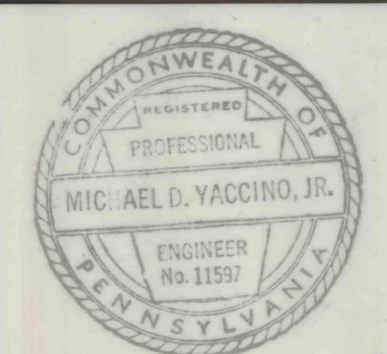

(SEALS)

COMMONWEALTH OF PENNSYLVANIA
 DEPARTMENT OF ENVIRONMENTAL RESOURCES
 OFFICE OF RESOURCES MANAGEMENT

CONTRACT NO. SL 211-A
 EXTINGUISHMENT OF BURNING COAL
 REFUSE BANK AT WILLIAMSTOWN
 WILLIAMS TOWNSHIP, DAUPHIN COUNTY
 PENNSYLVANIA

CROSS SECTIONS

DRAWN BY MRF	DATE 26 JAN 78	DRAWING NO. 4 of 5
CHECKED BY	SCALE 1" = 100'	