

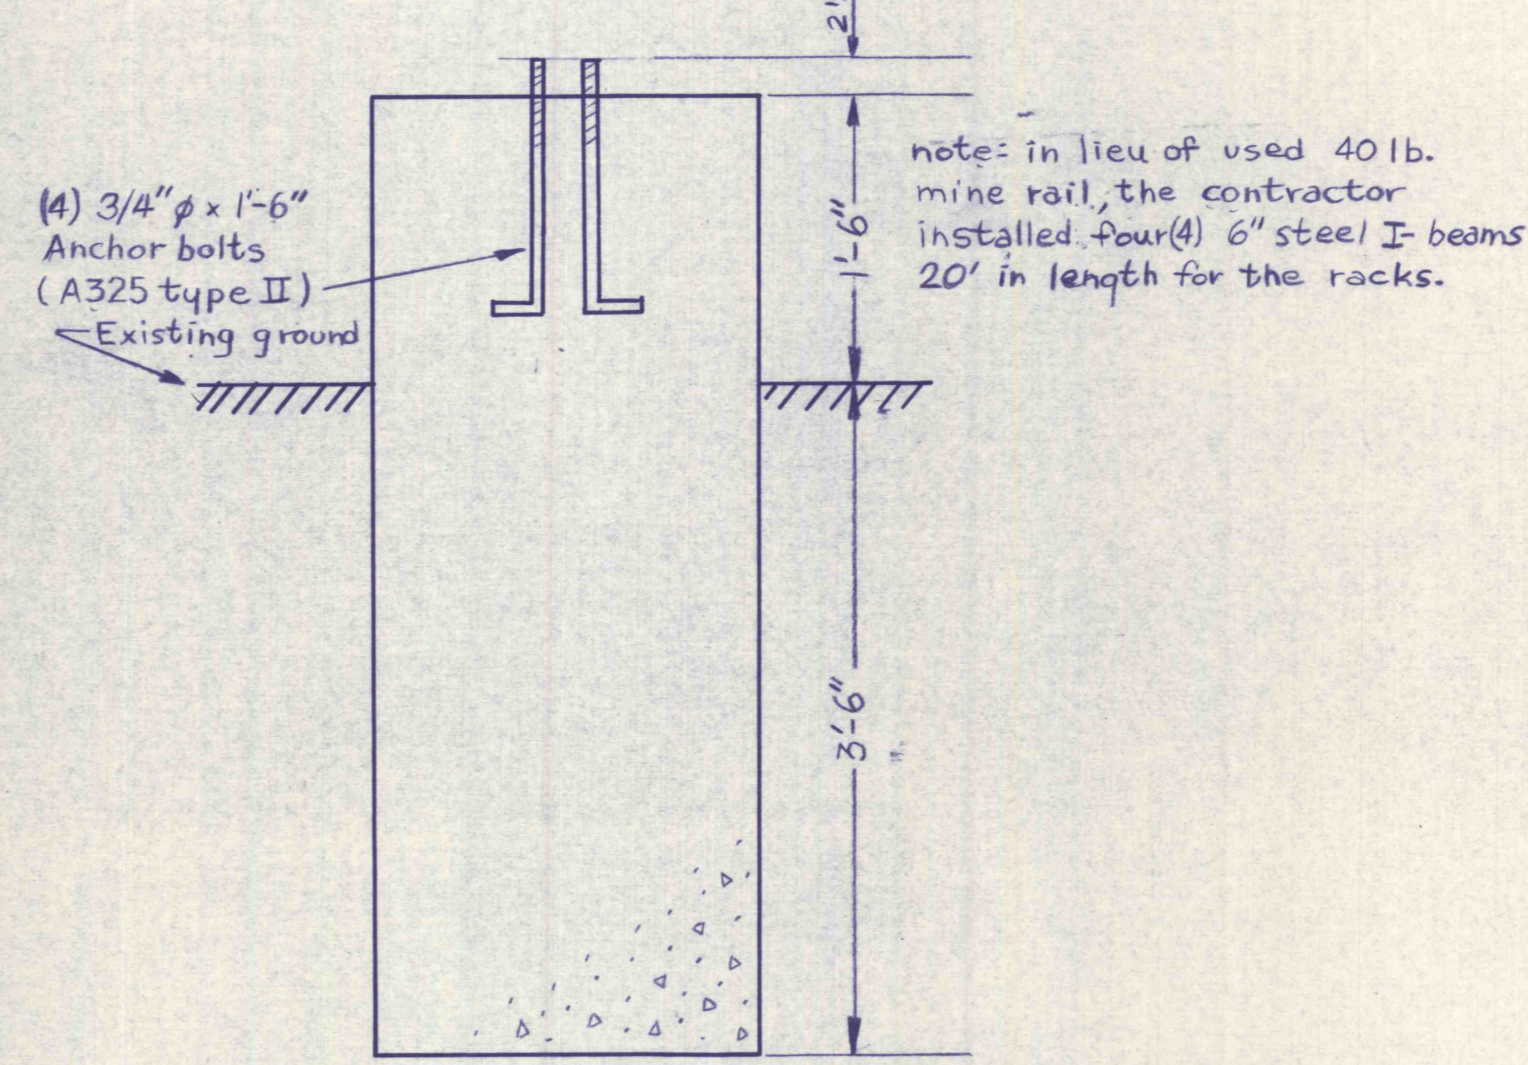
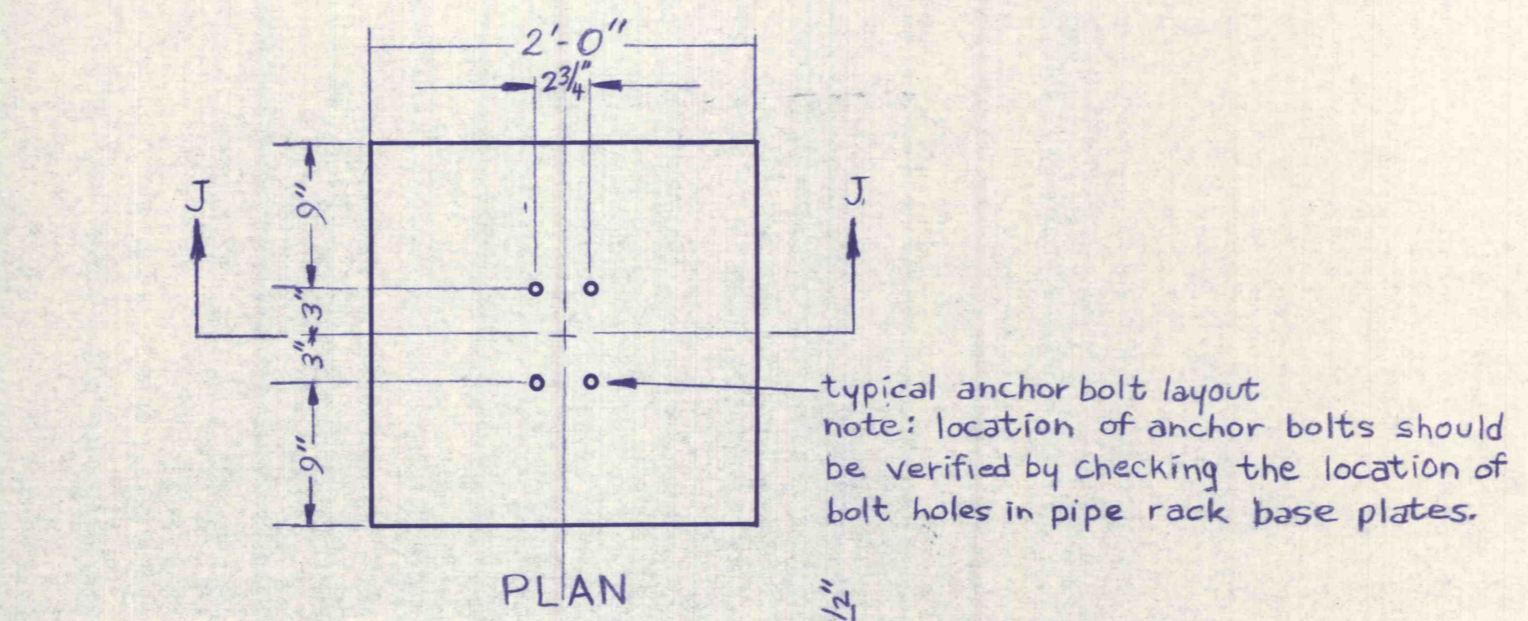


DISCHARGE PIPE SUPPORT
 Scale 1" = 1'-0"


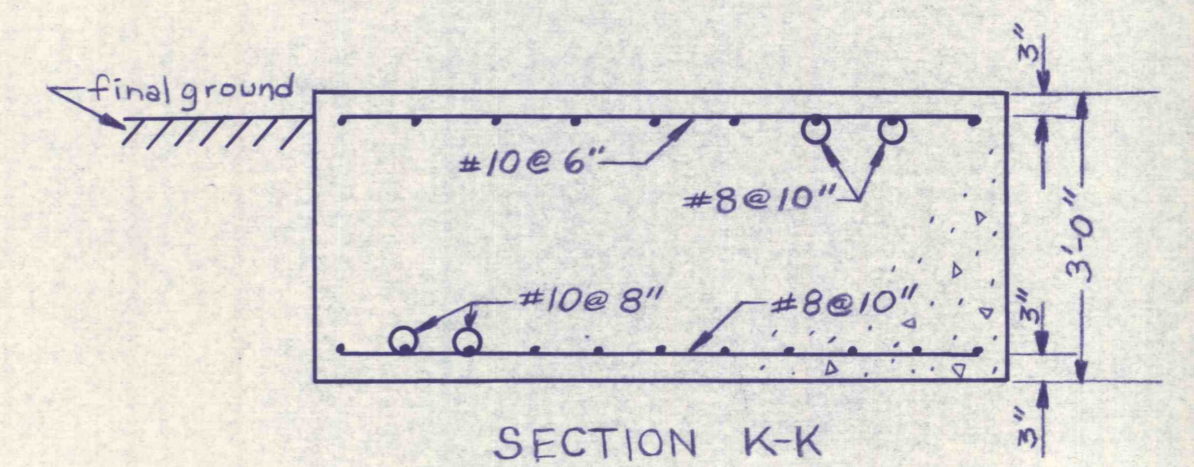


PIPE STORAGE RACK PIER
 Scale 1" = 1'-0"


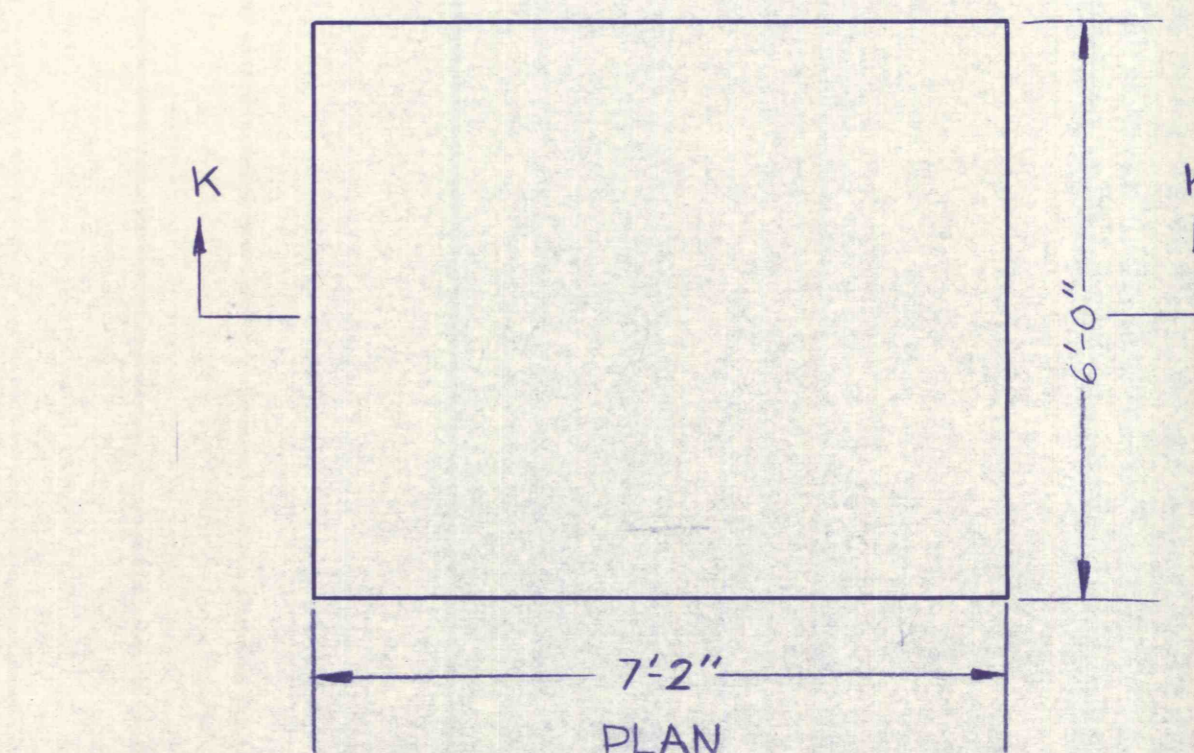


TRANSFORMER FOUNDATION
 Scale 1" = 2'-0"

NOTE: FOR ORIGINAL DESIGN OF THE DISCHARGE PIPE SUPPORTS, PIPE STORAGE RACK PIERS, TRANSFORMER & LINE STARTER FOUNDATIONS SEE ADDENDUM NO. 3 TO THE BID DOCUMENTS AND BID FORM. THE OIL SWITCH FOUNDATION WAS ADDED DURING CONSTRUCTION.

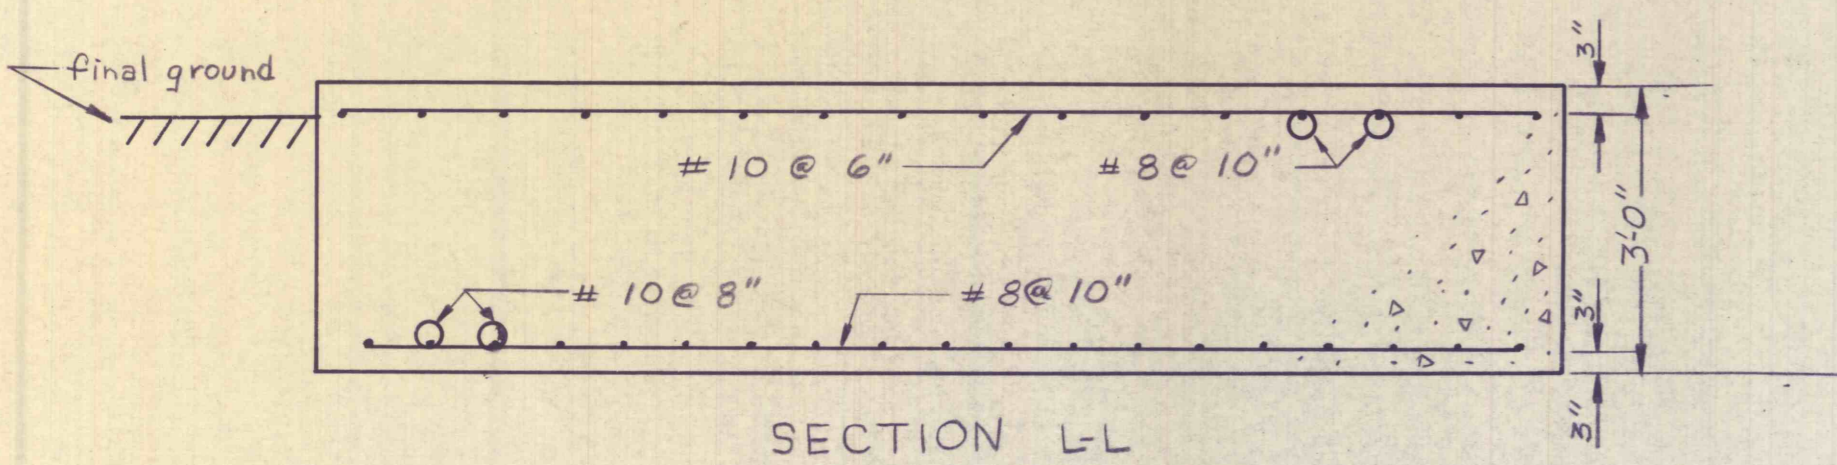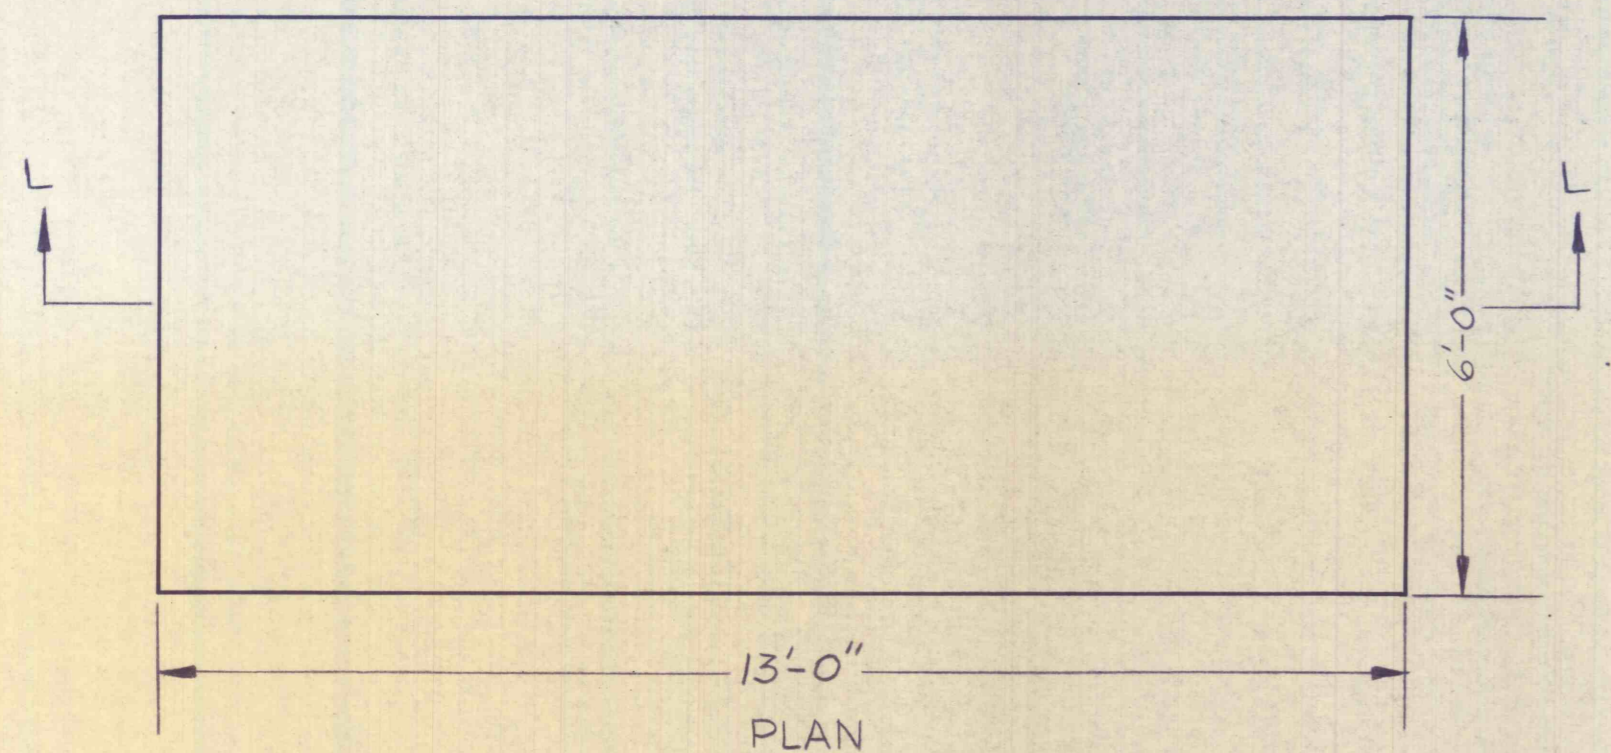

LINE STARTER FOUNDATION
 Scale 1" = 2'-0"

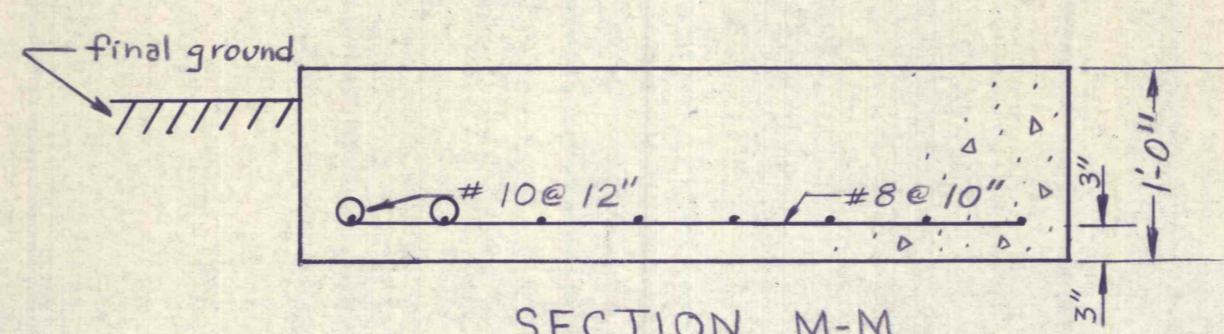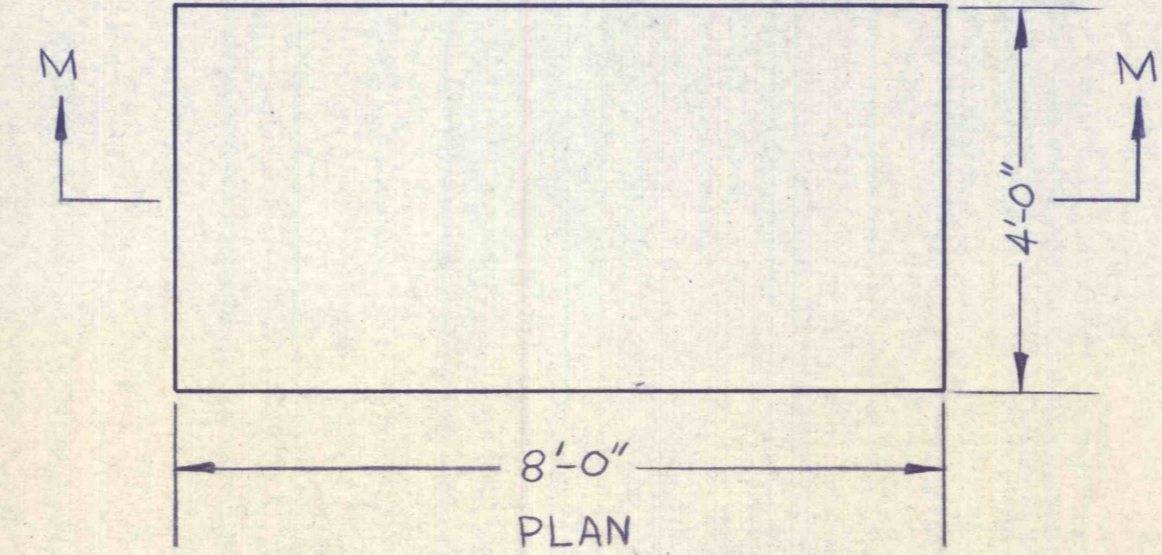

OIL SWITCH FOUNDATION
 Scale 1" = 2'-0"

NO.	DATE	REVISION	APPR.
7-6-79	AS BUILT.		MJ
SUBMITTED <i>M. Gerke</i> DESIGN ENGINEER			
APPROVED <i>M. Yacino</i> DISTRICT ENGINEER			
APPROVED _____ DIRECTOR - BUREAU OF OPERATIONS			
COMMONWEALTH OF PENNSYLVANIA DEPARTMENT OF ENVIRONMENTAL RESOURCES OFFICE OF RESOURCES MANAGEMENT			
PROJECT NO. MWC-48			
BOREHOLE CONSTRUCTION AND DEEP-WELL PUMP INSTALLATION NEAR VALLEY VIEW			
SCHUYLKILL CO. PENNSYLVANIA			
PLANS, SECTIONS AND DETAILS			
DRAWN BY	DATE	DRAWING NO.	
SGH	6 JULY 79	5 of 5	
CHECKED BY	SCALE		
MRF	1" = 5'		