

AS BUILT  
AUGUST 28, 1979

①	8-28-79	changes to type 1 seeding	M.K.
②	8-28-79	changes to type 2 seeding	M.K.
③	8-28-79	changes to roadway	M.K.
NO.	DATE	REVISION	APPR.


SUBMITTED	<i>Richard Barron</i>
PROJECT ENGINEER	
APPROVED	<i>[Signature]</i>
DIRECTOR - BUREAU OF OPERATIONS	
APPROVED	<i>Chana Connell</i>
DEPUTY SECRETARY - RESOURCES MANAGEMENT	



PROJECT NO. SL 112-IIC-78  
**SLUDGE DISPOSAL, ROAD RECONSTRUCTION AND GRASS SEEDING OF RAUSCH CREEK ACID MINE DRAINAGE TREATMENT PLANT**  
 SCHUYLKILL CO. PENNSYLVANIA  
 COMMONWEALTH OF PENNSYLVANIA  
 DEPARTMENT OF ENVIRONMENTAL RESOURCES

**PLAN, LOCATION AND VICINITY MAPS**

DRAWN BY	DATE	DRAWING NO.
Checked by	AUG. 28, 1978	1 of 1
CHECKED BY	SCALE	
	AS SHOWN	

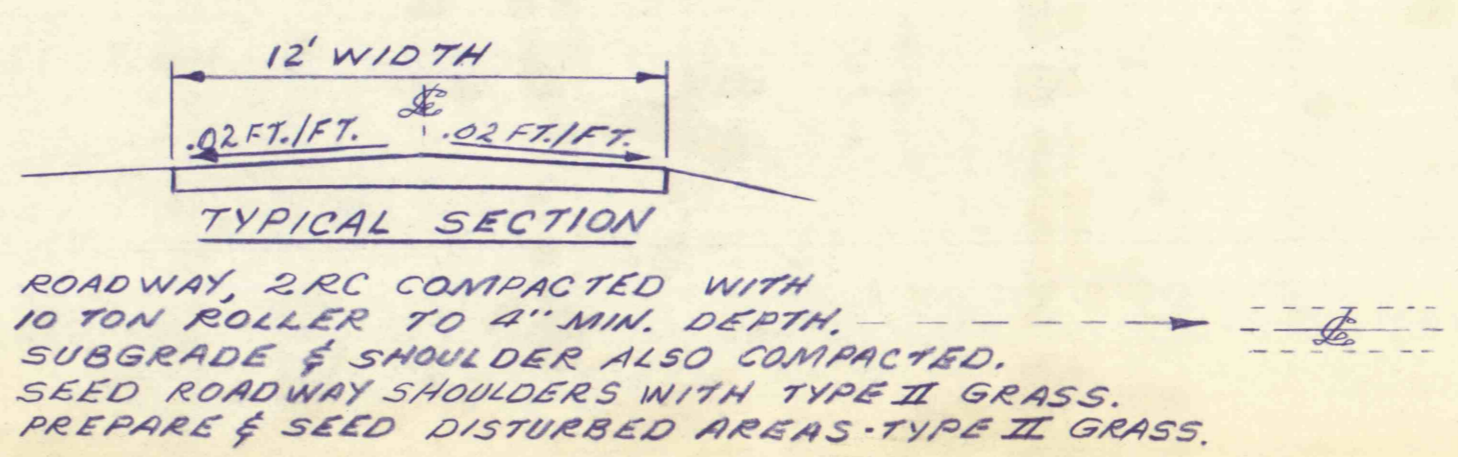

ALL DIMENSIONS AND EXISTING CONDITIONS SHALL BE CHECKED AND VERIFIED BY CONTRACTOR AT THE SITE