


KEY PLAN
NO SCALE

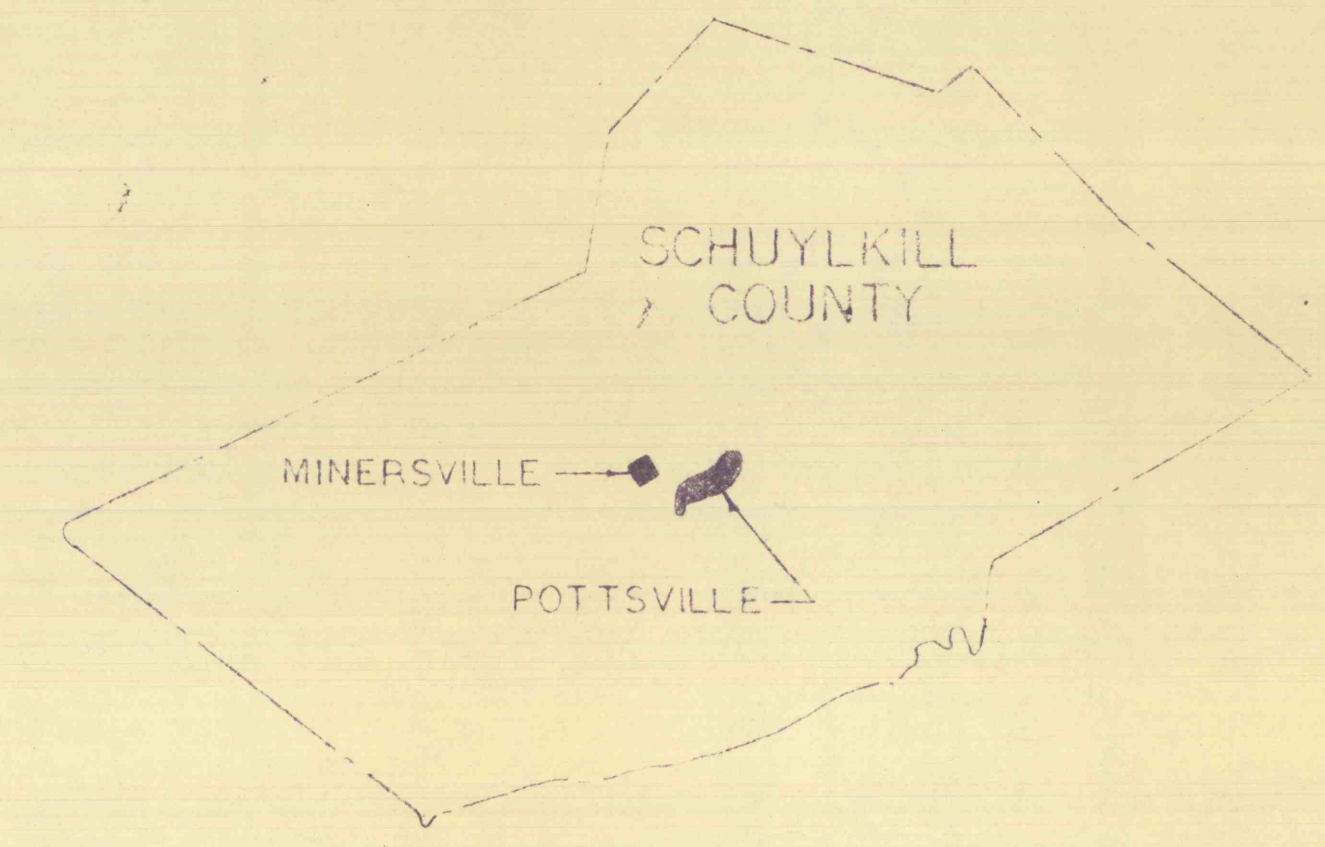

LOCATION PLAN
NO SCALE

- ACID LINE DRAINAGE
- RAW SEWAGE CONNECTION
PREVIOUSLY DISCHARGED INTO
COMMONWEALTH WATERS FOR ACT 330

LEGEND

- STANDARD MANHOLE
- DIVERSION MH LEAVING WEIR I-12, DETAIL NO. 4
- DIVERSION MH WEIR SEE I-13, DETAIL NO. 10
- DROP MANHOLE
- - - EXISTING SEWER PIPES AND CULVERTS
(SEE SHEETS I-2, I-6 FOR SIZES AND INV.)

| | |
|------|-------------------------------|
| 1-76 | AS BUILT |
| 1-74 | REVISED AREA 19 TEABERRY HILL |

| | | | |
|-------------------------------------|--|------------------|--|
| MINERSVILLE SEWER AUTHORITY | | PENNSYLVANIA | |
| MINERSVILLE BORO, SCHUYLKILL COUNTY | | DATE: 5-4-70 | |
| MINERSVILLE INTERCEPTOR SEWER | | SCALE: 1"=200' | |
| GENERAL PLAN | | DRAWN: M.G. | |
| | | APPROVED: T.H.R. | |
| | | DRAWING NO. | |

AS BUILT

PE PENNEAST CORPORATION
CONSULTING ENGINEERS
POTTSVILLE - TAMAQUA, PENNSYLVANIA

I-1R