


SEE SHEET NO. 7

SEE SHEET NO. 9

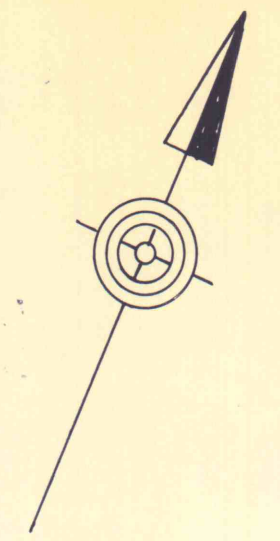


⚠ All work on this Drawing terminated at owners request after initial grading was completed.
 Deleted Items:
 3500 L.F. 2' Bot. Ditch
 66 L.F. 24" BOLLGM Pipe
 572 S.Y. Rip Rap
 2915 S.Y. Jute Matting
 1 Ea. Conc Endwall
 100% Revegetation

SEE SHEET NO. 13

For Grading sections See Sheet No. 37

| | | | |
|---|---------|----------|-------|
| NO | DATE | REVISION | APPR. |
| 1 | 1/13/77 | AS BUILT | |
| SUBMITTED <u>Norman E. Hutchler</u> | | | |
| APPROVED <u>Robert A. Ramey</u> CHIEF - DIVISION OF MINE DRAINAGE REHABILITATION | | | |
| APPROVED <u>W. Pennington</u> DIRECTOR - BUREAU OF CONSULTING SERVICES | | | |

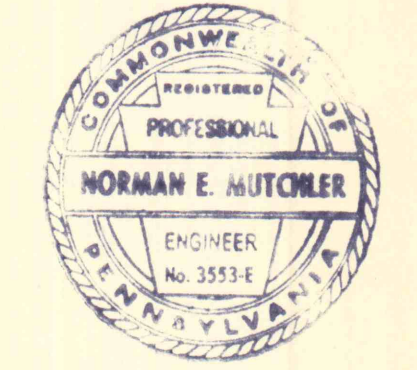

COMMONWEALTH OF PENNSYLVANIA
DEPARTMENT OF ENVIRONMENTAL RESOURCES
OFFICE OF ENGINEERING AND CONSTRUCTION

PROJECT NO. SL-126-2-7

MINE DRAINAGE
POLLUTION ABATEMENT
SWATARA CREEK WATERSHED
SCHUYLKILL COUNTY

BERGER ASSOCIATES, INC.
Consulting Engineers

P.O. Box 1943 Harrisburg, Penna.

PLAN STRIP MINE RECLAMATION

| | | |
|--------------------|-----------------------|-------------------------|
| DRAWN BY W.G. | DATE APR. 17, 1973 | DRAWING NO. 14 of 43 |
| CHECKED BY T.T. | SCALE 1" = 100' | |