



SEE SHEET NO. 13

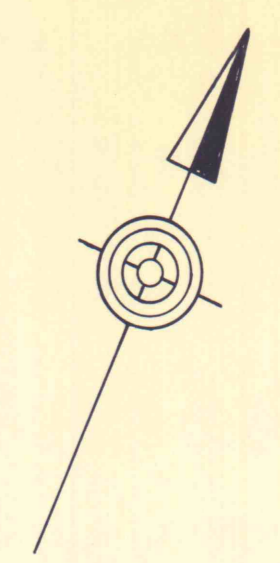

NO.	DATE	REVISION	APPR.
1	4-13-77	AS BUILT	

SUBMITTED
Norman E. Hatcher
 PROFESSIONAL
 APPROVED
Albert A. Ranier
 CHIEF - DIVISION OF MINE DRAINAGE REHABILITATION
 APPROVED
Suberigo
 DIRECTOR - BUREAU OF CONSULTING SERVICES

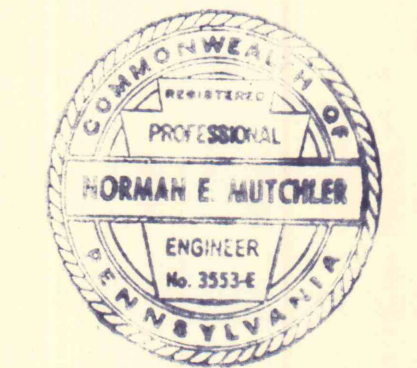

COMMONWEALTH OF PENNSYLVANIA
 DEPARTMENT OF ENVIRONMENTAL RESOURCES
 OFFICE OF ENGINEERING AND CONSTRUCTION

PROJECT NO. SL-126-2-7
 MINE DRAINAGE
 POLLUTION ABATEMENT
 SWATARA CREEK WATERSHED
 SCHUYLKILL COUNTY
 BERGER ASSOCIATES, INC.
 Consulting Engineers
 P.O. Box 1943 Harrisburg, Penna.

**SITE PLAN
 MIDDLE CREEK**

DRAWN BY W. G.	DATE APR. 17, 1973	DRAWING NO. 15 of 43
CHECKED BY T. T.	SCALE 1" = 100'	

Note:
 This Plan Indicates the Access Roads
 to the Proposed Middle Creek Channel
 Lining. For Detailed Plan of this work
 See Sheet No. 16.