
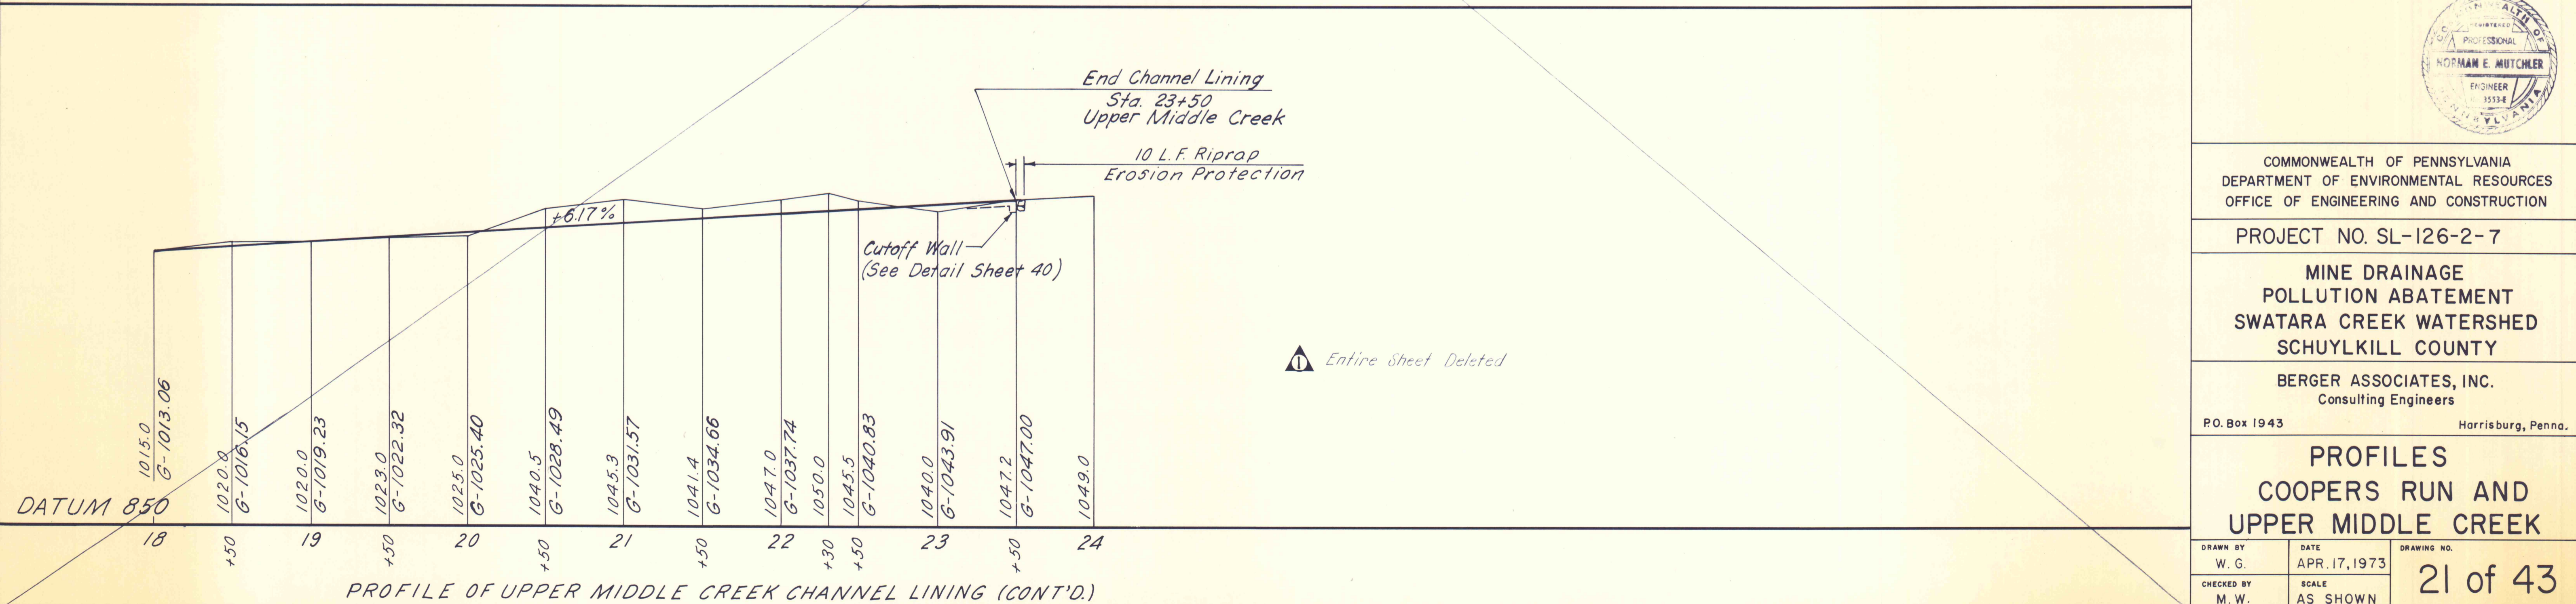
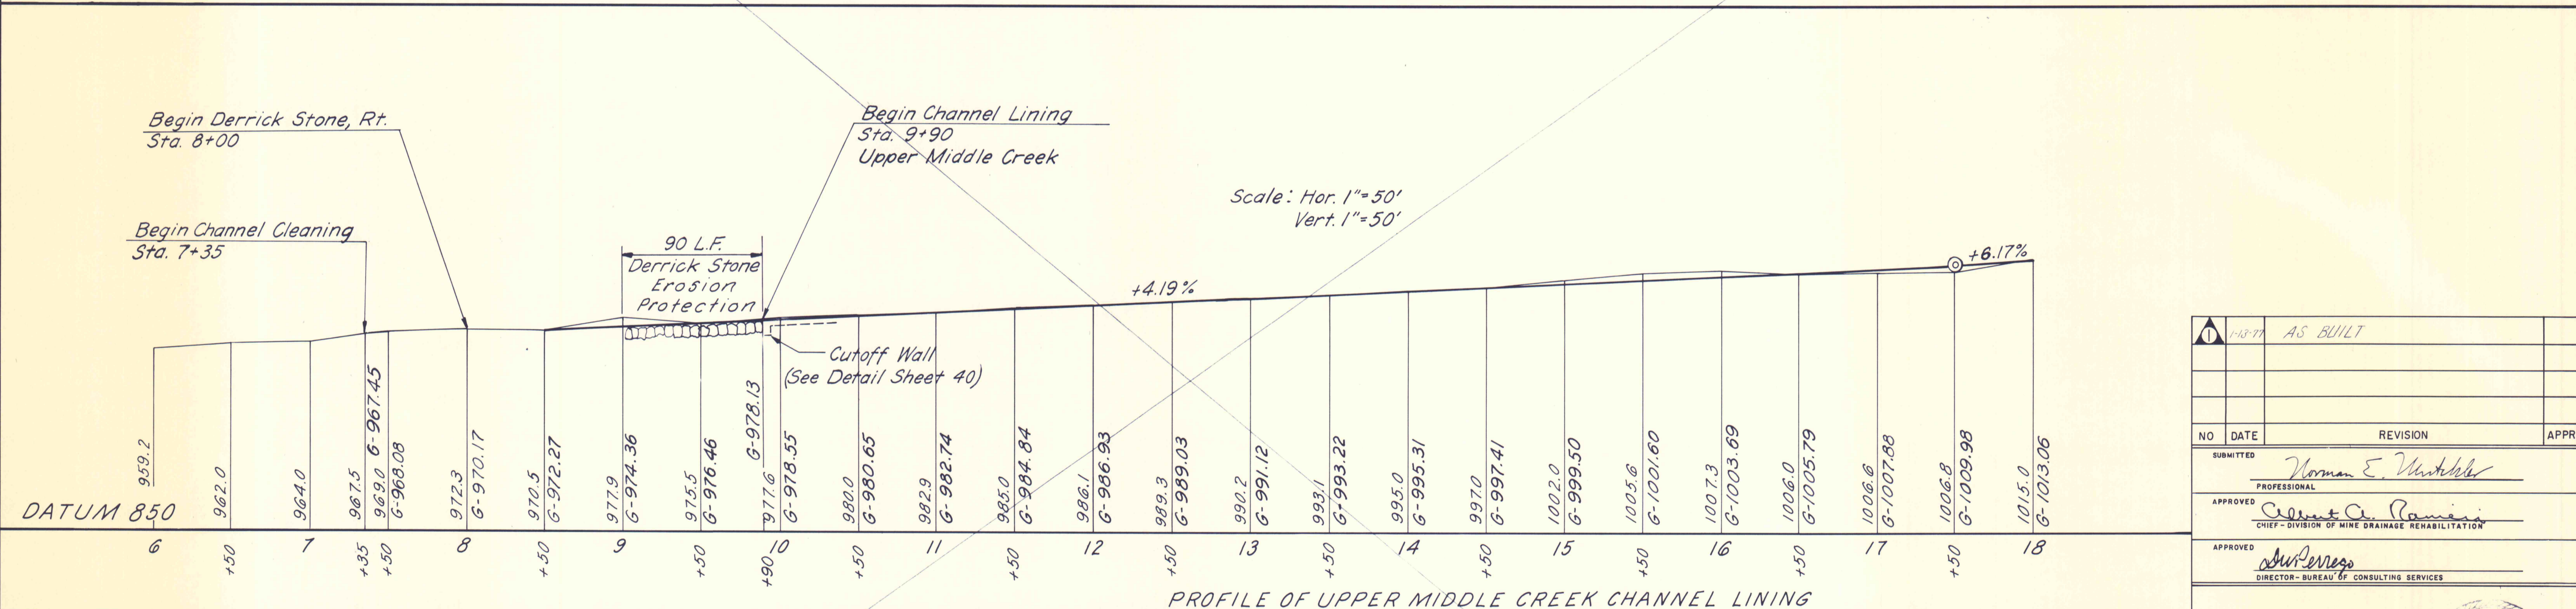


Scale: Hor. 1" = 50'
Vert. 1" = 50'

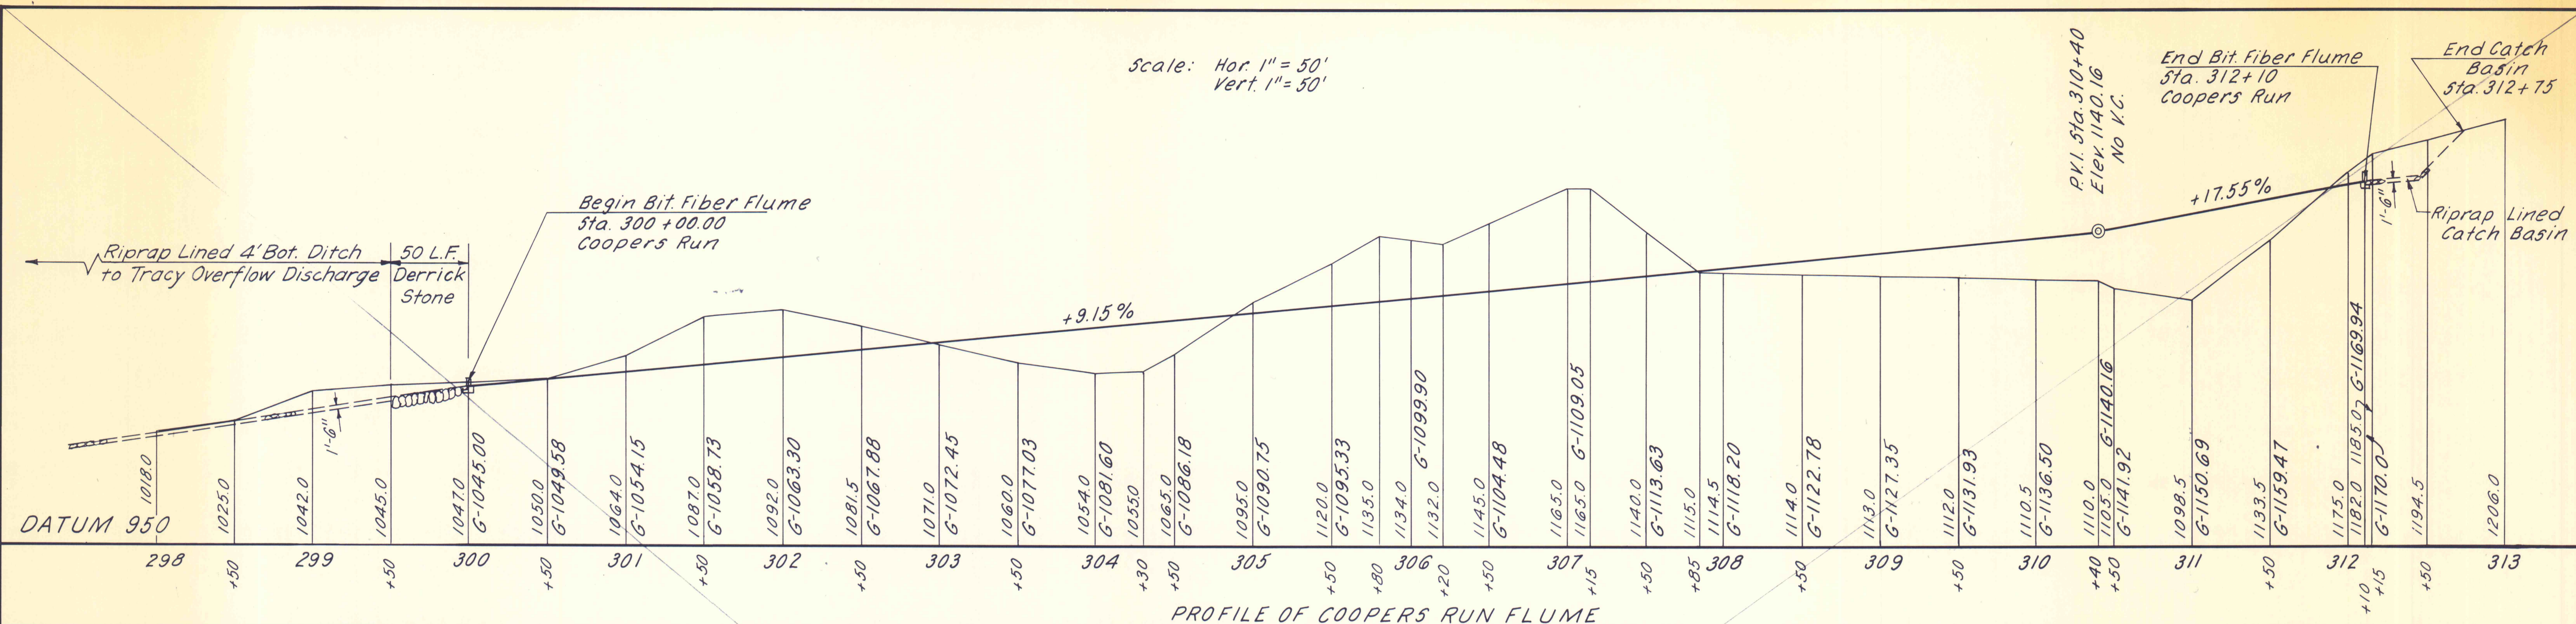

⚠ Entire Sheet Deleted

NO.	DATE	REVISION	APPR.
1	1-13-77	AS BUILT	

SUBMITTED: *Norman E. Mitckler*
 PROFESSIONAL

APPROVED: *Robert C. Roman*
 CHIEF - DIVISION OF MINE DRAINAGE REHABILITATION

APPROVED: *John Perrege*
 DIRECTOR - BUREAU OF CONSULTING SERVICES

COMMONWEALTH OF PENNSYLVANIA
 DEPARTMENT OF ENVIRONMENTAL RESOURCES
 OFFICE OF ENGINEERING AND CONSTRUCTION

PROJECT NO. SL-126-2-7

MINE DRAINAGE
 POLLUTION ABATEMENT
 SWATARA CREEK WATERSHED
 SCHUYLKILL COUNTY

BERGER ASSOCIATES, INC.
 Consulting Engineers
 P.O. Box 1943 Harrisburg, Penna.

PROFILES
 COOPERS RUN AND
 UPPER MIDDLE CREEK

DRAWN BY: W. G. DATE: APR. 17, 1973 DRAWING NO.: 21 of 43
 CHECKED BY: M. W. SCALE: AS SHOWN

