




TYPICAL DETAIL FOR STANDARD TERRACING
No Scale

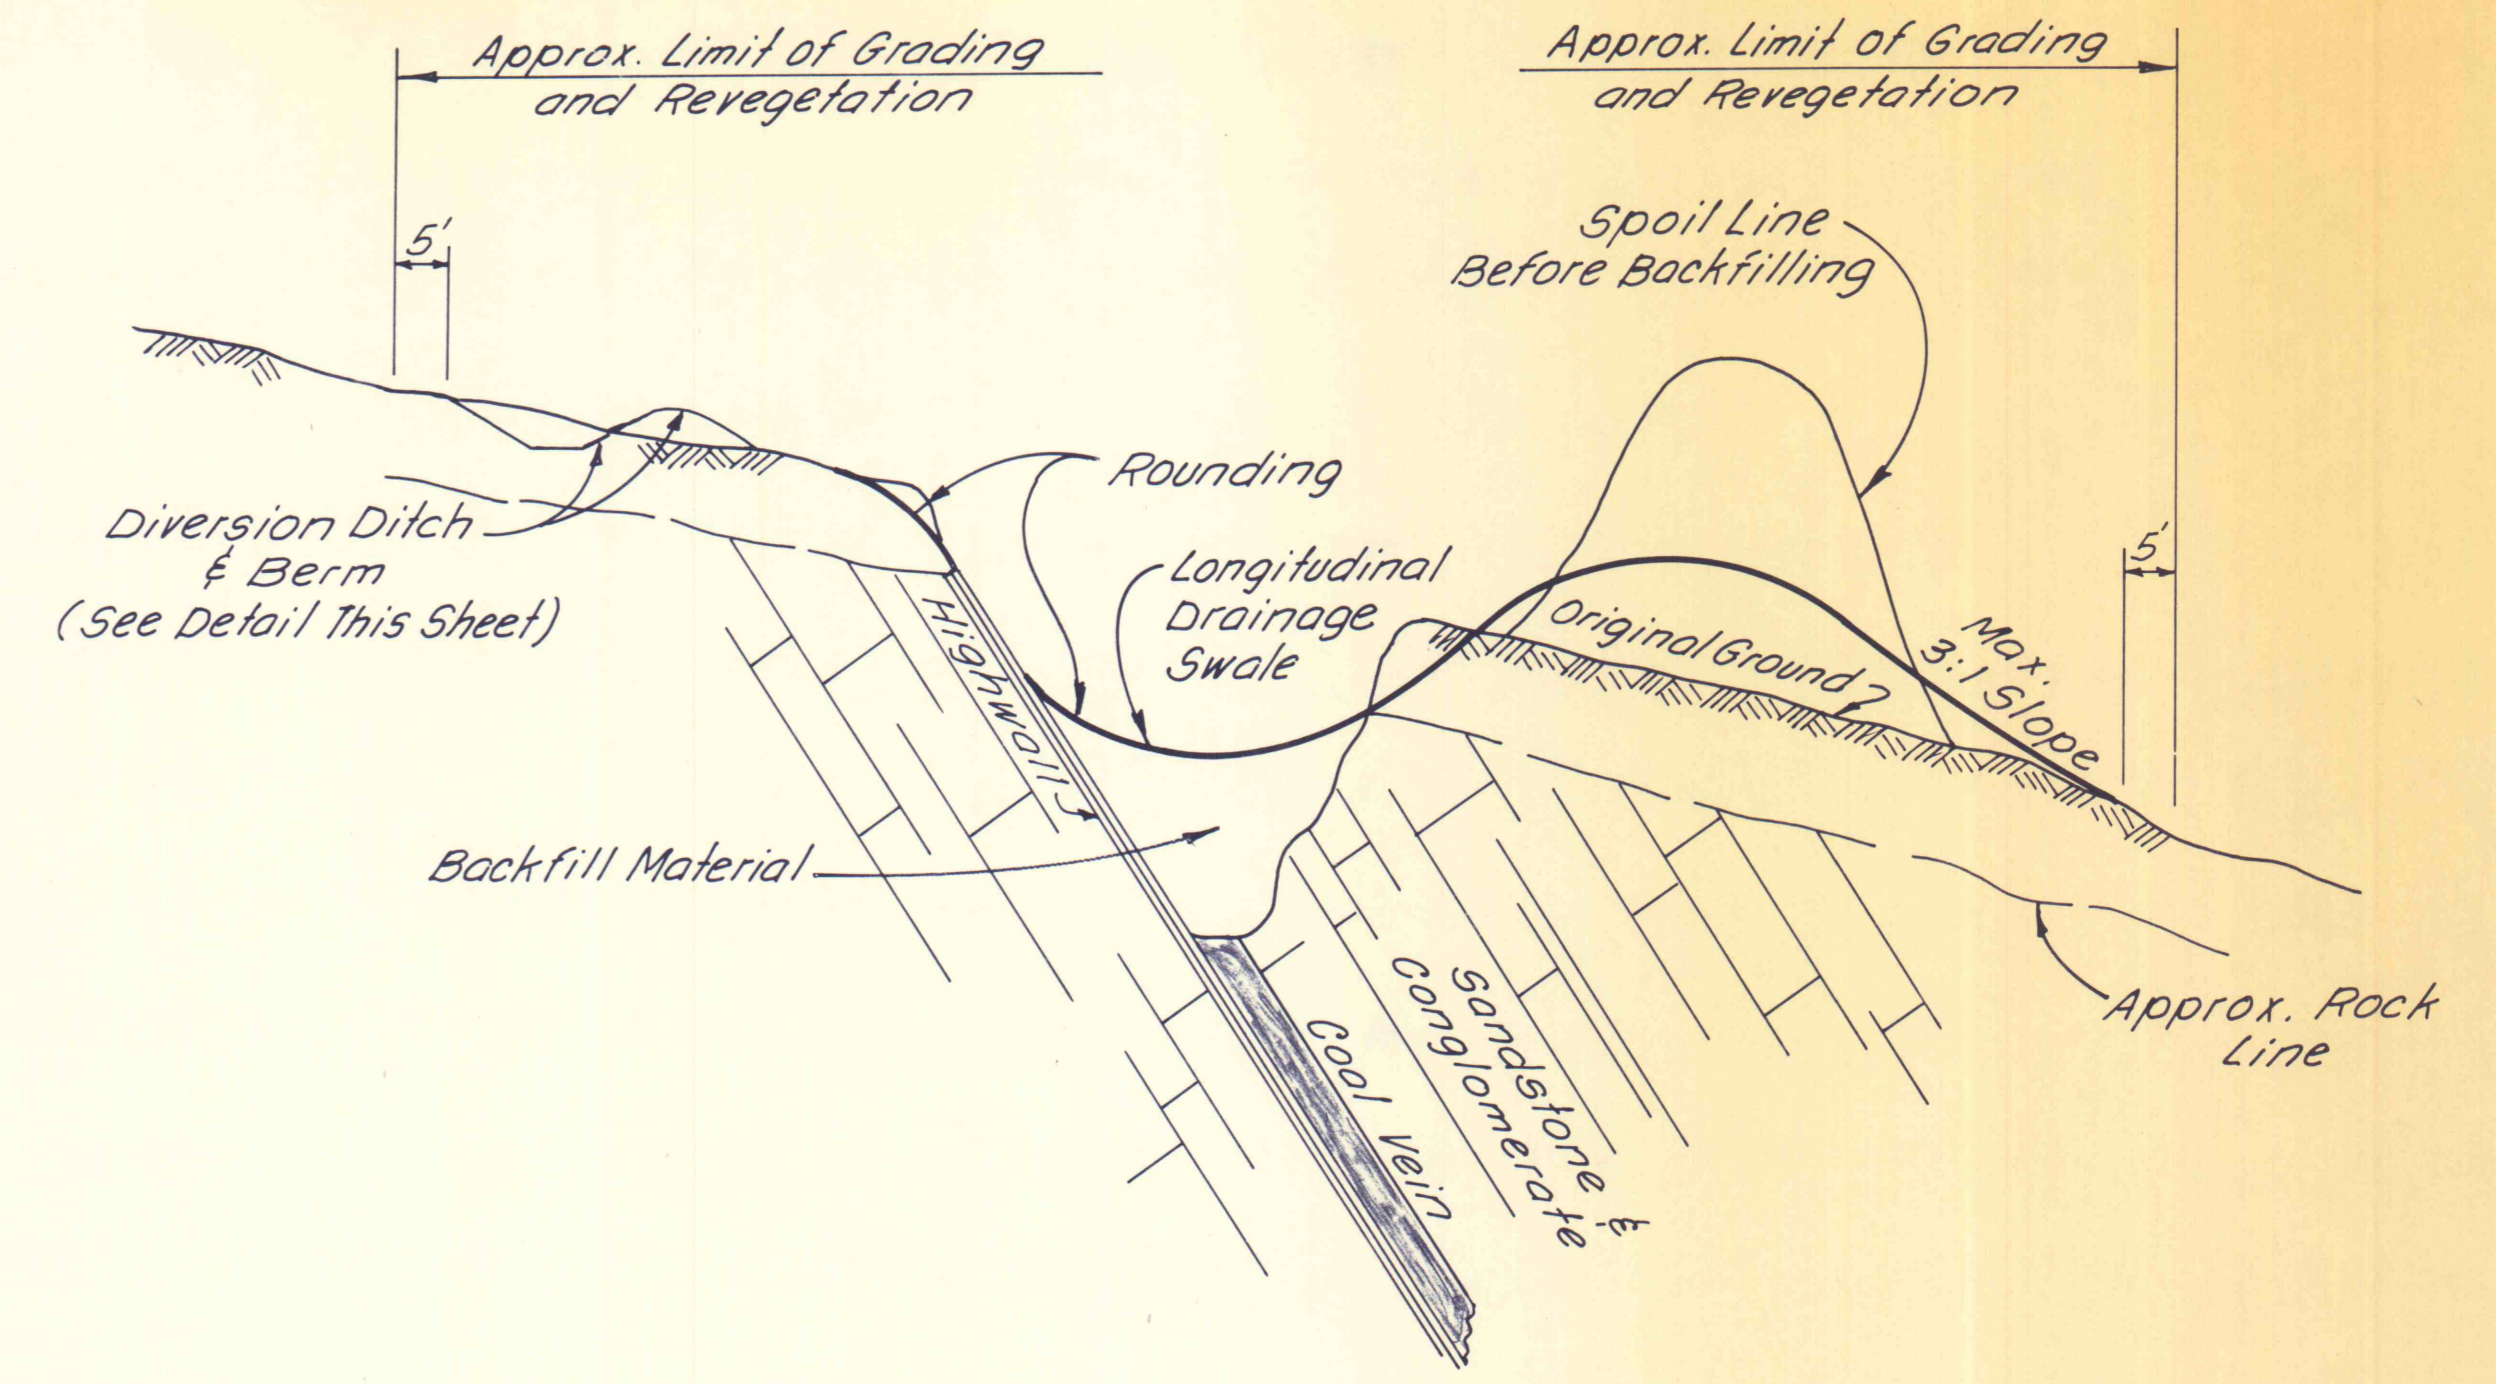


TYPICAL DETAIL FOR MODIFIED TERRACING (B)
No Scale

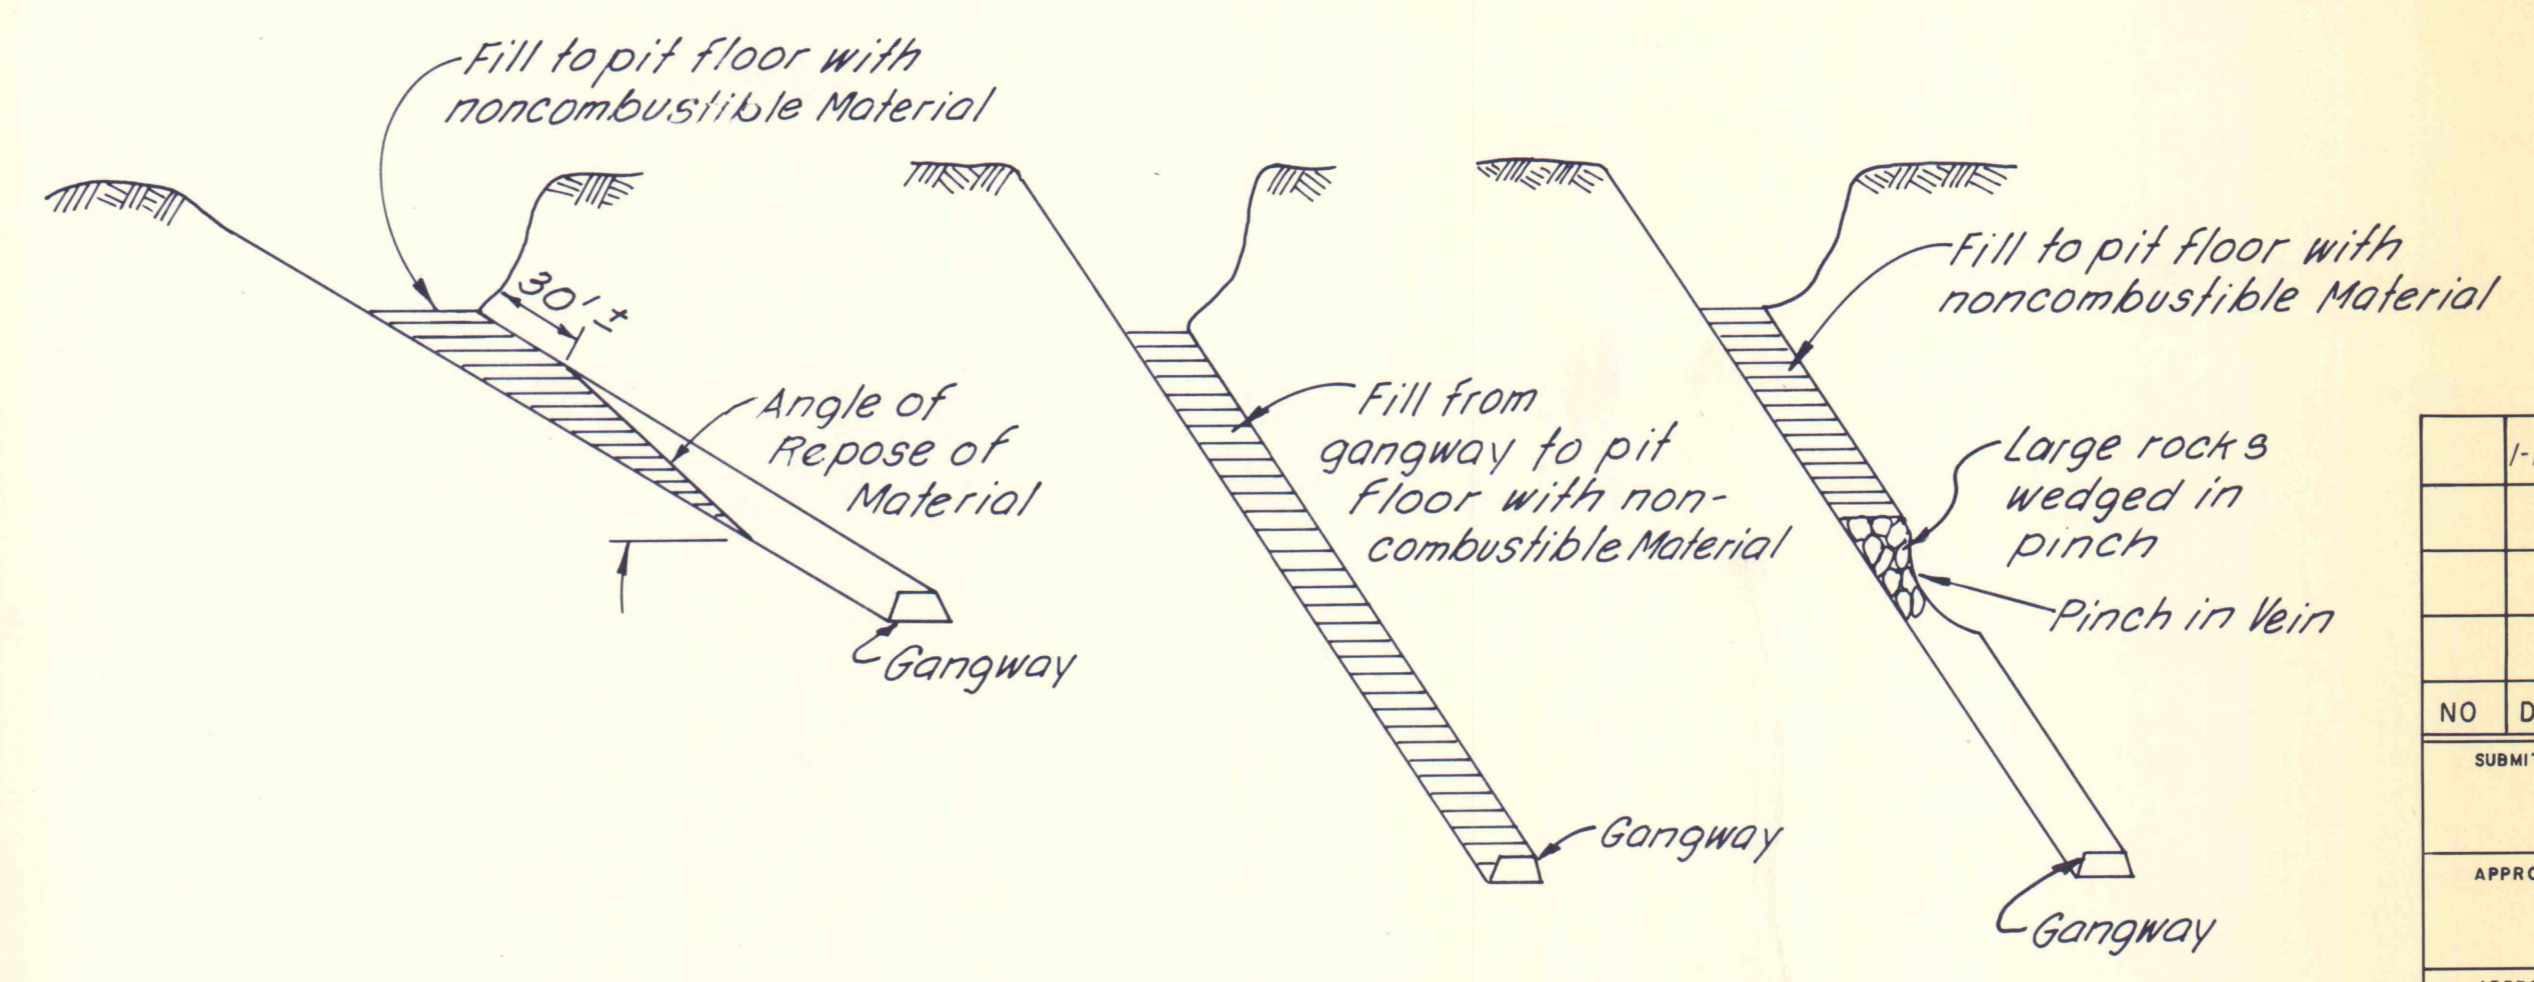


METHOD OF FILLING OPENINGS IN STRIP PITS PRIOR TO BACKFILLING
No Scale

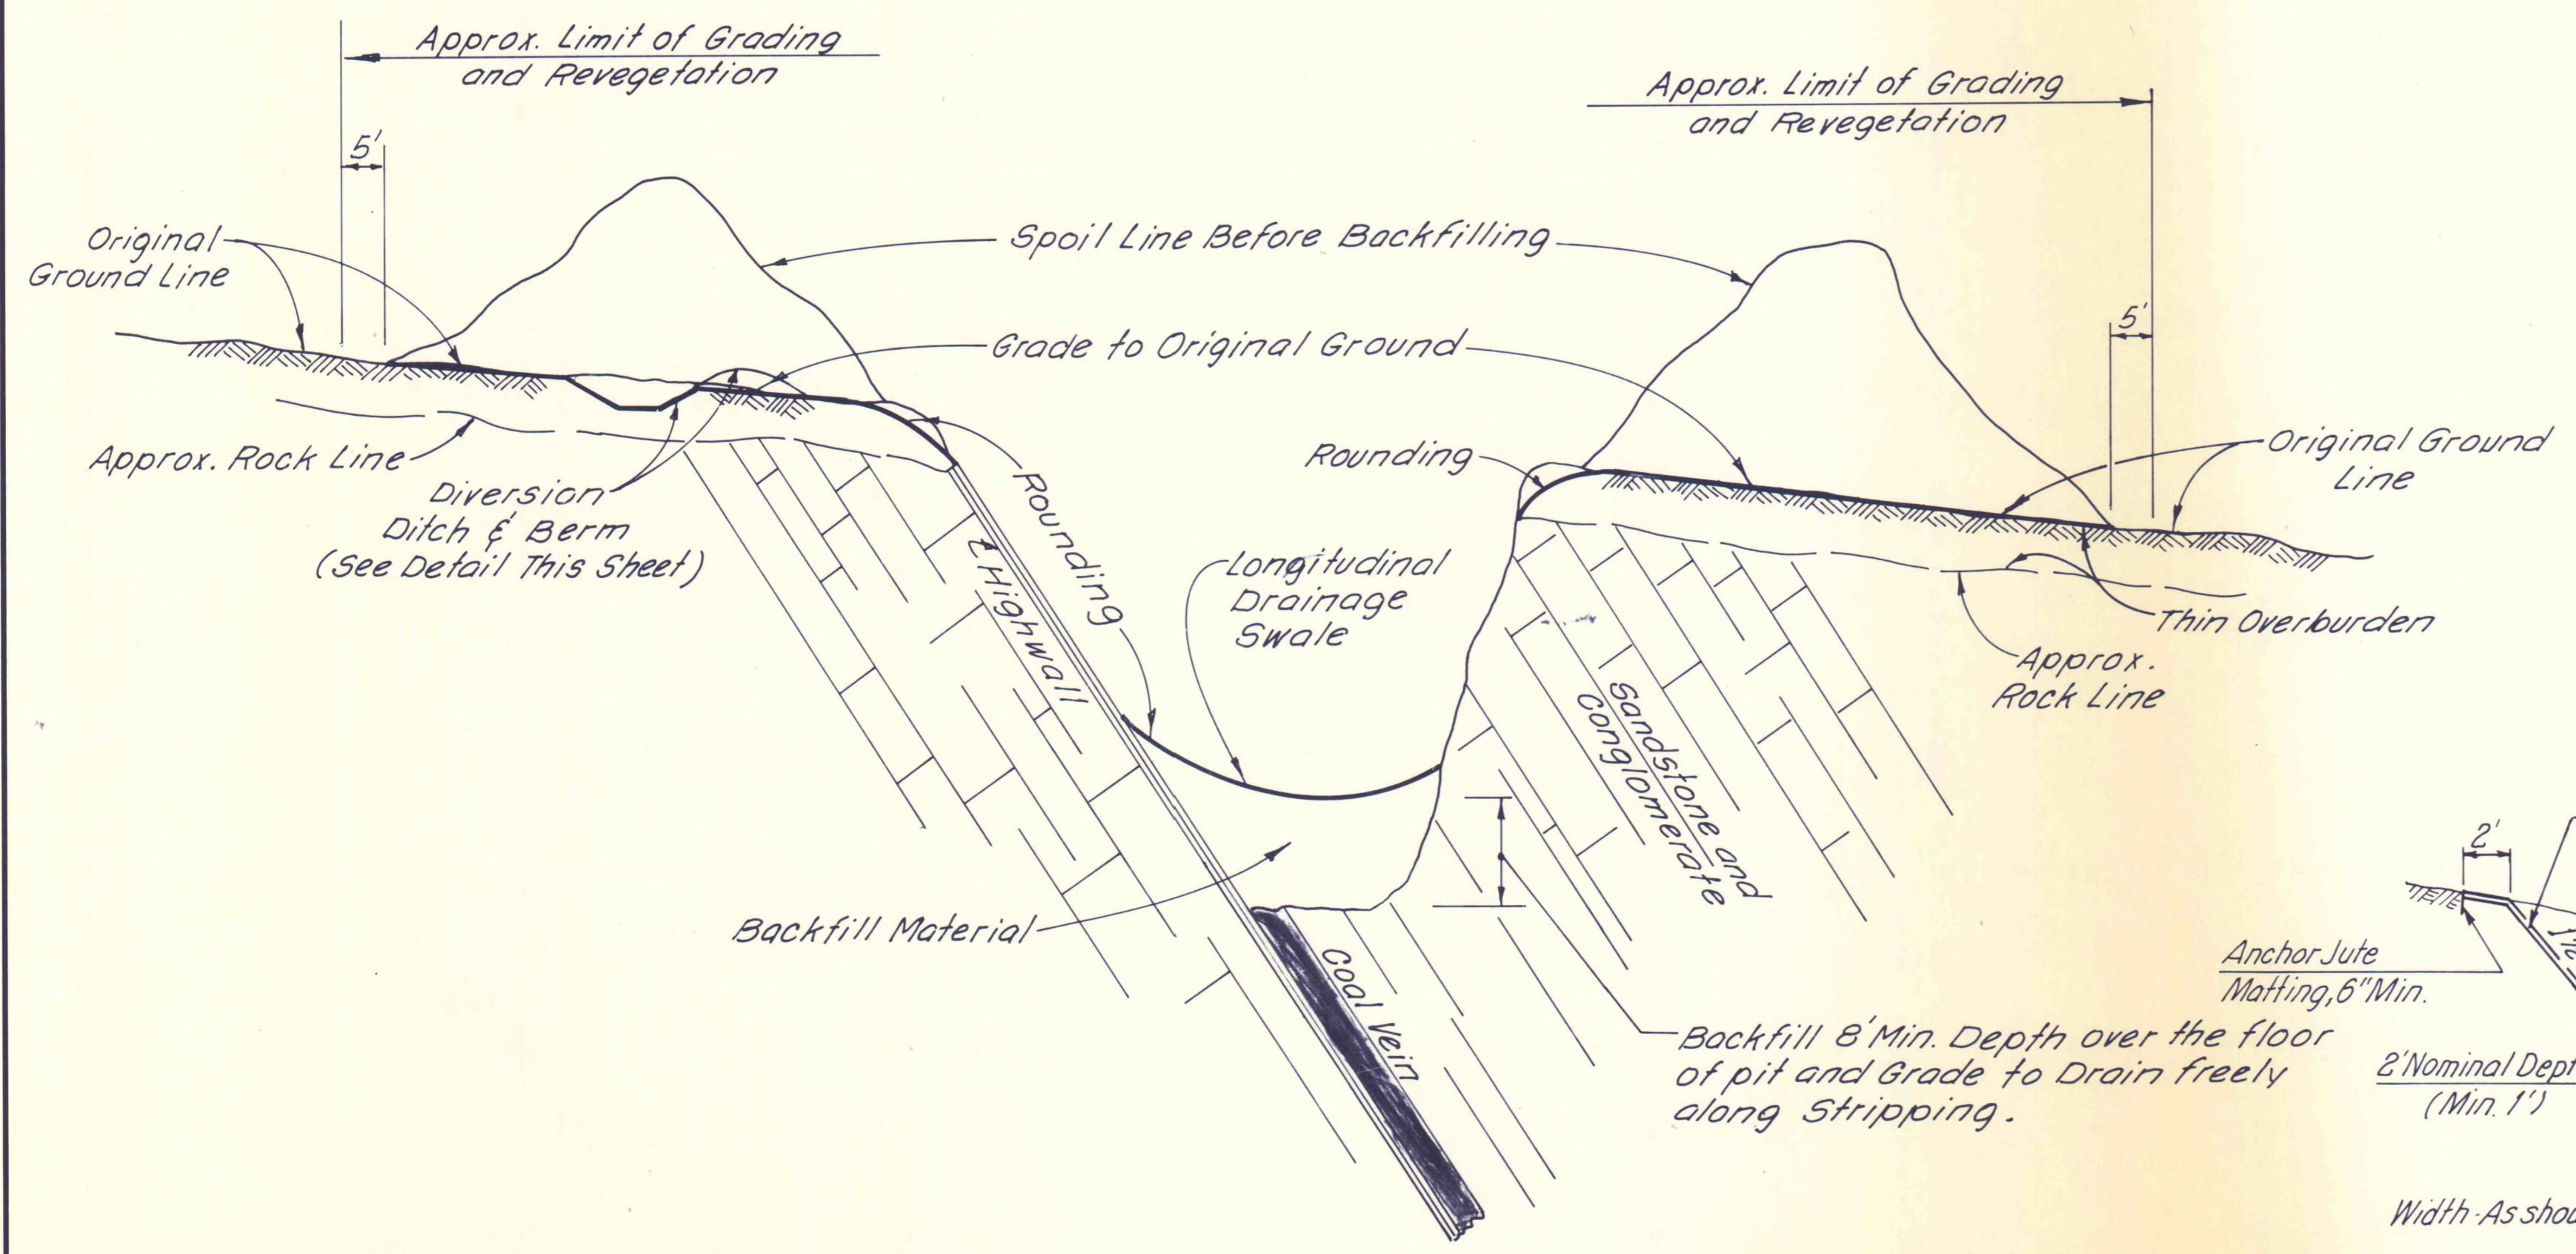

TYPICAL DETAIL FOR MODIFIED TERRACING (A)
No Scale

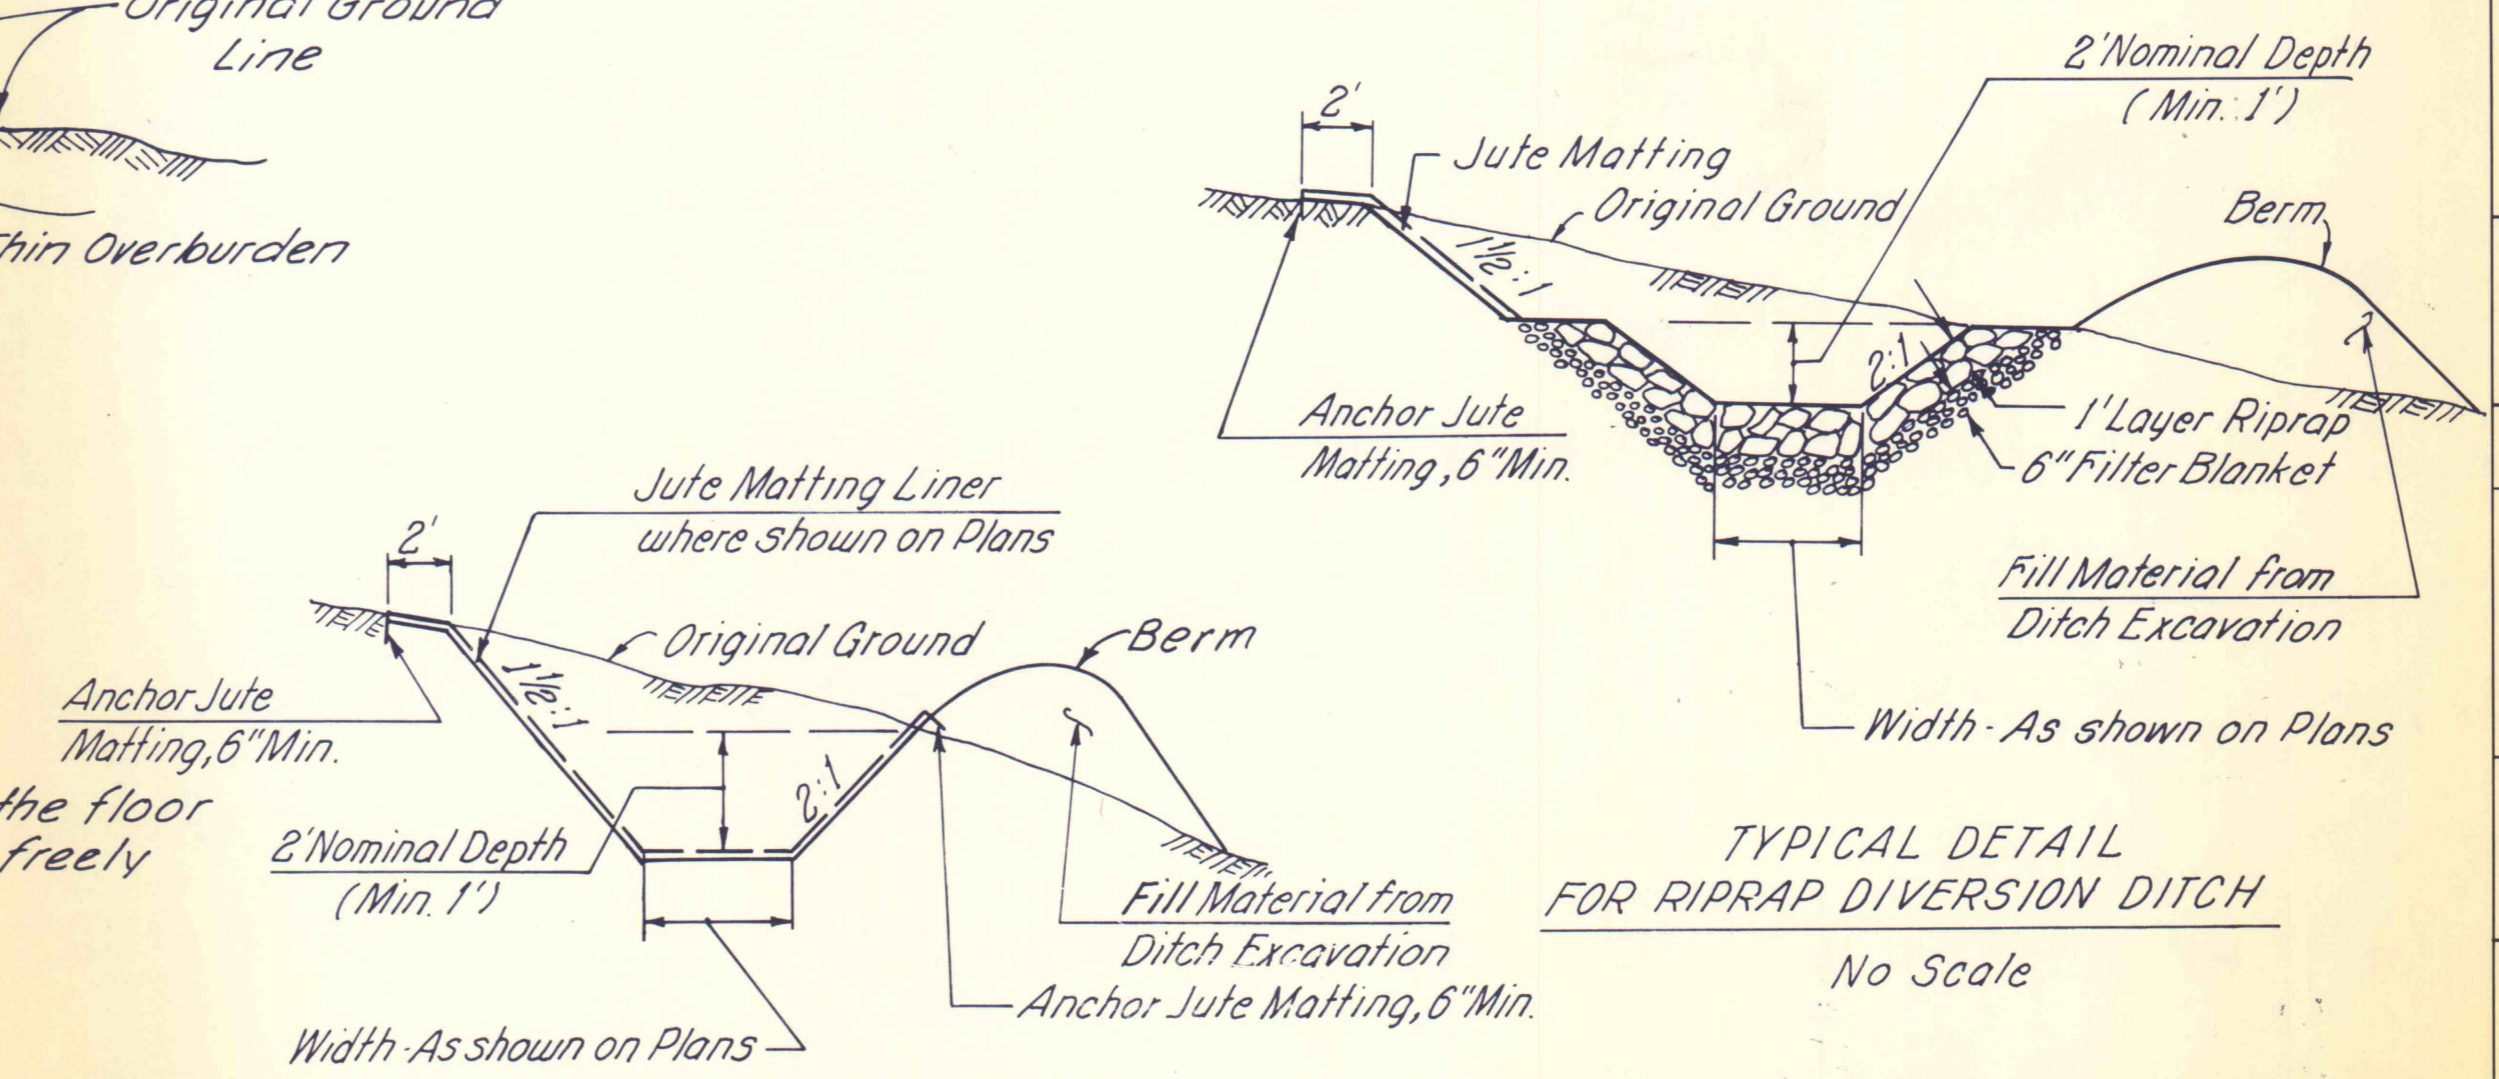


TYPICAL DETAIL FOR SEEDING AND JUTE MATTING LINED DIVERSION DITCH
No Scale

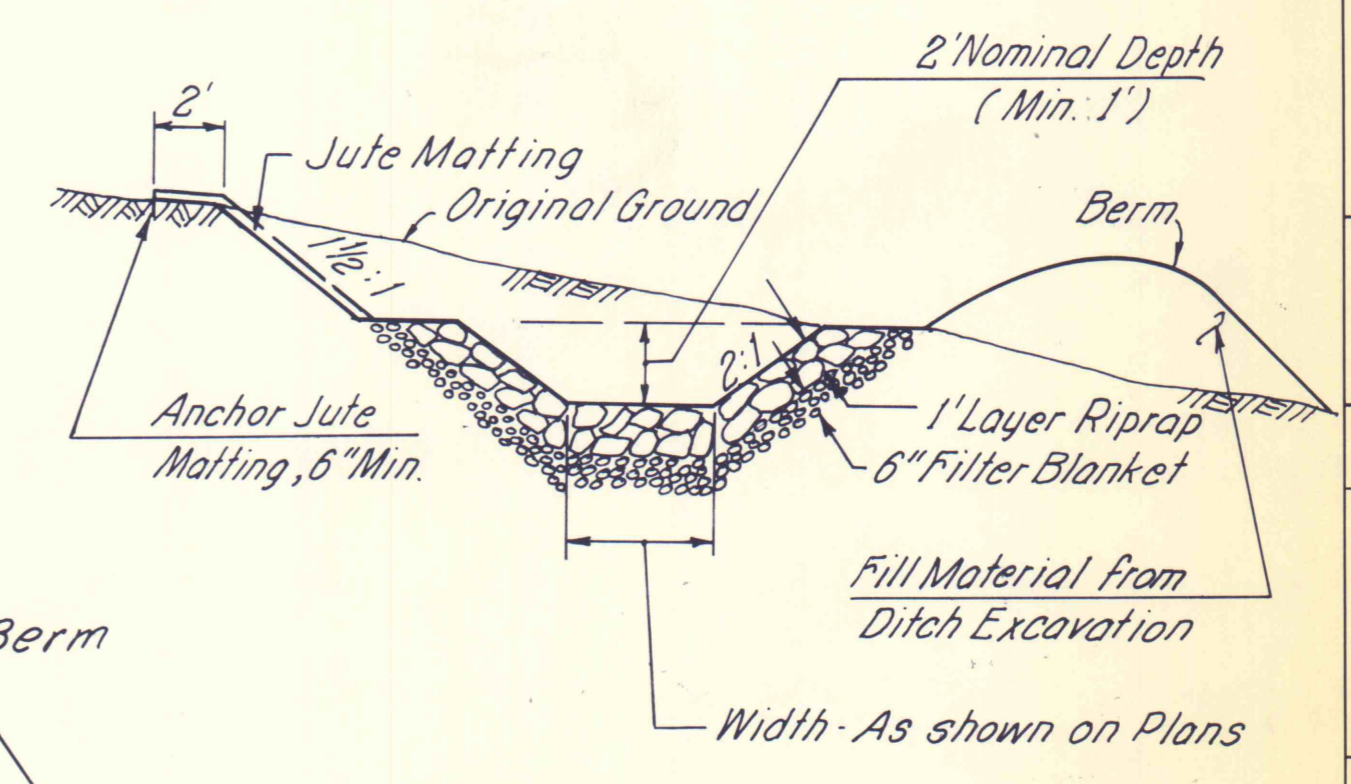

TYPICAL DETAIL FOR RIPRAP DIVERSION DITCH
No Scale

1-13-77	AS BUILT		
NO	DATE	REVISION	APPR.
SUBMITTED	Norman E. Matzler		
APPROVED	Alvin A. Romani CHIEF - DIVISION OF MINE DRAINAGE REHABILITATION		
APPROVED	D.W. Perry DIRECTOR - BUREAU OF CONSULTING SERVICES		

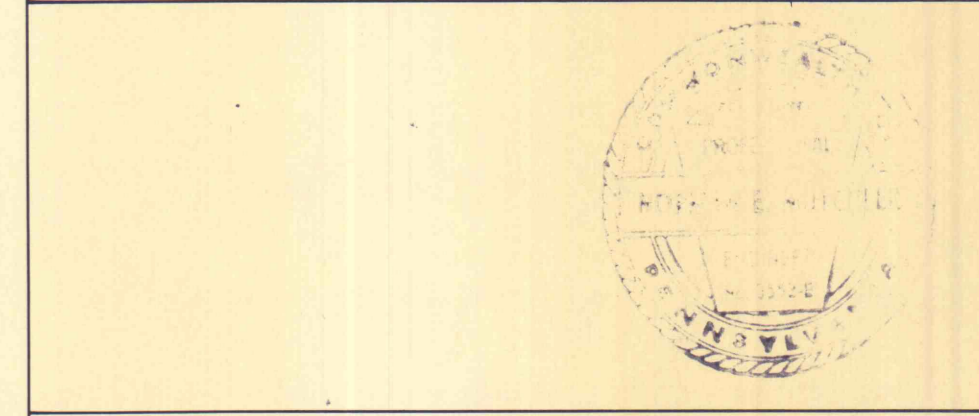

COMMONWEALTH OF PENNSYLVANIA
DEPARTMENT OF ENVIRONMENTAL RESOURCES
OFFICE OF ENGINEERING AND CONSTRUCTION

PROJECT NO. SL-126-2-7

MINE DRAINAGE
POLLUTION ABATEMENT
SWATARA CREEK WATERSHED
SCHUYLKILL COUNTY

BERGER ASSOCIATES, INC.
Consulting Engineers

P.O. Box 1943 Harrisburg, Penna.

TYPICAL SECTIONS & DETAILS

DRAWN BY J.S.	DATE APR. 17, 1973	DRAWING NO. 39 of 43
CHECKED BY M.W.	SCALE NO SCALE	