
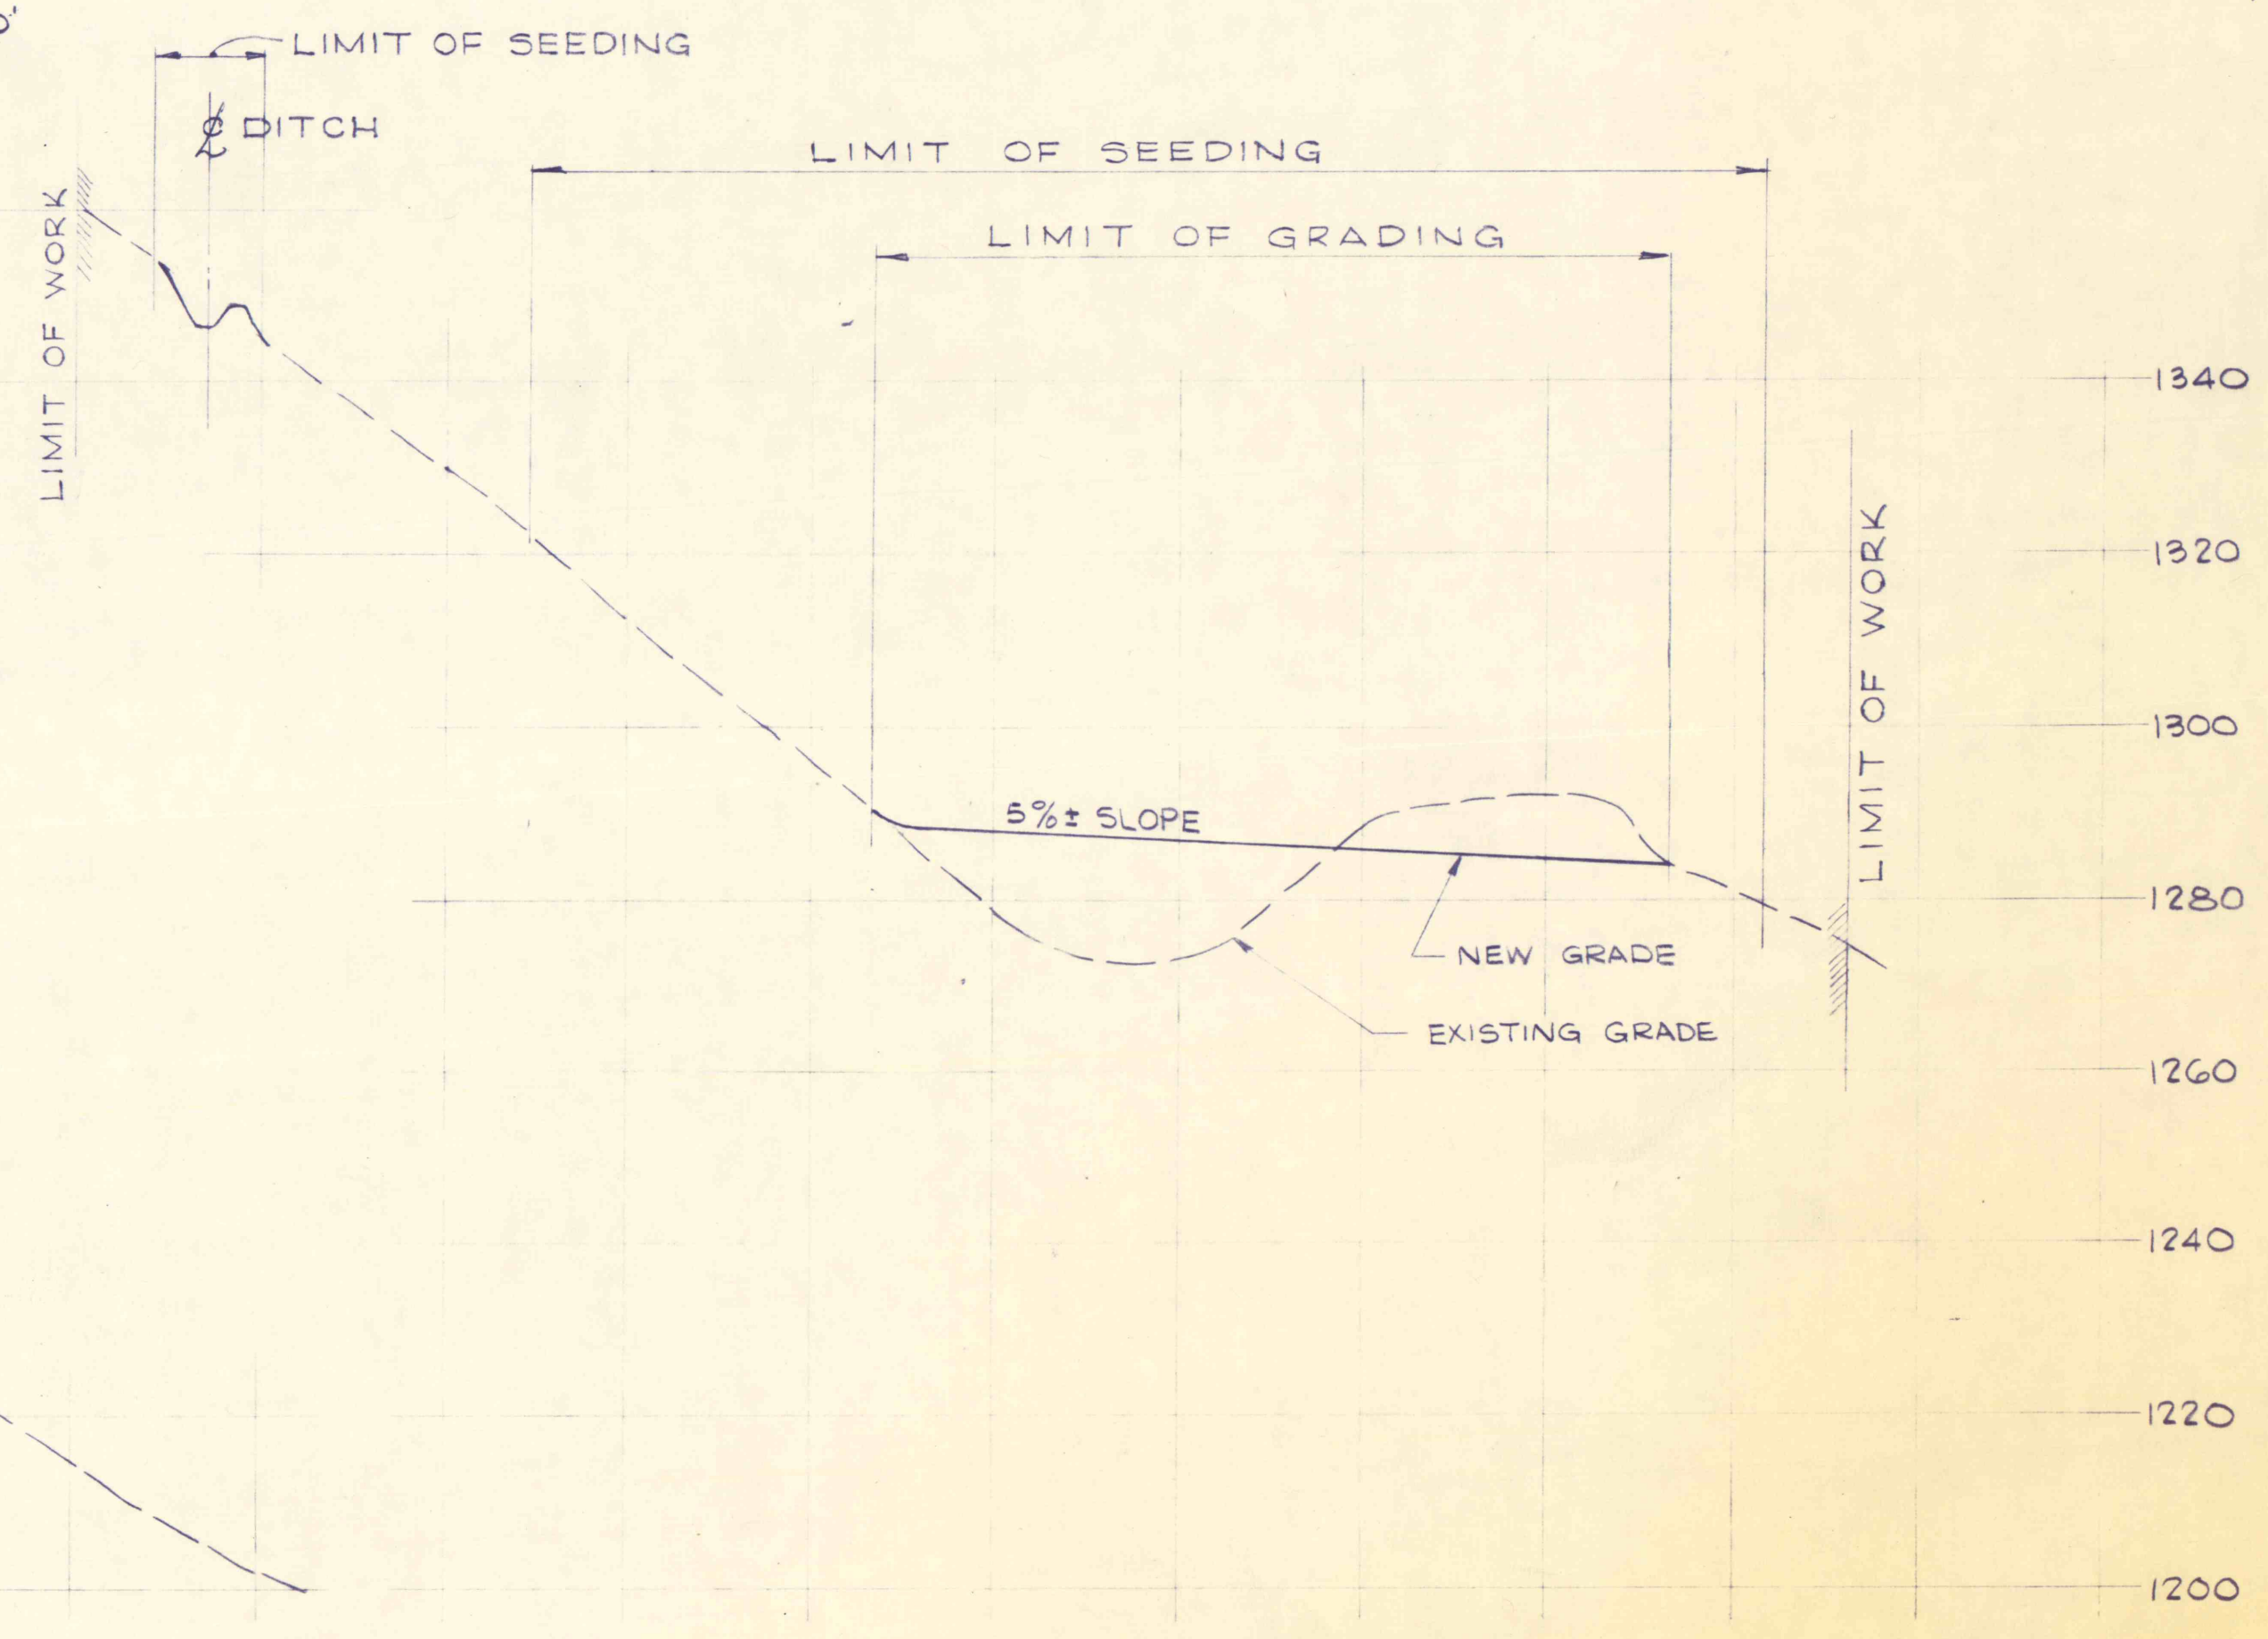


PLAN
SCALE: 1" = 100'

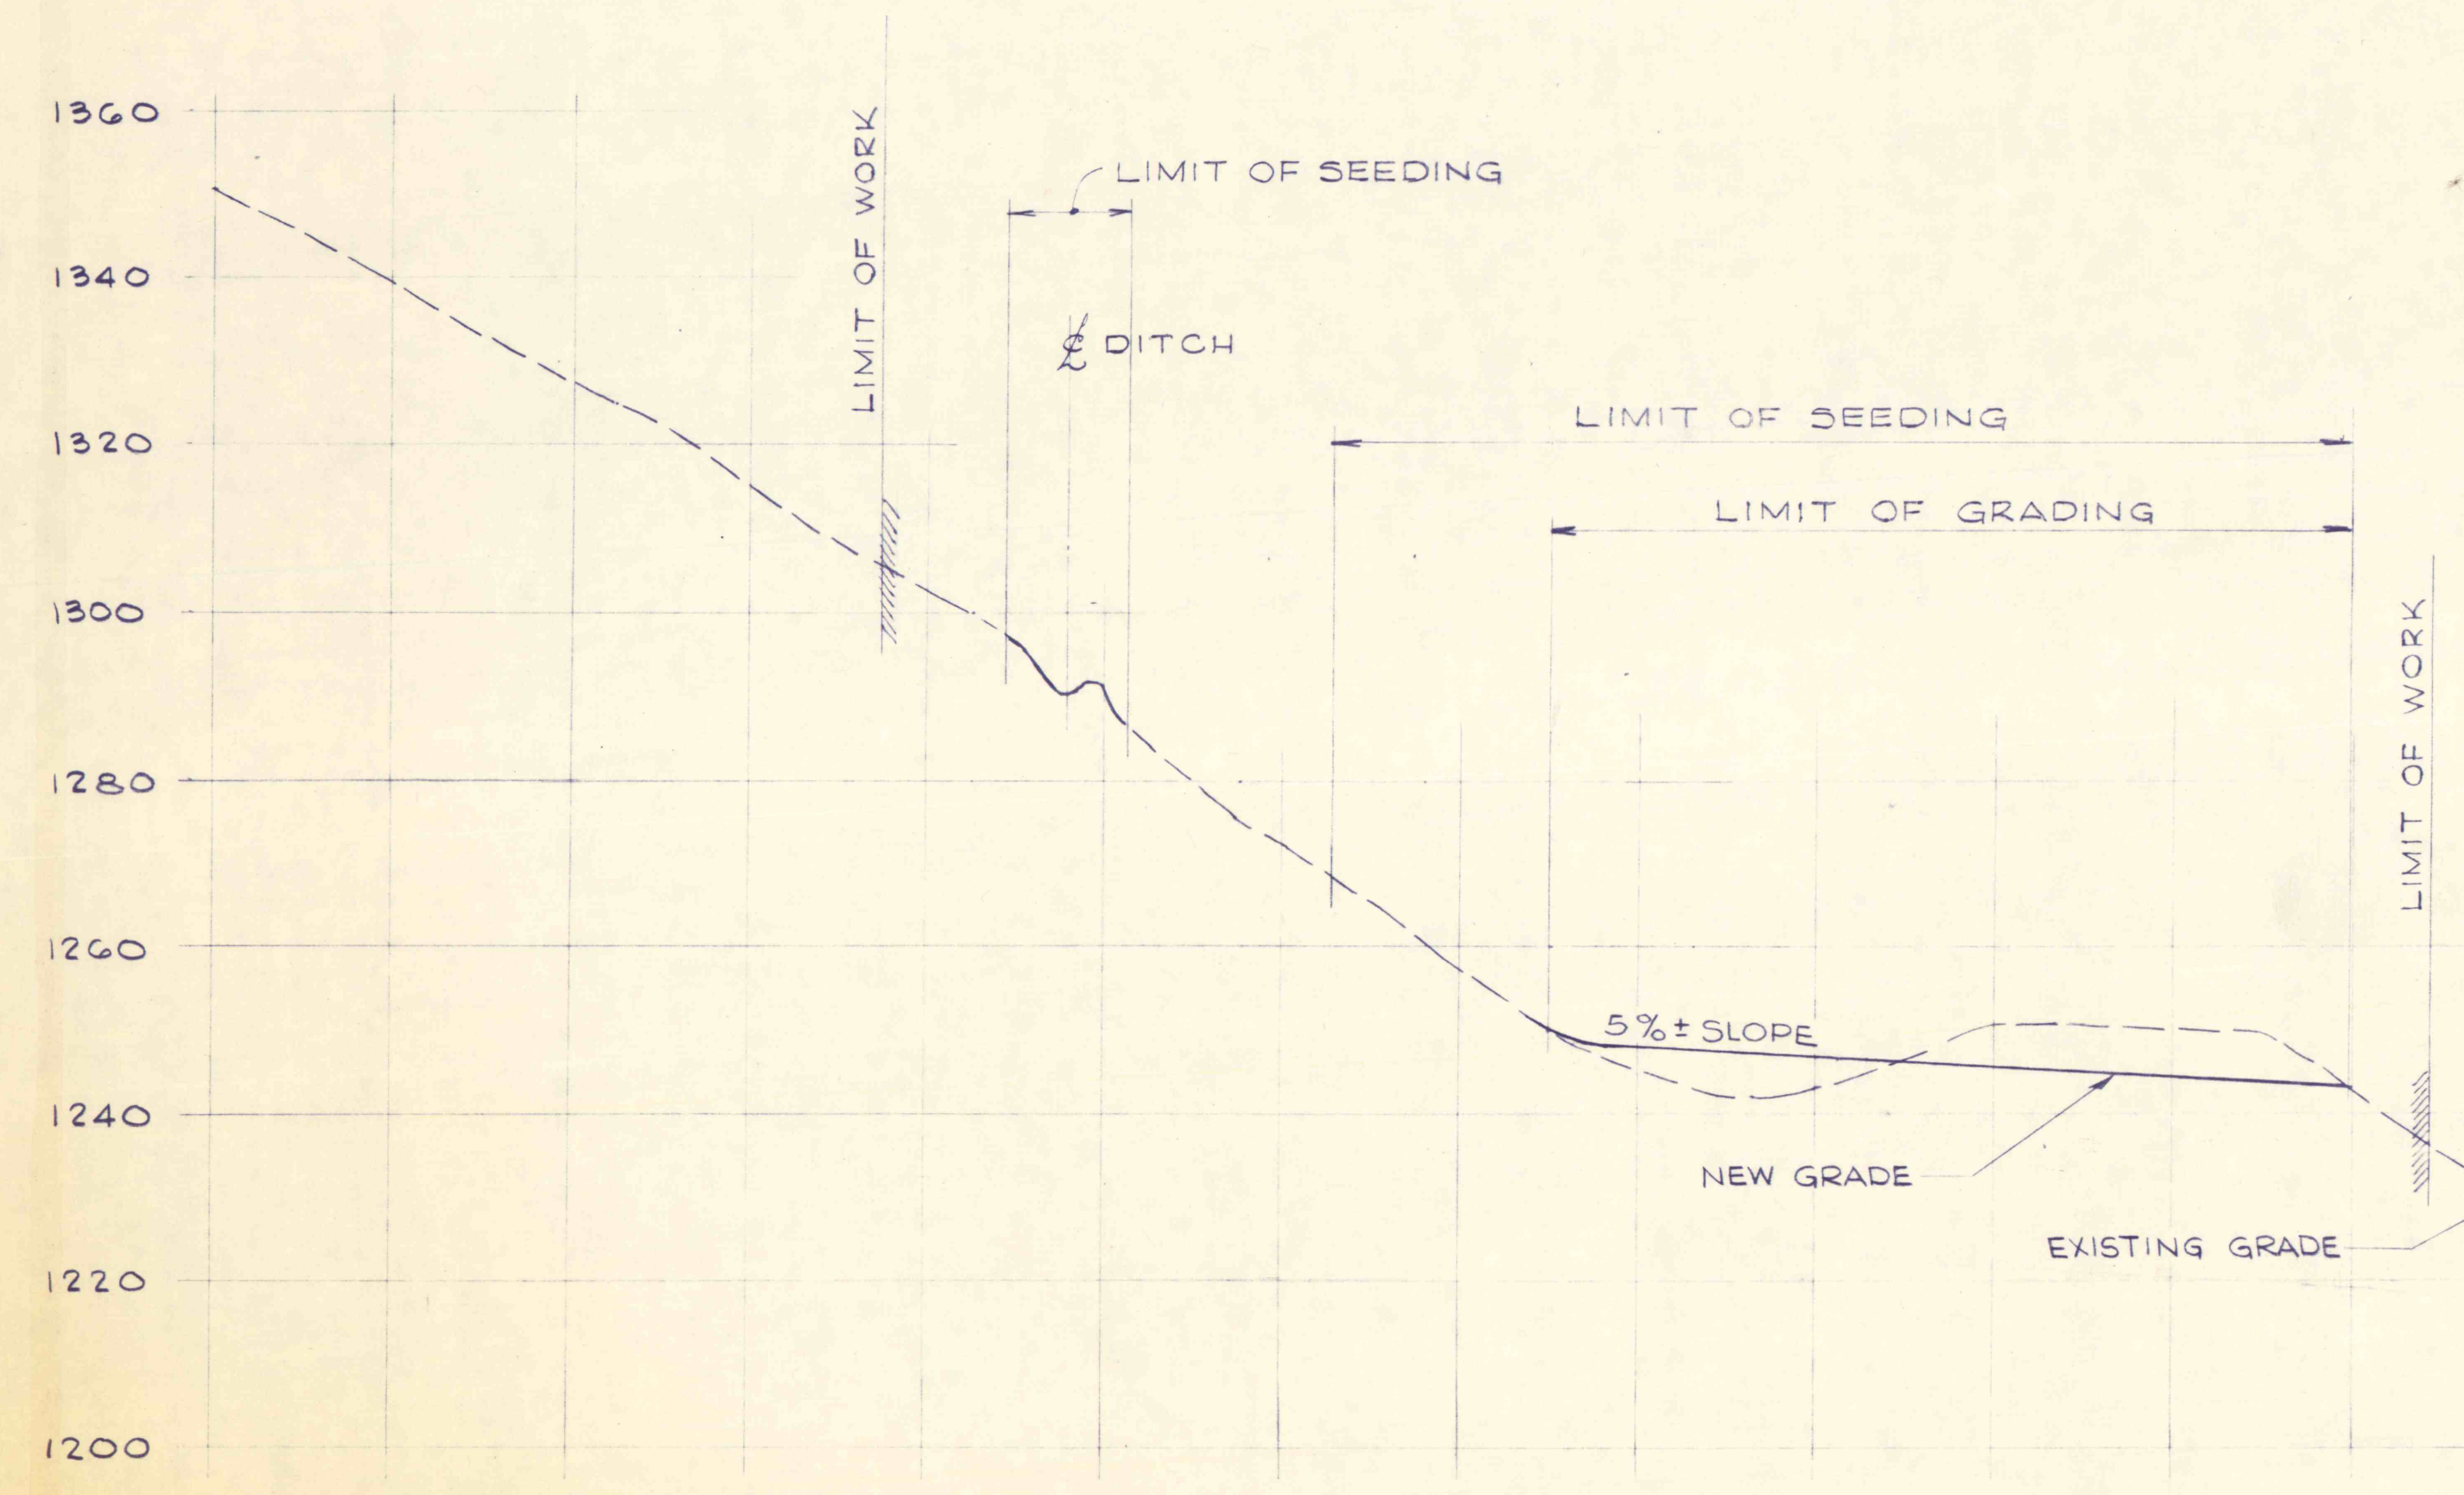

FOR LEGEND & NOTES SEE DWG. NO. 2

NO.	DATE	REVISION	APPR.
1	8-24-75	As built	

SUBMITTED
Thomas Richard Babcock
PROFESSIONAL

APPROVED
Robert C. Roman
CHIEF - DIVISION OF MINE DRAINAGE REHABILITATION

APPROVED
SWP, Inc.
DIRECTOR - BUREAU OF CONSULTING SERVICES



COMMONWEALTH OF PENNSYLVANIA
DEPARTMENT OF ENVIRONMENTAL RESOURCES
OFFICE OF ENGINEERING AND CONSTRUCTION

PROJECT NO. SL 170
STRIP MINE RECLAMATION
QUICK START PROJECT "B"
STATE GAME LAND NO. 264
WICONISCO CREEK WATERSHED
DAUPHIN COUNTY, PENNA.

SANDERS AND THOMAS, INC.
CONSULTING ENGINEERS
EXECUTIVE OFFICES: POTTSTOWN, PENNSYLVANIA
BRANCH OFFICES: PHILADELPHIA, PA. - LONG ISLAND, N.Y. - MIAMI, FLA.
PITTSBURGH, PA. - BALTIMORE, MD. - LONG BEACH, CALIF. - WASHINGTON, D.C.

**PLAN & CROSS-SECTIONS
NOS. 1 & 4**

DRAWN BY TZ	DATE MAY 4, 1973	DRAWING NO. 3 of 7
CHECKED BY TB	SCALE AS NOTED	