



PLAN
SCALE: 1"=100'

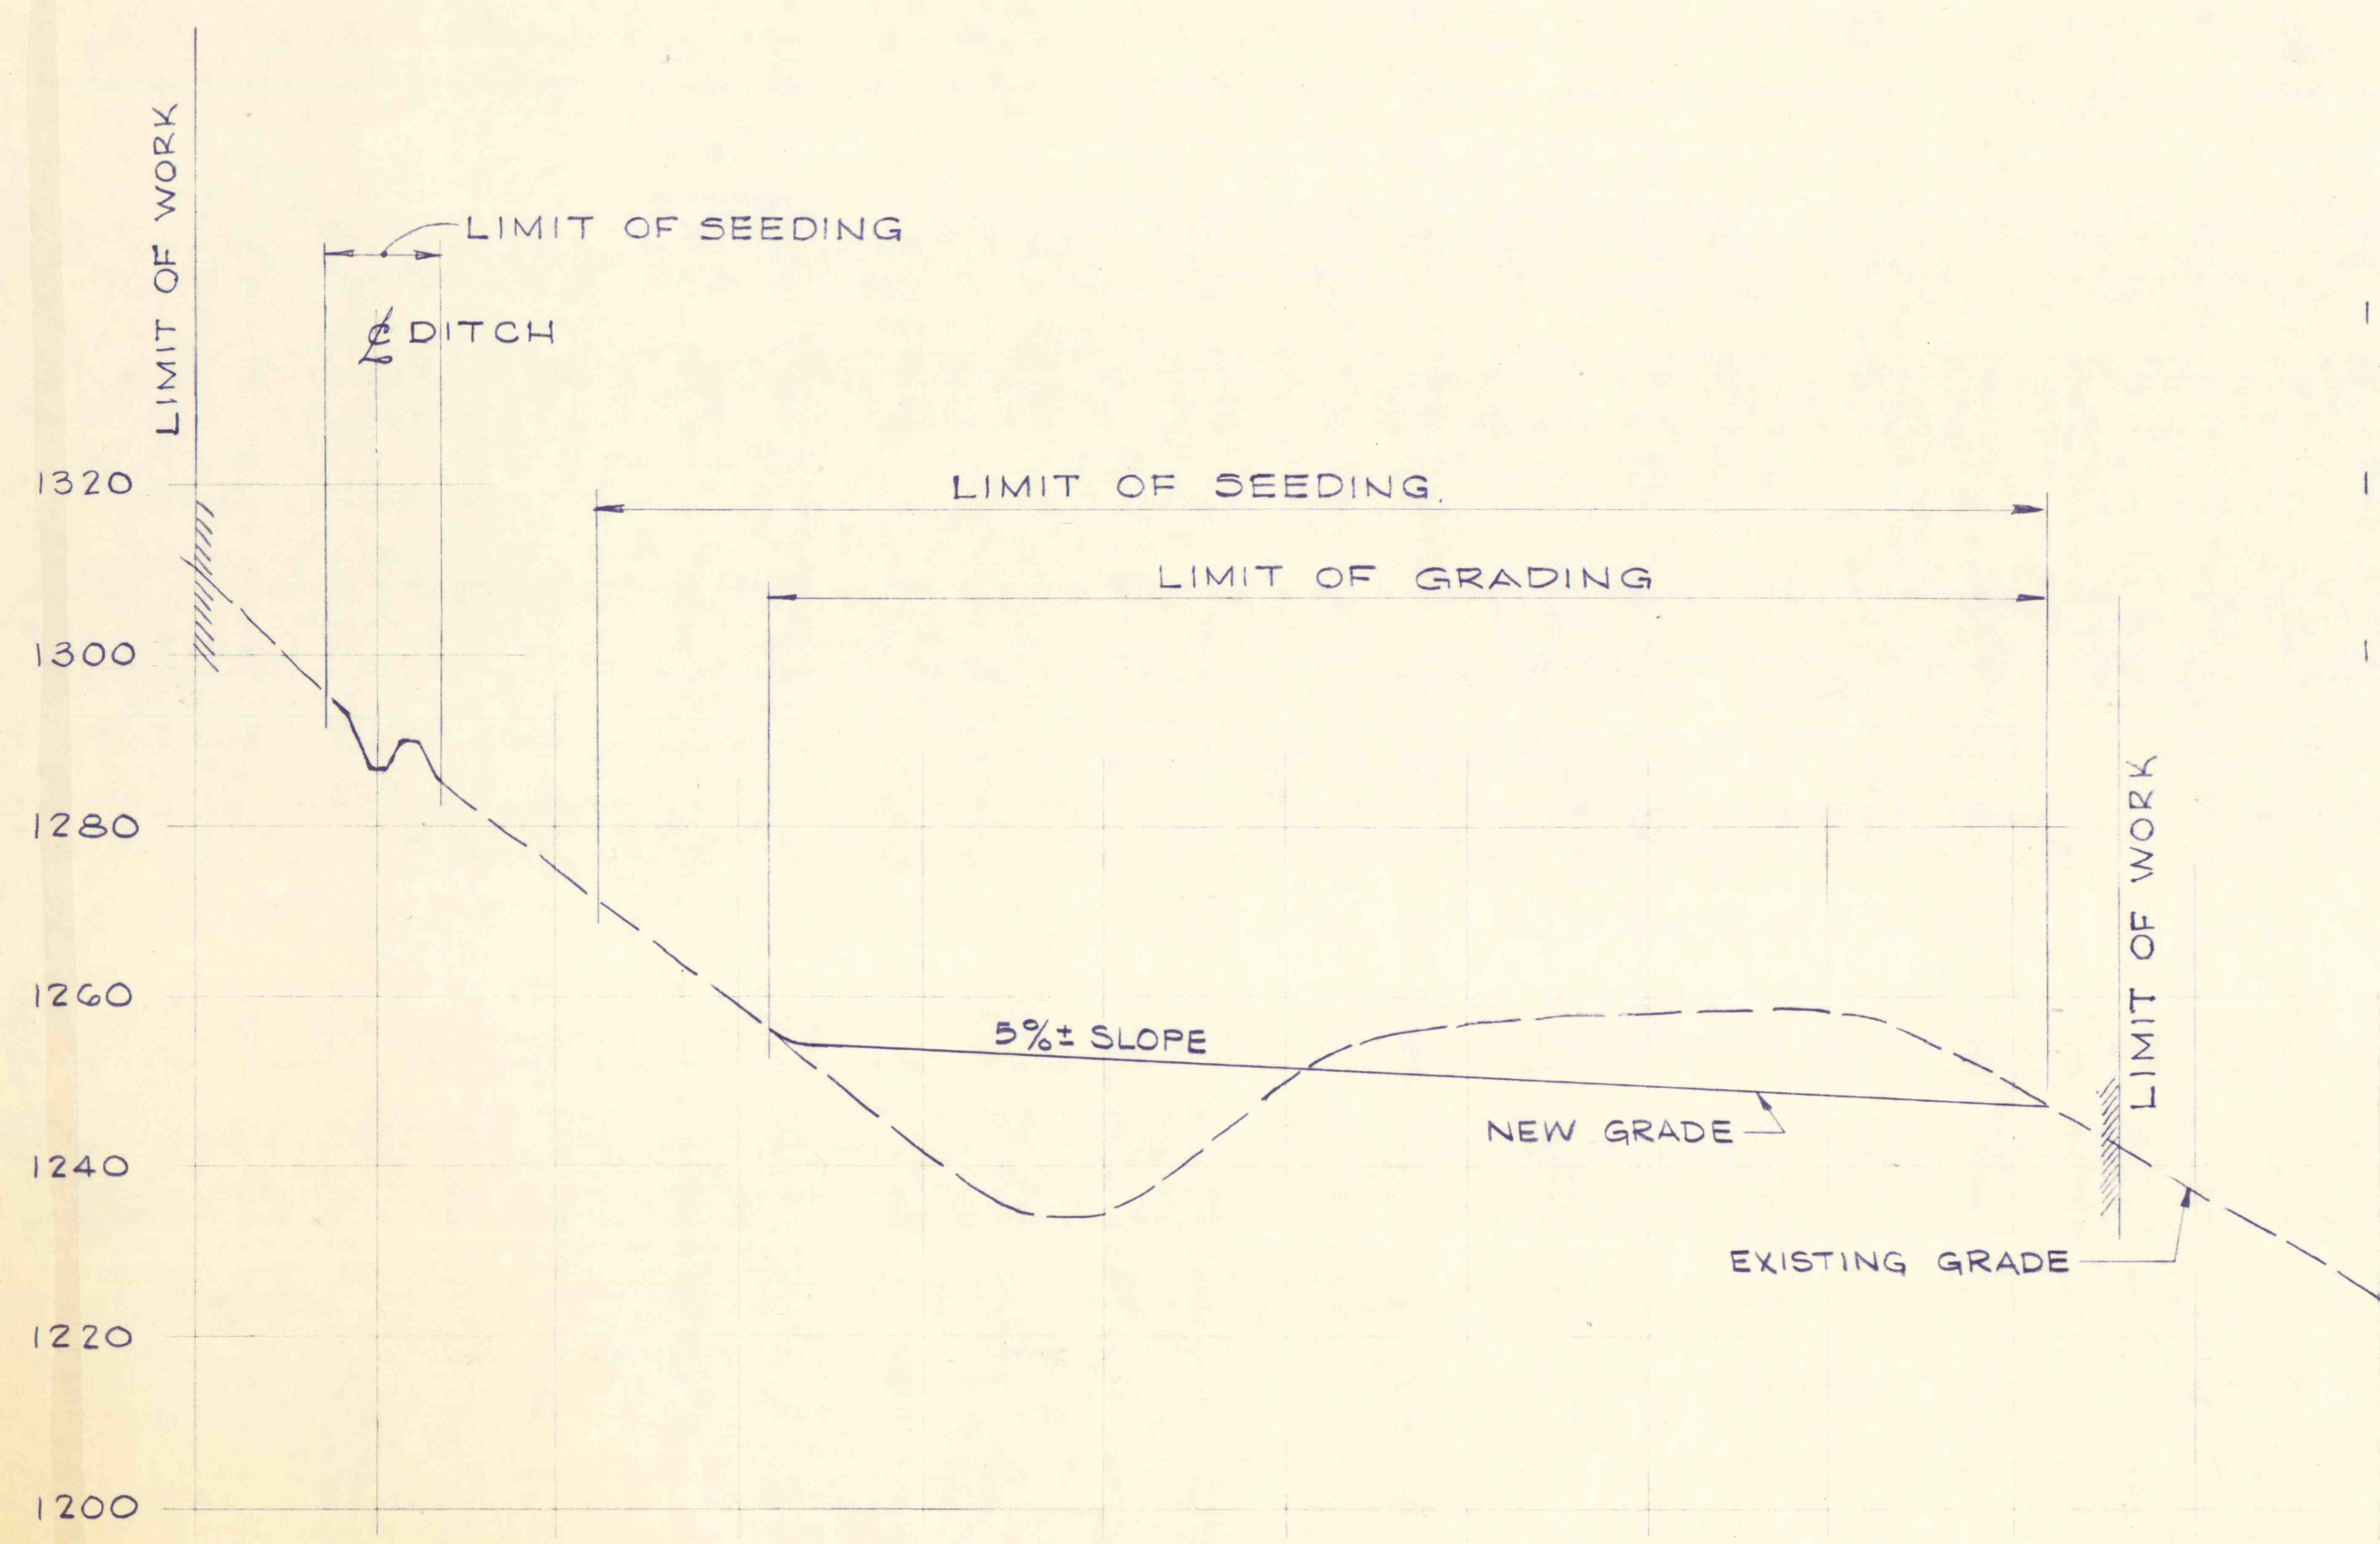

CROSS-SECTION NO. 5
SCALE: 1"=20' (HORIZ. & VERT.)
FOR LOCATION SEE THIS DRAWING.

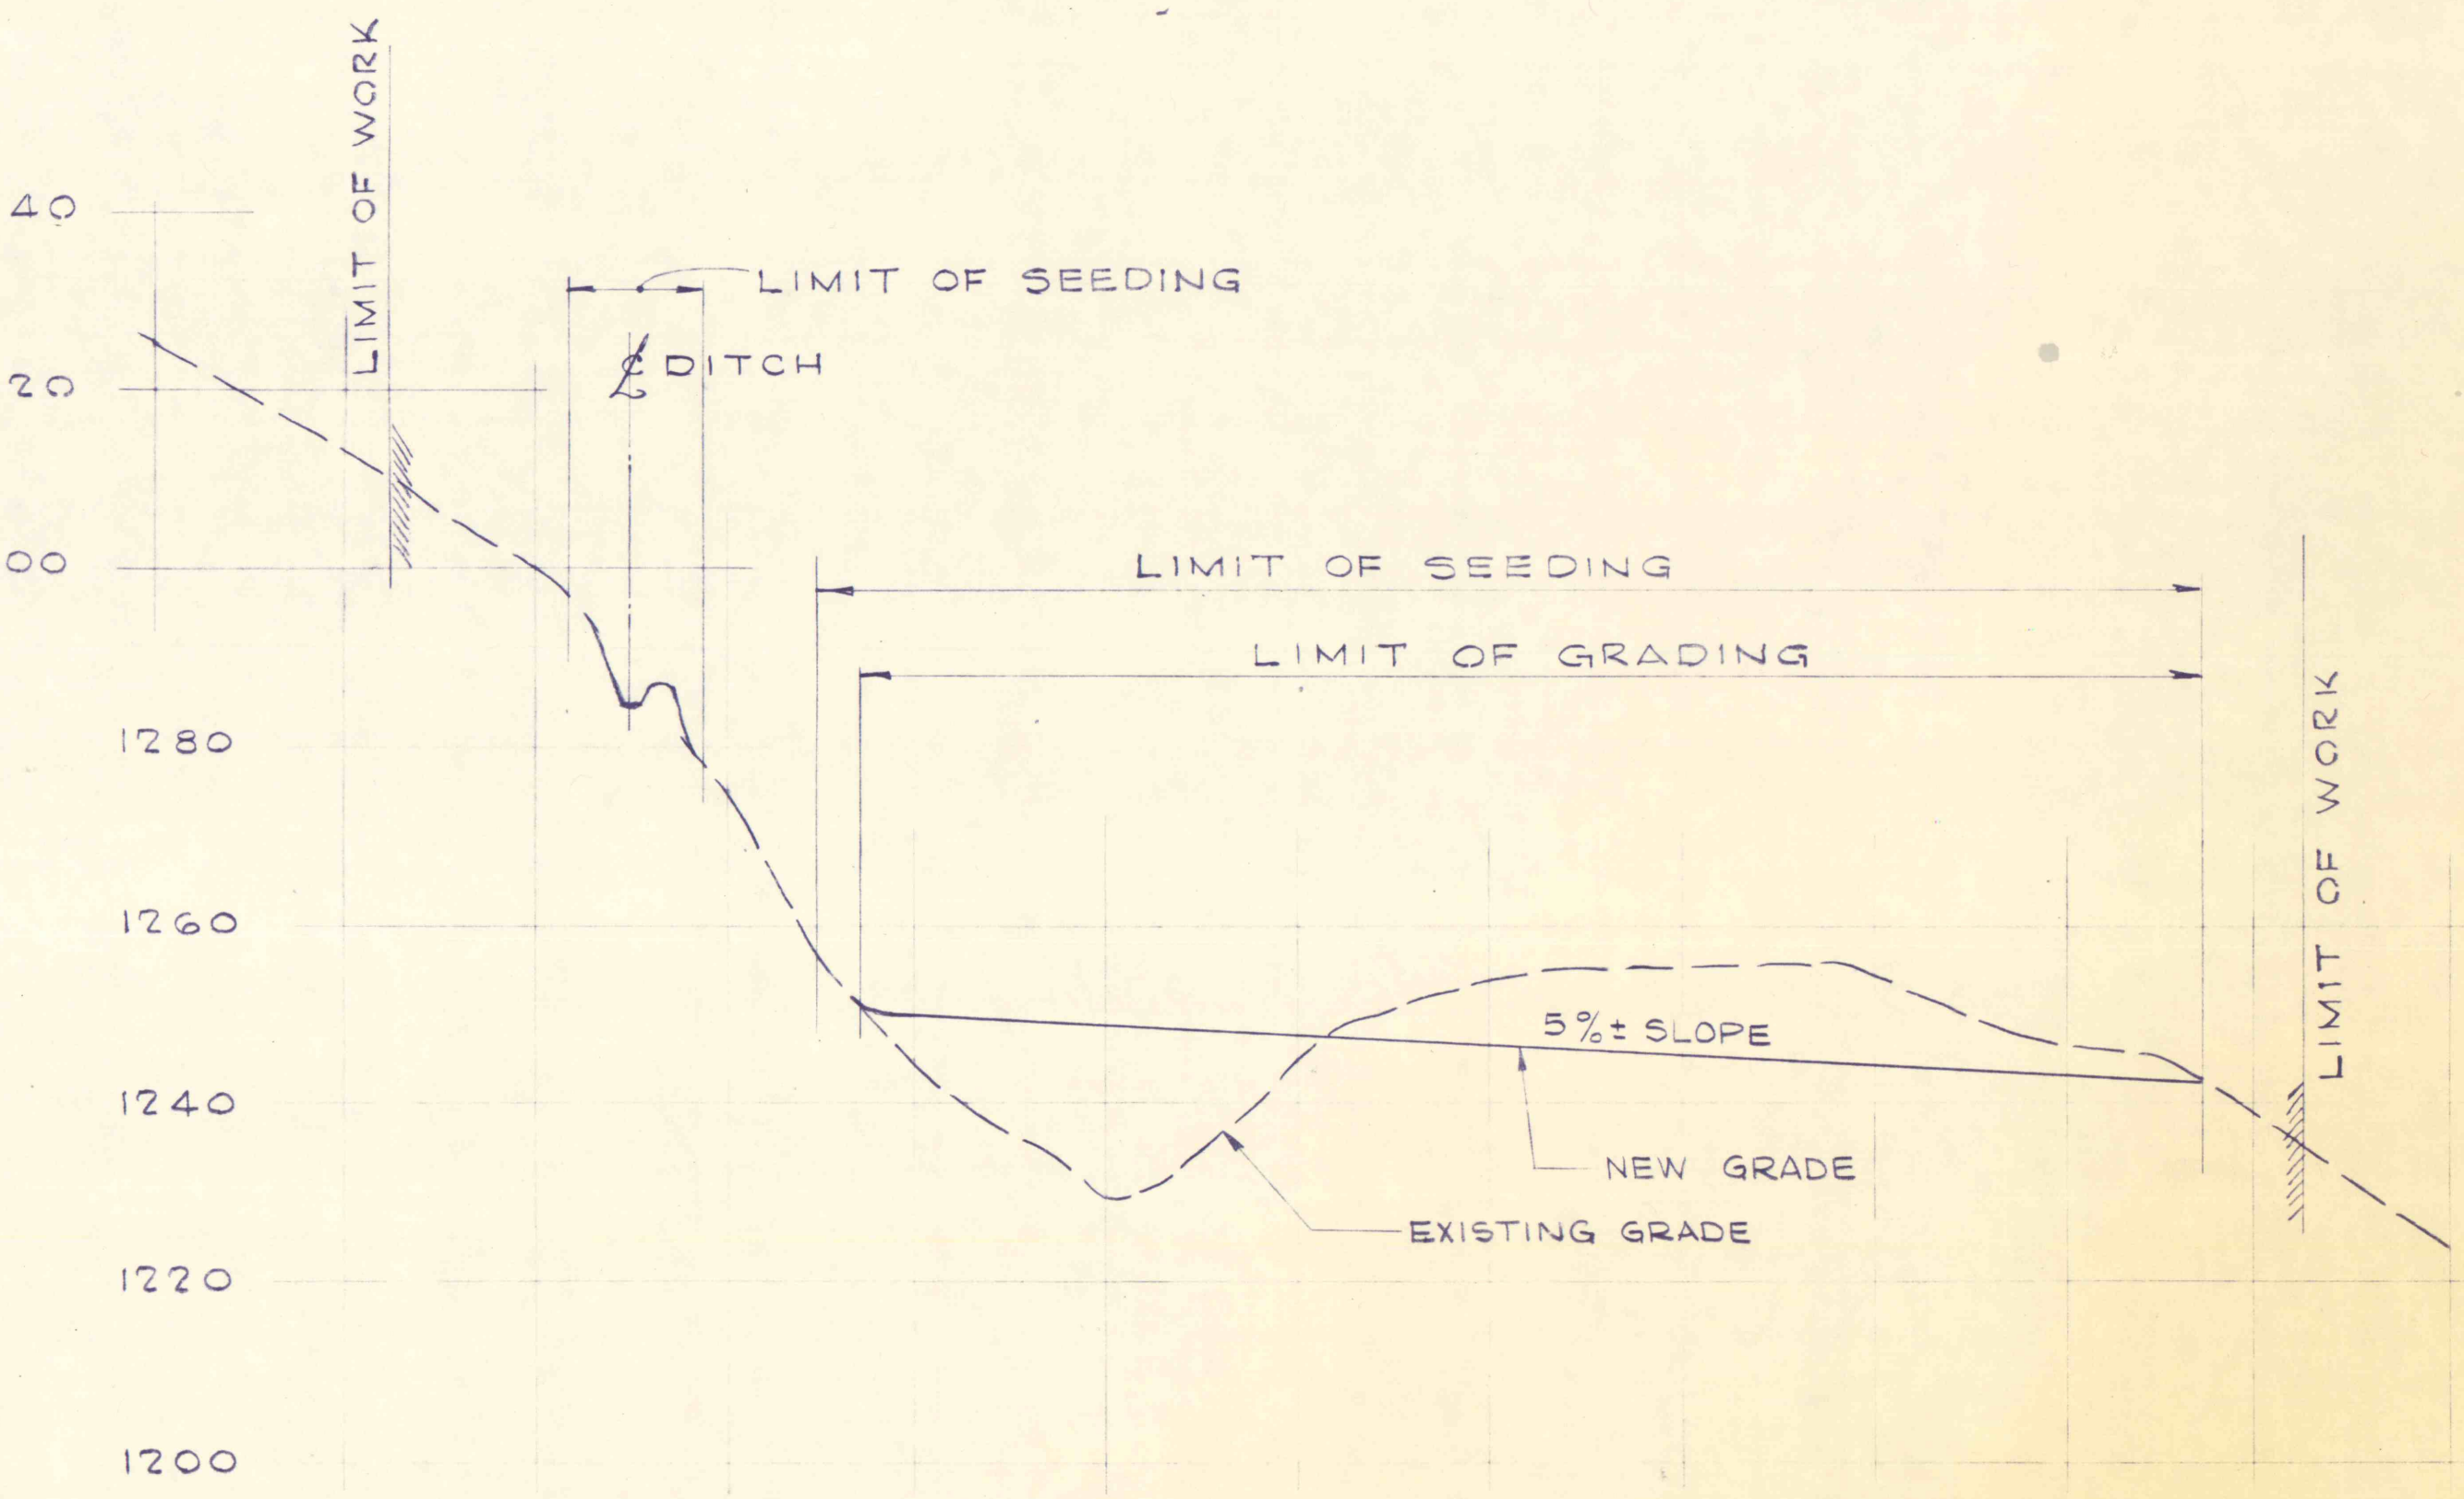

CROSS-SECTION NO. 6
SCALE: 1"=20' (HORIZ. & VERT.)
FOR LOCATION SEE THIS DRAWING.

FOR LEGEND & NOTES SEE DWG. NO. 2			
NO.	DATE	REVISION	APPR.
32475		As built	
SUBMITTED			
 PROFESSIONAL			
APPROVED			
 CHIEF - DIVISION OF MINE DRAINAGE REHABILITATION			
APPROVED			
 DIRECTOR - BUREAU OF CONSULTING SERVICES			
COMMONWEALTH OF PENNSYLVANIA DEPARTMENT OF ENVIRONMENTAL RESOURCES OFFICE OF ENGINEERING AND CONSTRUCTION			
PROJECT NO. SL 170 STRIP MINE RECLAMATION QUICK START PROJECT "B" STATE GAME LAND NO. 264 WICONISCO CREEK WATERSHED DAUPHIN COUNTY, PENNA.			
SANDERS AND THOMAS, INC. CONSULTING ENGINEERS <small>EXECUTIVE OFFICES: POTTSTOWN, PENNSYLVANIA BRANCH OFFICES: PHILADELPHIA, PA. - LONG ISLAND, N.Y. - MIAMI, FLA. PITTSBURGH, PA. - BALTIMORE, MD. - LONG BEACH, CALIF. - WASHINGTON, D.C.</small>			
PLAN & CROSS-SECTIONS NOS. 5 & 6			
DRAWN BY	DATE	DRAWING NO.	
TZ	MAY 4, 1973	4 of 7	
CHECKED BY	SCALE		
TB	AS NOTED		