


PROJECT LOCATION MAP
SCALE: NONE

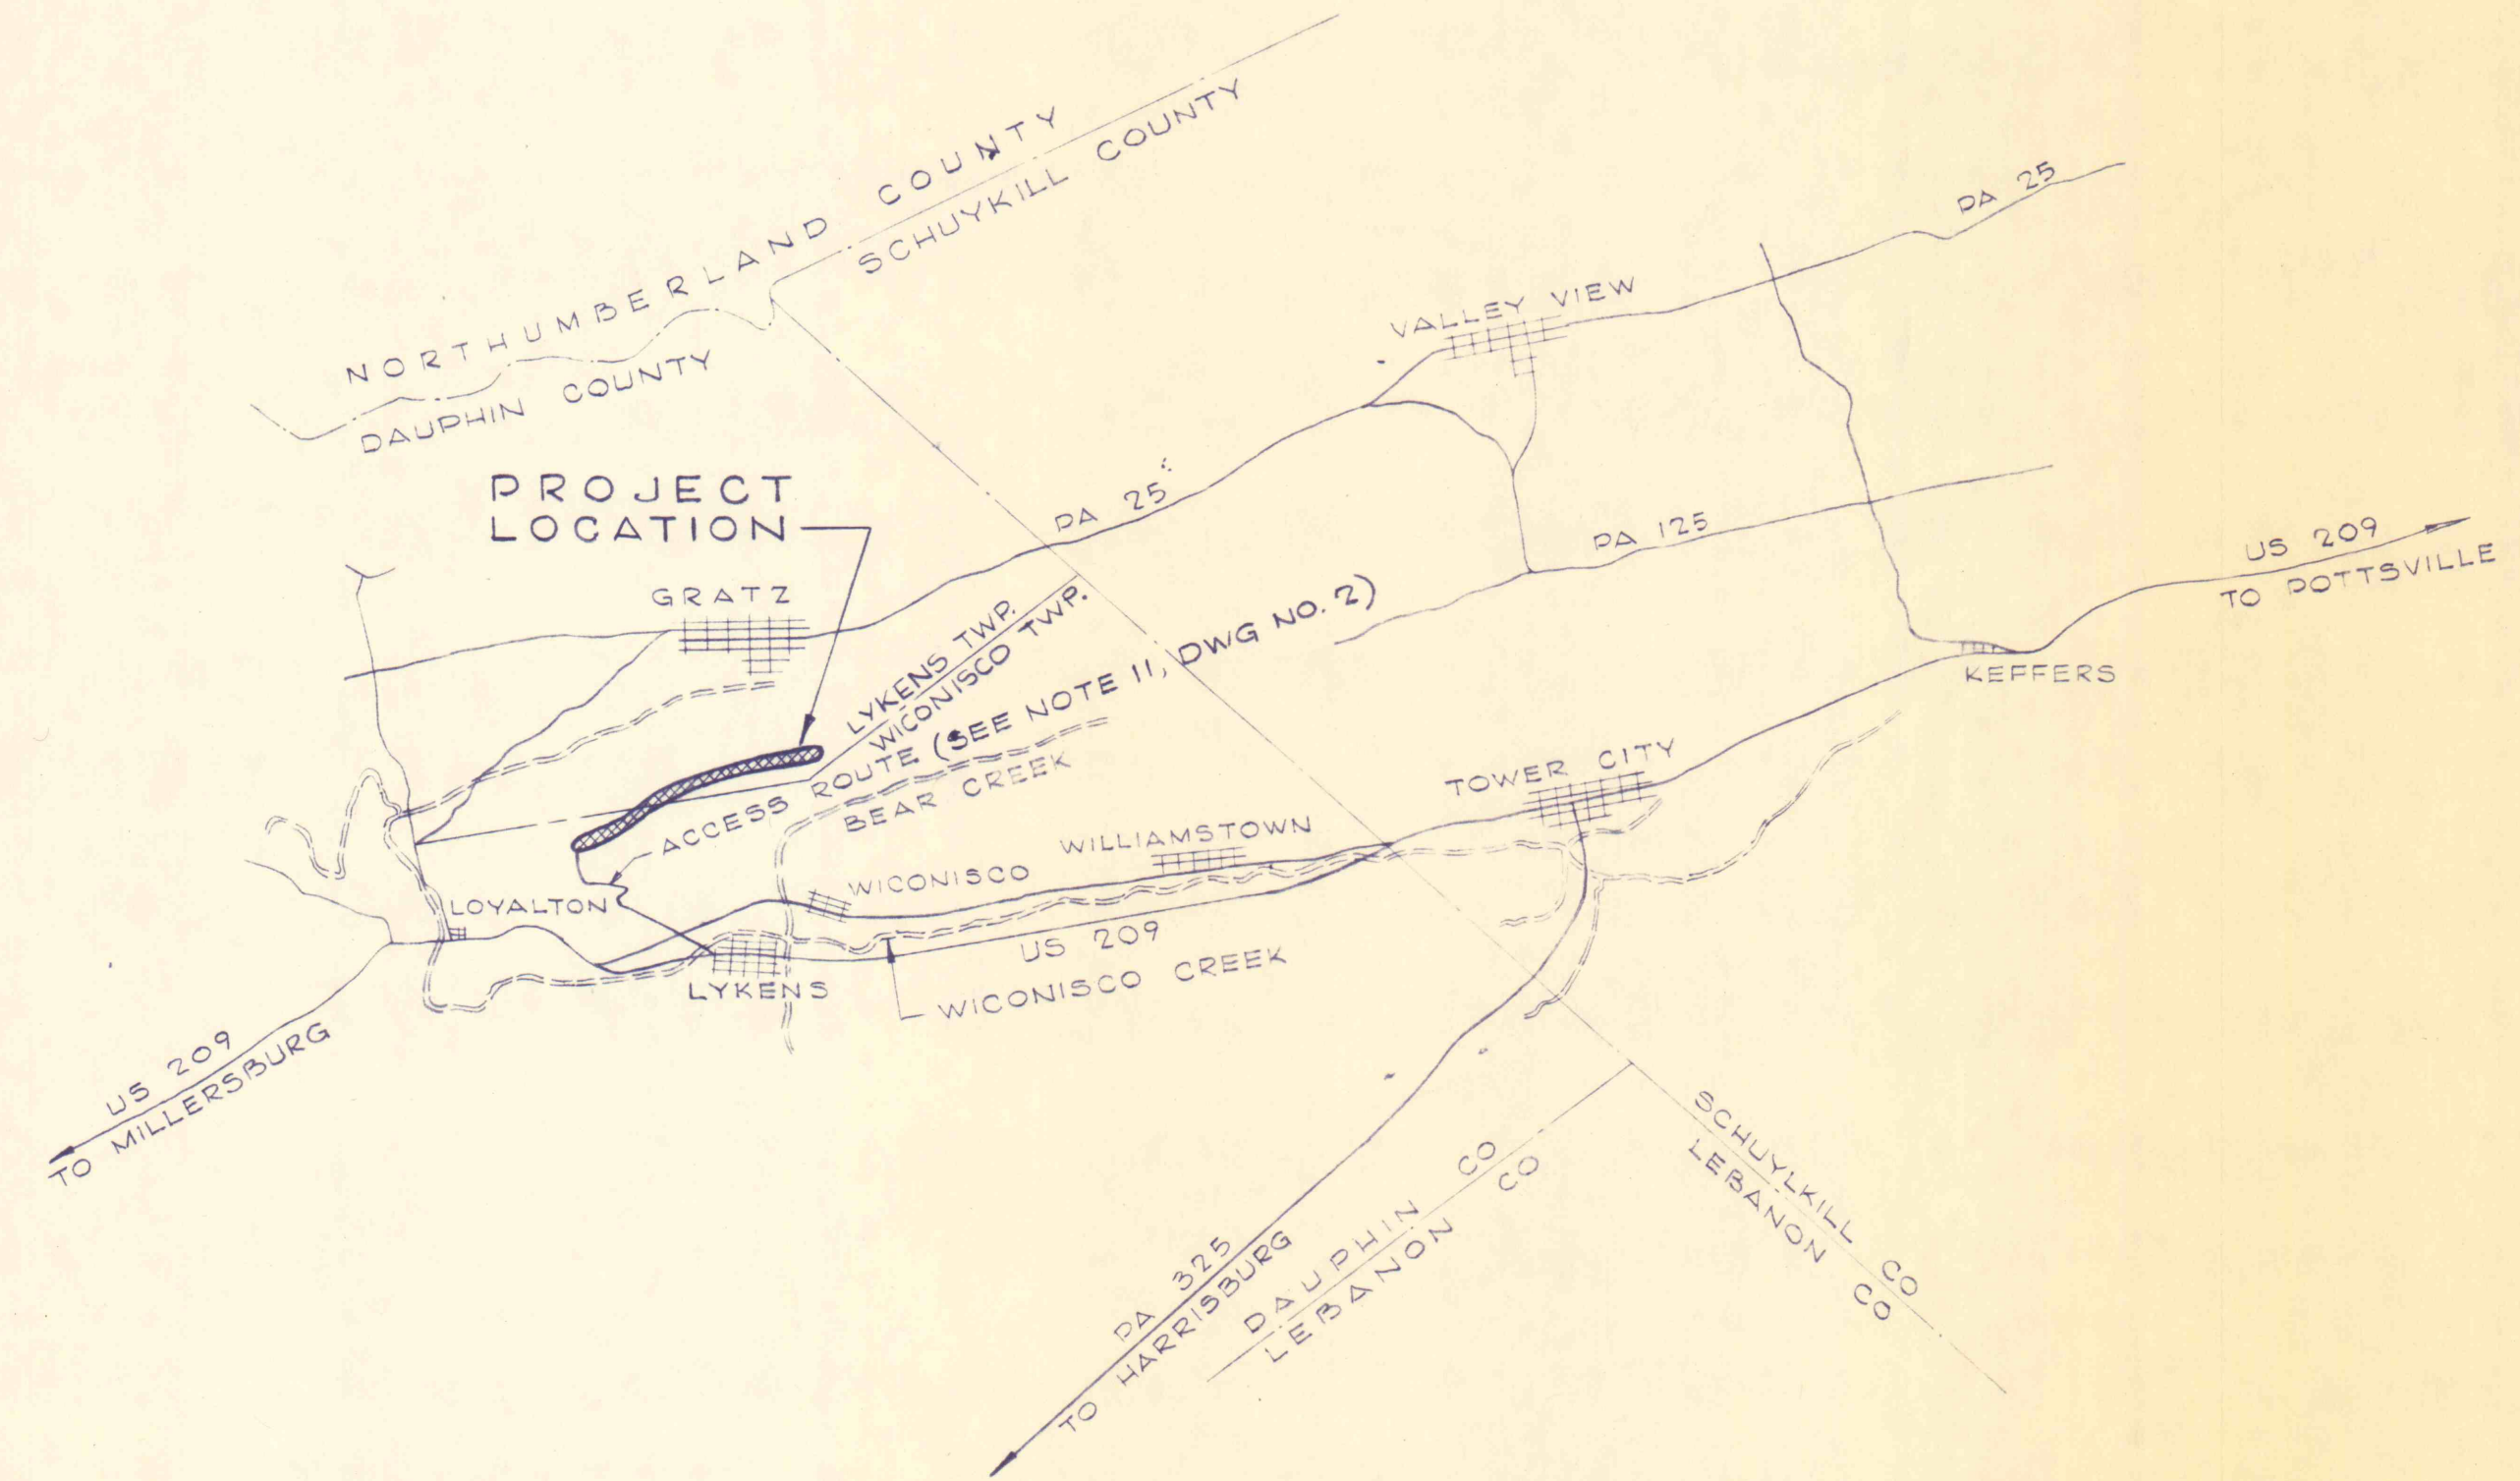

VICINITY MAP
SCALE: 1"=10,000'

FOR LEGEND & NOTES SEE DRAWING NO. 2

NO.	DATE	REVISION	APP.
1	24 Sept 73	As built	
SUBMITTED <i>Thomas Richard Babatz</i> PROFESSIONAL			
APPROVED <i>Robert C. Roman</i> CHIEF - DIVISION OF MINE DRAINAGE REHABILITATION			
APPROVED <i>D.W. Jones</i> DIRECTOR - BUREAU OF CONSULTING SERVICES			
COMMONWEALTH OF PENNSYLVANIA DEPARTMENT OF ENVIRONMENTAL RESOURCES OFFICE OF ENGINEERING AND CONSTRUCTION			
PROJECT NO. SL 170 STRIP MINE RECLAMATION QUICK START PROJECT "B" STATE GAME LAND NO. 264 WICONISCO CREEK WATERSHED DAUPHIN COUNTY, PENNA.			
SANDERS AND THOMAS, INC. CONSULTING ENGINEERS <small>EXECUTIVE OFFICES: POTTSTOWN, PENNSYLVANIA BRANCH OFFICES: PHILADELPHIA, PA - LONG ISLAND, N.Y. - MIAMI, FLA. PITTSBURGH, PA - BALTIMORE, MD. - LONG BEACH, CALIF. - WASHINGTON D.C.</small>			
PLAN & VICINITY MAP			
DRAWN BY TZ	DATE MAY 4, 1973	DRAWING NO. 1 of 7	
CHECKED BY TB.	SCALE AS NOTED		