




Sta 10+85
Elev. 750
No Cut No Fill

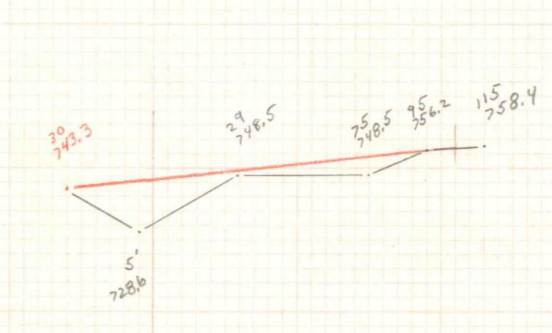


Sta 10+30
Elev. 750
Fill 751.5 cu ft. Cut 0

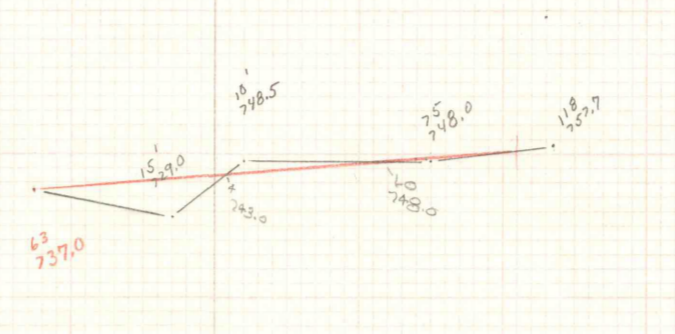


Sta 10+00
Elev. 750
Fill 412.0 cu ft. Cut 133.0 cu ft.

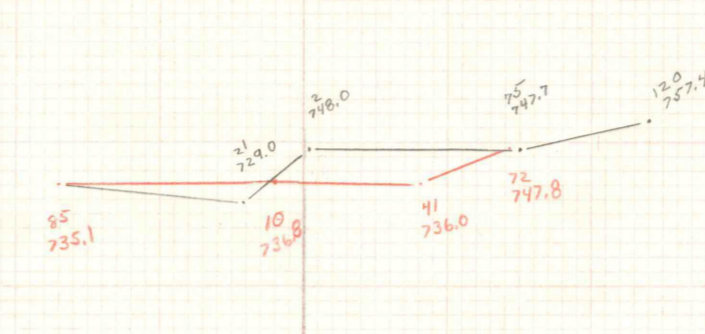


Sta 9+85
Elev. 750
Fill 288.2 cu ft. Cut 706.5 cu ft.

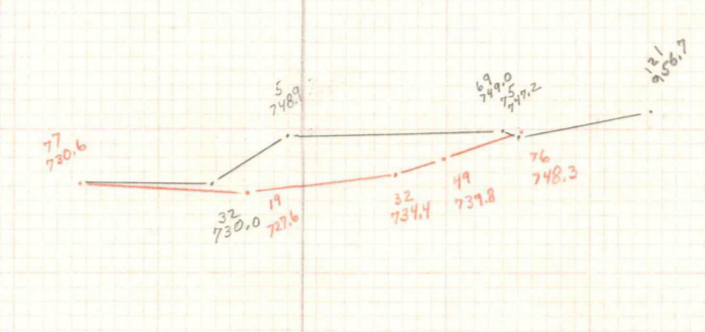


Sta 9+53
Elev. 750
Fill 0. Cut 1303.1 cu ft.

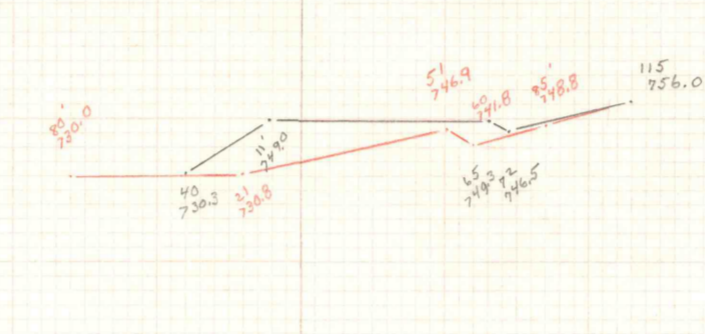


Sta 9+12
Elev. 750
Fill 0. Cut 2+3.0 cu ft.

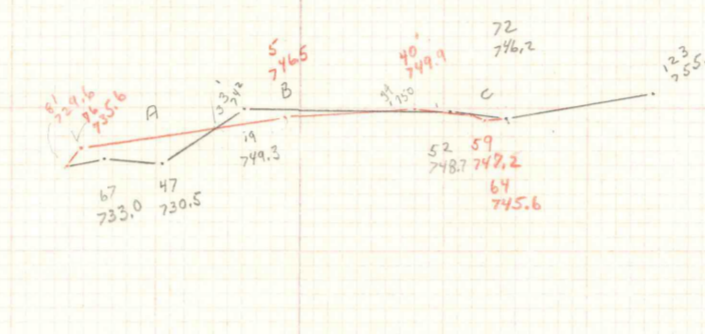


Sta 9+00
Elev. 700
Fill 0. Cut 150.6
A 14.2
B 4+5
24+5 cu ft.

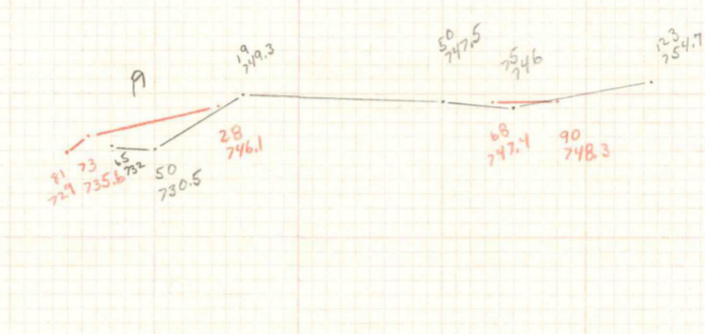


Sta 8+88
Elev. 700
Fill 0. Cut 30.8
A 22.3 sf
B 8.5
21.1 sf

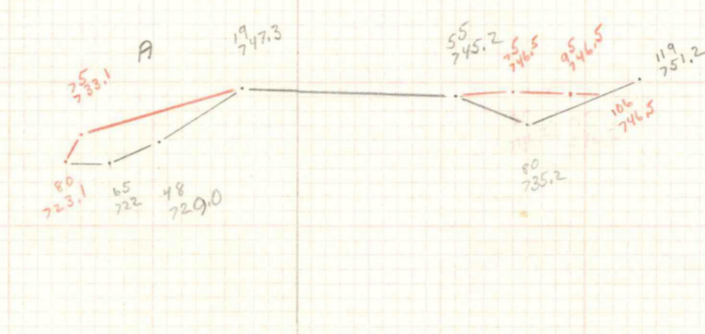


Sta 8+00
Elev. 700
Fill 0. Cut 706.0
A 51.6
B 24.4

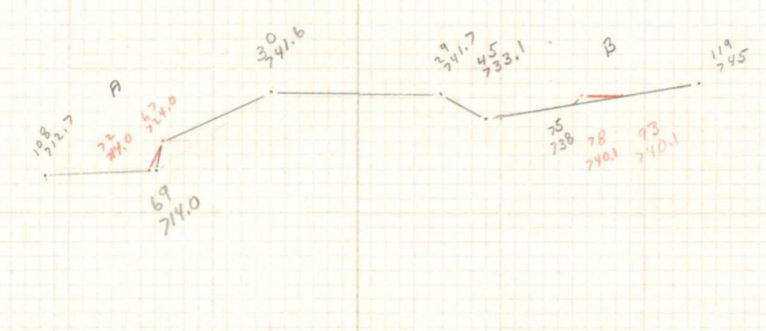


Sta 7+00
Elev. 700
Fill 0. Cut 30.8
A 15.0 sf
B 15.8

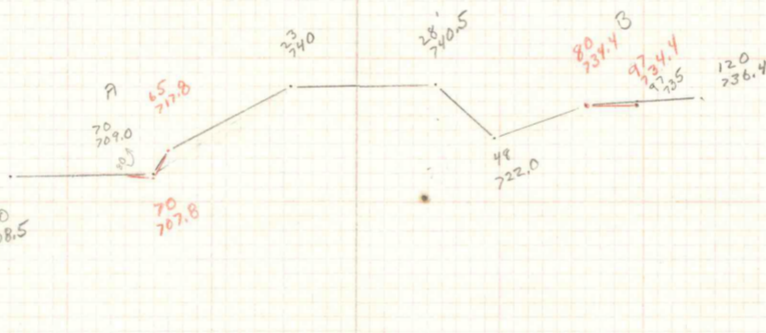


Sta 6+00
Elev. 700
Fill 0. Cut 27.6 sf
A 22.5 sf
B 5.1

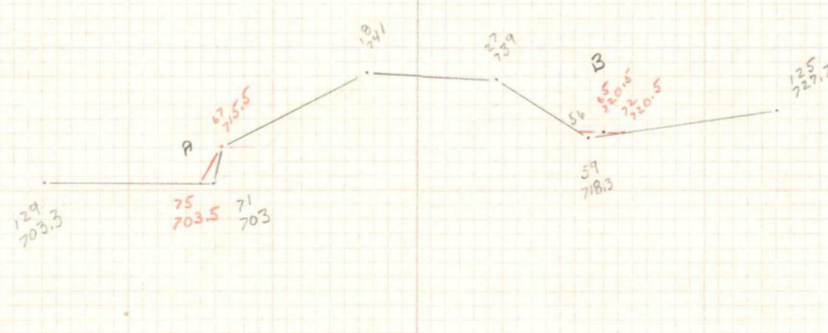


Sta 5+00
Elev. 700
Fill 0. Cut 71.6
A 44.0
B 27.6

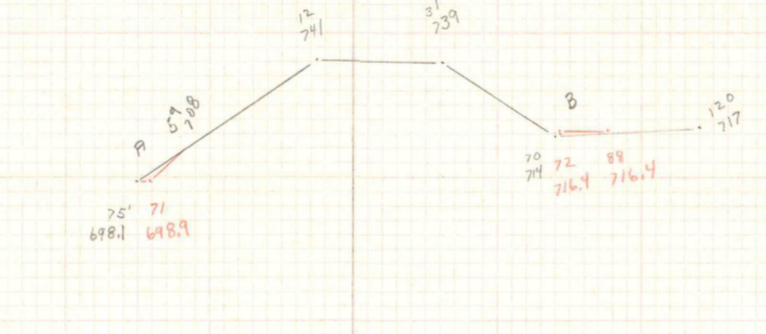


Sta 4+00
Elev. 700
Fill 0. Cut 14.2 sf
A 14.2 sf
B 13.4 sf

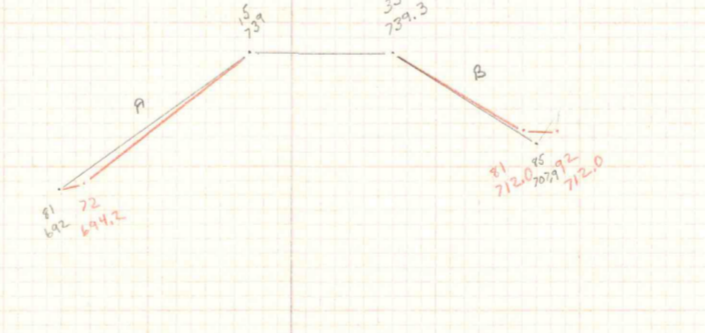


Sta 3+00
Elev. 700
Fill 0. Cut 138.7 sf
A 22.5 sf
B 116.2 sf

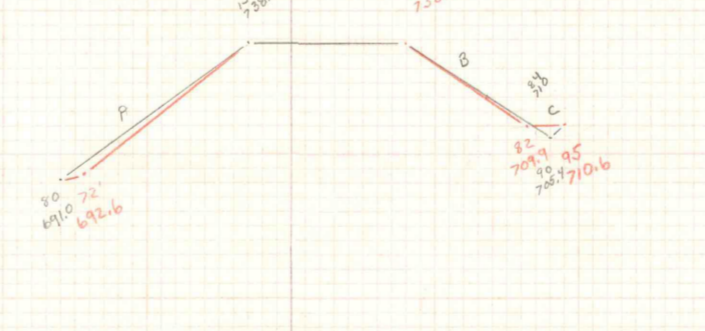

Sta 2+77
Elev. 700
Fill 0. Cut 170.6
A 27.0 sf
B 143.6

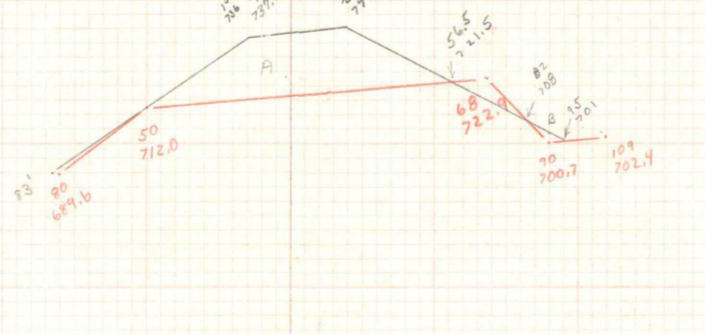


Sta 2+00
Elev. 700
Fill 0. Cut 757.1 sf
A 26.5 sf
B 730.6

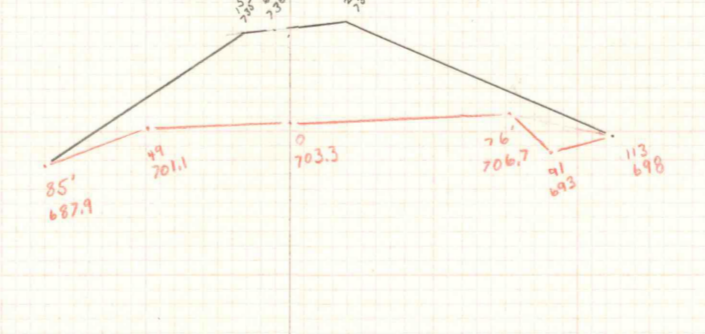


Sta 1+83
Elev. 700
Fill 0. Cut 3588.5 sf




Sta 1+38
Elev. 700
Fill 0. Cut 5485.5 sf

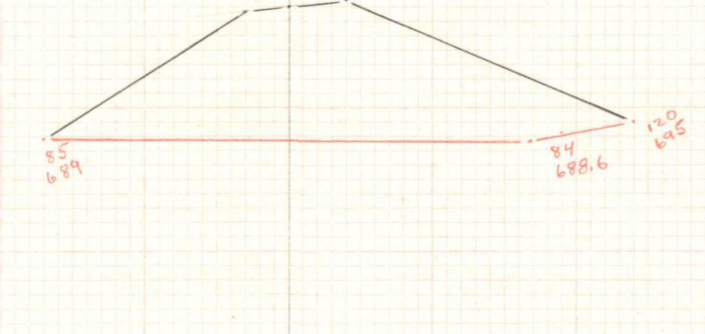


Sta 1+27
Elev. 700
Fill 0. Cut 5788.0 sf

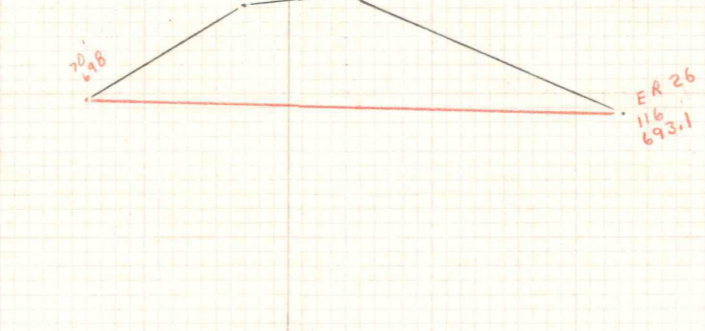

Sta 1+07
Elev. 700
Fill 0. Cut 4102.8 sf

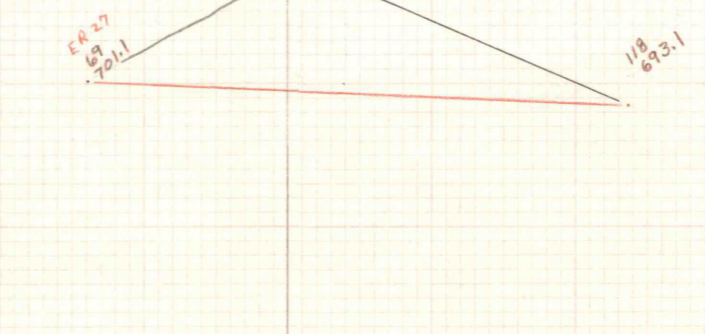

Sta 1+00
Elev. 700
Fill 0. Cut 3724.9 sf

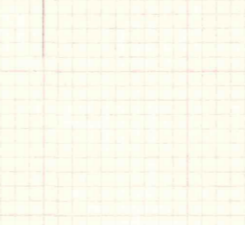

Sta 0+00
Elev. 700
No Cut No Fill
0
0
AD 81-1
Hanover, Ga. Road Five
Scale 1" = 50' FT
Name of Vert. C.
R/S 10-1-81
Red = As Built
Black = Prior to Construction