




New Courty Vⁿ Roof +460'
Big Rail +621'

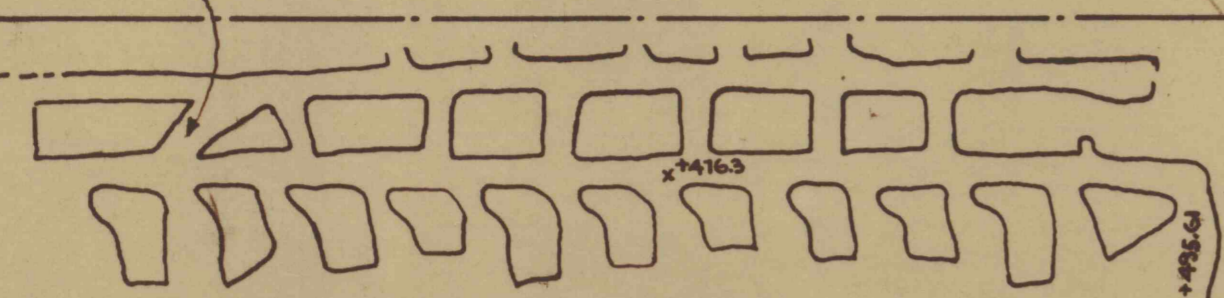


ROBINSON

EARL AND GRIFFIN

KELSEY

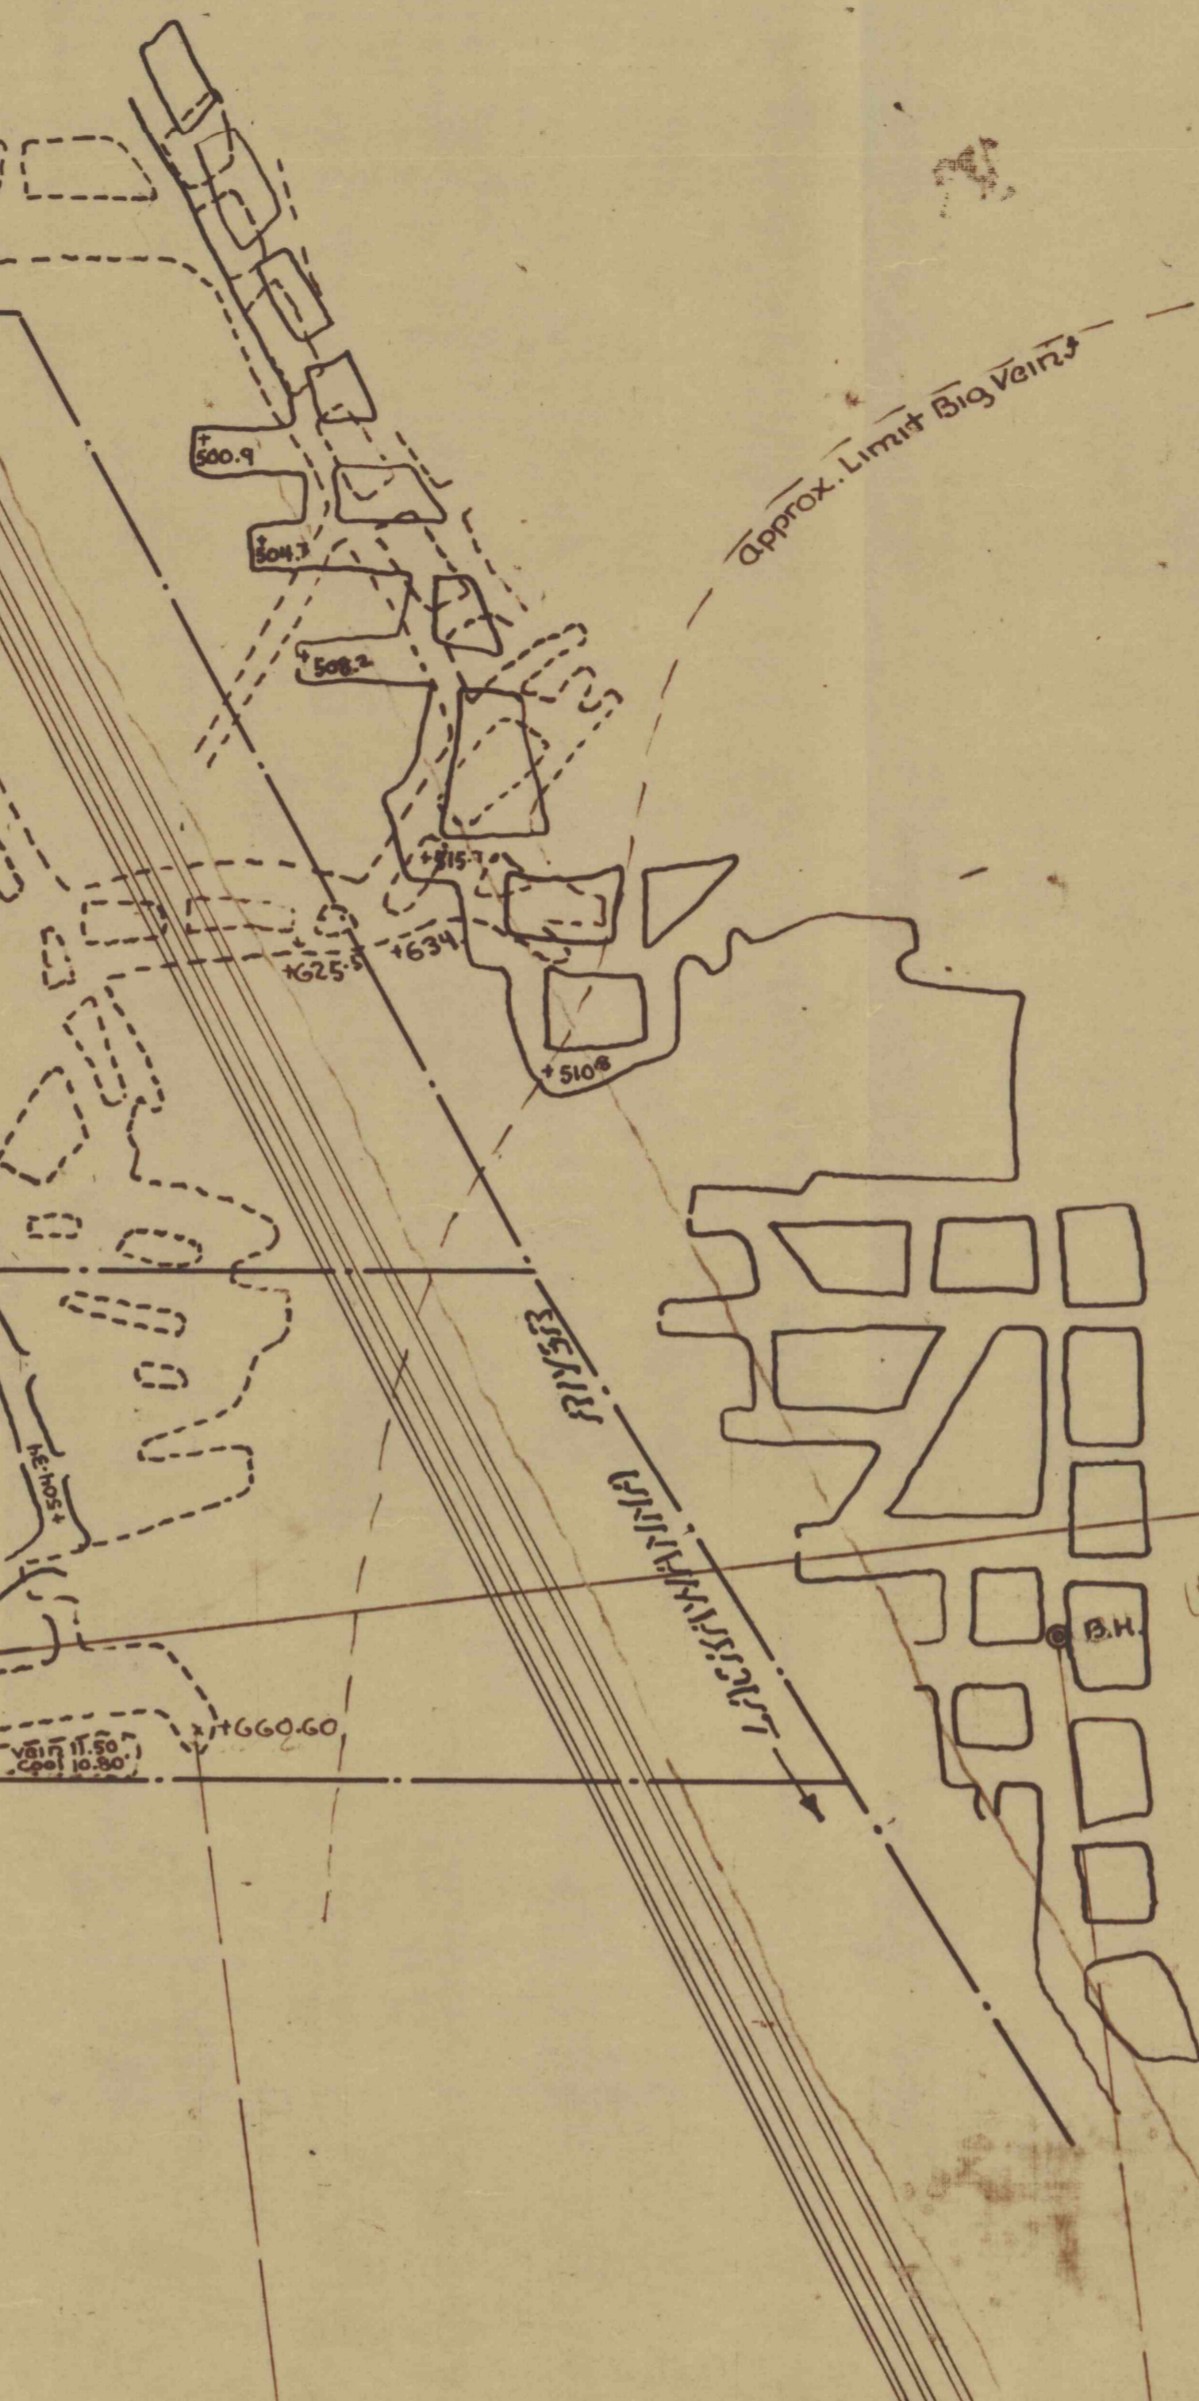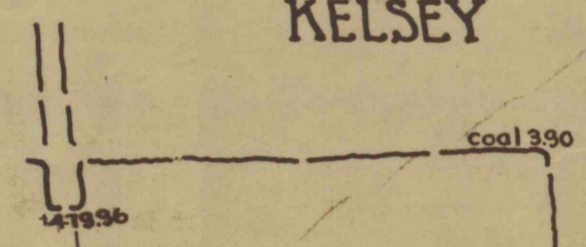

Approx. Limit Big Vein

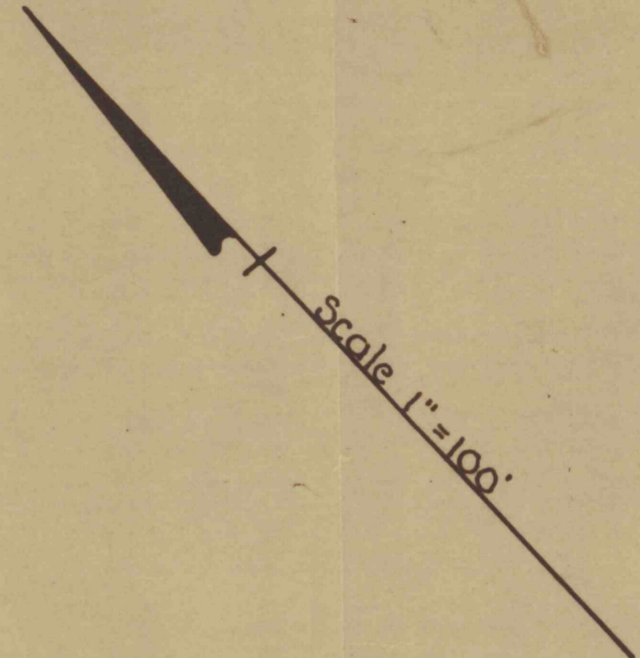

Dotted Red Lines Indicate B16 Vein Workings.
Solid Black Lines " NEW COUNTY "

Scale 1"=100'

Handwritten notes:
Under 95' 8" K
Rock 27' 3" 7' 4"
TCV 3' 1"
C 1' 3"
A 6"
B 4"
C 7"
3' 1"

CROSS SECTION ALONG LINE A-B
Hor. Scales 1"=100'

