


LOCATION MAP  
NOT TO SCALE

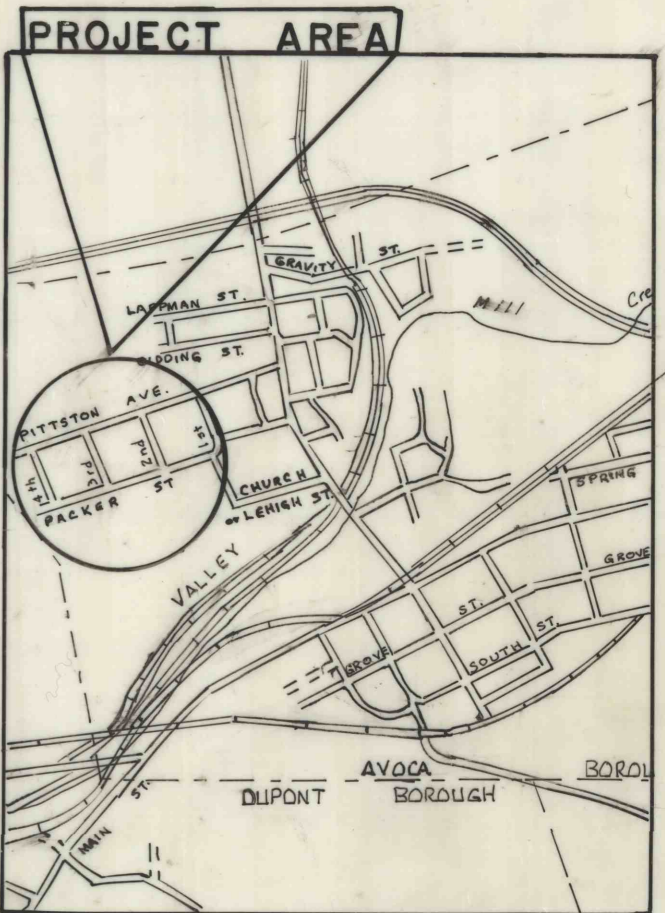

SITE PLAN  
NOT TO SCALE

NO.	DATE	REVISION	APPR.
12-19	1978	AS-BUILT DRAWING	SPY

SUBMITTED *Stephen P. Yancheck P.E.*  
DISTRICT OPERATIONS SUPERVISOR

APPROVED \_\_\_\_\_  
APPROVED \_\_\_\_\_



COMMONWEALTH OF PENNSYLVANIA  
DEPARTMENT OF ENVIRONMENTAL RESOURCES  
OFFICE OF RESOURCES MANAGEMENT

**PROJECT SL-465-101.5**  
**CORE BORING SUB-SURFACE INVESTIGATION**  
**AVOCA BOROUGH**  
**LUZERNE COUNTY, PENNA.**  
**HEIDELBERG COLLIERY SURFACE**

DRAWN BY	DATE	DRAWING NO.
CHECKED BY	SCALE	1.1

— WATER LINE  
- - - GAS LINE  
**PENNSYLVANIA GAS & WATER COMPANY**  
39 PUBLIC SQUARE  
WILKES - BARRE, PENNSYLVANIA 18701

© INVESTIGATION BOREHOLE  
**SCALE: 1" = 100'**