




12-19	AS-BUILT DRAWING	SPJ
NO. DATE	REVISION	APPR.

SUBMITTED Stephen P. Yanchek P.E.

APPROVED \_\_\_\_\_

APPROVED \_\_\_\_\_

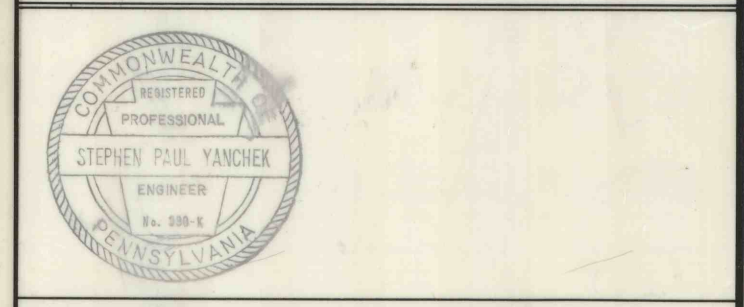

COMMONWEALTH OF PENNSYLVANIA  
DEPARTMENT OF ENVIRONMENTAL RESOURCES  
OFFICE OF RESOURCES MANAGEMENT

**PROJECT SL-46 -101.5**  
**CORE BORING SUB-SURFACE INVESTIGATION**  
**AVOCA BOROUGH**  
**LUZERNE COUNTY, PENNA.**  
**HEIDELBERG COLLIERY**  
**CLARK VEIN**

DRAWN BY	DATE	DRAWING NO.
CHECKED BY	SCALE	1.2

INVESTIGATION  
BOREHOLE