


LOCATION MAP  
NO SCALE

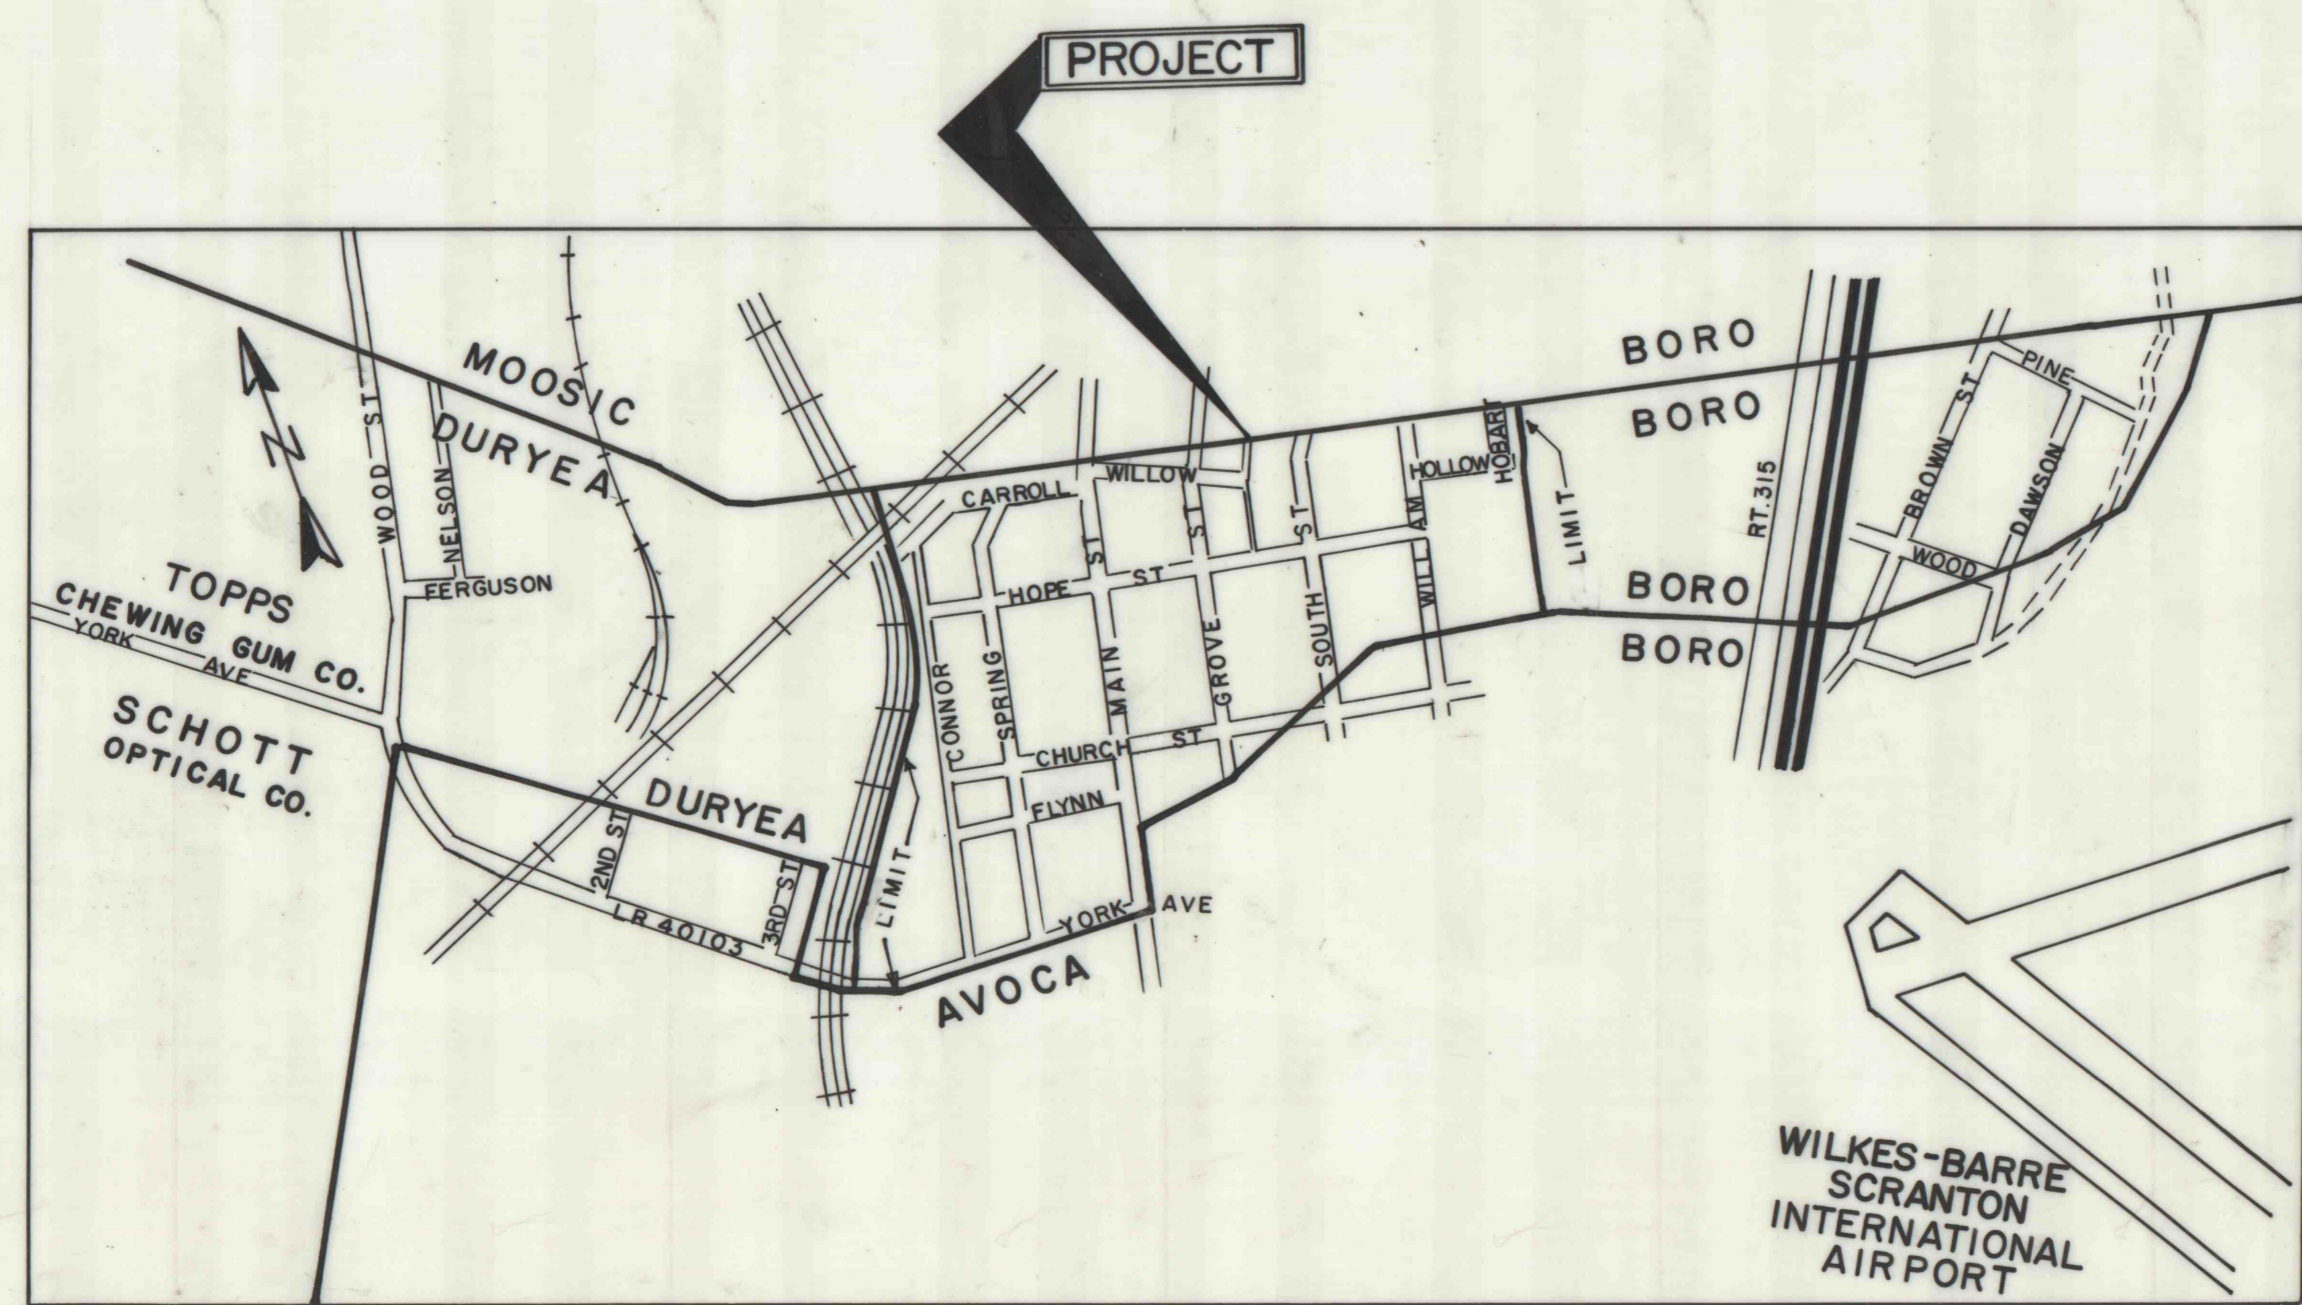

SITE PLAN  
SCALE: 1"=666'

2/24/82 AS DRILLED			
NO.	DATE	REVISION	APPR.
SUBMITTED	<i>Stephen P. Zarnoch P.E.</i>		
APPROVED	<i>Andrew E. Friedrich</i>		
APPROVED	<i>V.M. Brand</i>		
AS BUILT PLAN			
COMMONWEALTH OF PENNSYLVANIA DEPARTMENT OF ENVIRONMENTAL RESOURCES OFFICE OF RESOURCES MANAGEMENT			
PROJECT NO. SL 484-101.5			
DRILLING EXPLORATORY BOREHOLES DURYEA BOROUGH LUZERNE COUNTY, PENNSYLVANIA			
LANGCLIFFE COLLIERY SURFACE MAP-AREA 2			
DRAWN BY	DATE	DRAWING NO.	
CHECKED BY	SCALE 1"=100'	1.1B	