



SITE PLAN
SCALE: 1" = 666'

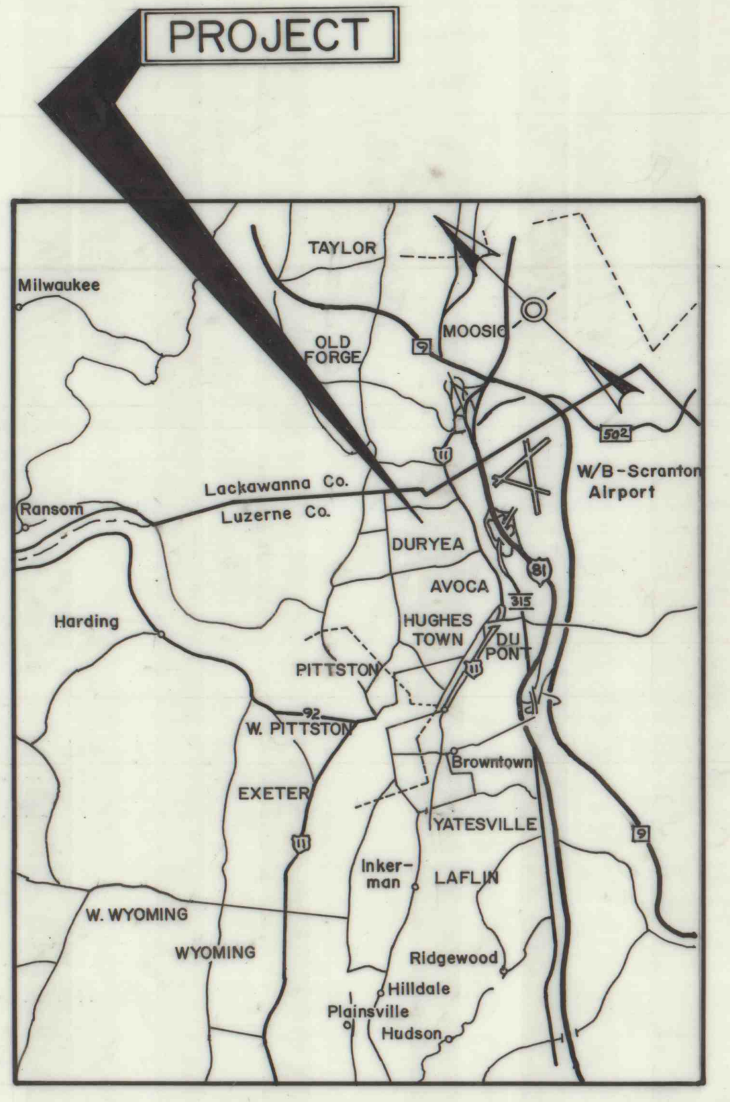

LOCATION MAP
NO SCALE

AS BUILT PLAN			
NO.	DATE	REVISION	APPR.
1	2/24/82	AS BUILT BORE HOLE	
		DELETED or RELOCATED	
SUBMITTED		<i>Stephen P. Zurechek P.E.</i>	
APPROVED		<i>Andrew C. Friedrich</i>	
APPROVED		<i>V.M. Brand</i>	

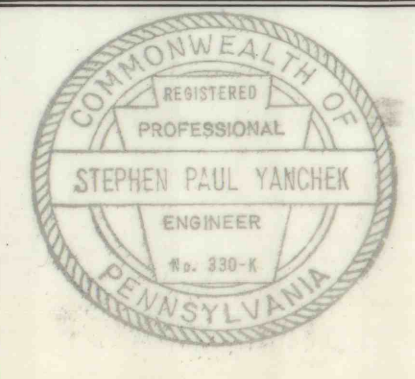

COMMONWEALTH OF PENNSYLVANIA
DEPARTMENT OF ENVIRONMENTAL RESOURCES
OFFICE OF RESOURCES MANAGEMENT

PROJECT NO. SL 484-101.5
DRILLING EXPLORATORY BOREHOLES
DURYEA BOROUGH
LUZERNE COUNTY, PENNSYLVANIA

NO.9- BARNUM-SENECA-HALLSTEAD
COLLIERIES
SURFACE MAP-AREA I

DRAWN BY	DATE	DRAWING NO.
CHECKED BY	SCALE 1" = 100'	1.1