


TRAVERSE DATA

Traverse Station	Coordinates North	Coordinates East
19+67.45B	10,622.662	7,891.509
23+61.35B	10,771.206	8,256.317
26+06.70B	10,797.666	8,500.235
28+20.29B	10,705.794	8,693.062
10+00.00B	10,482.378	8,732.935

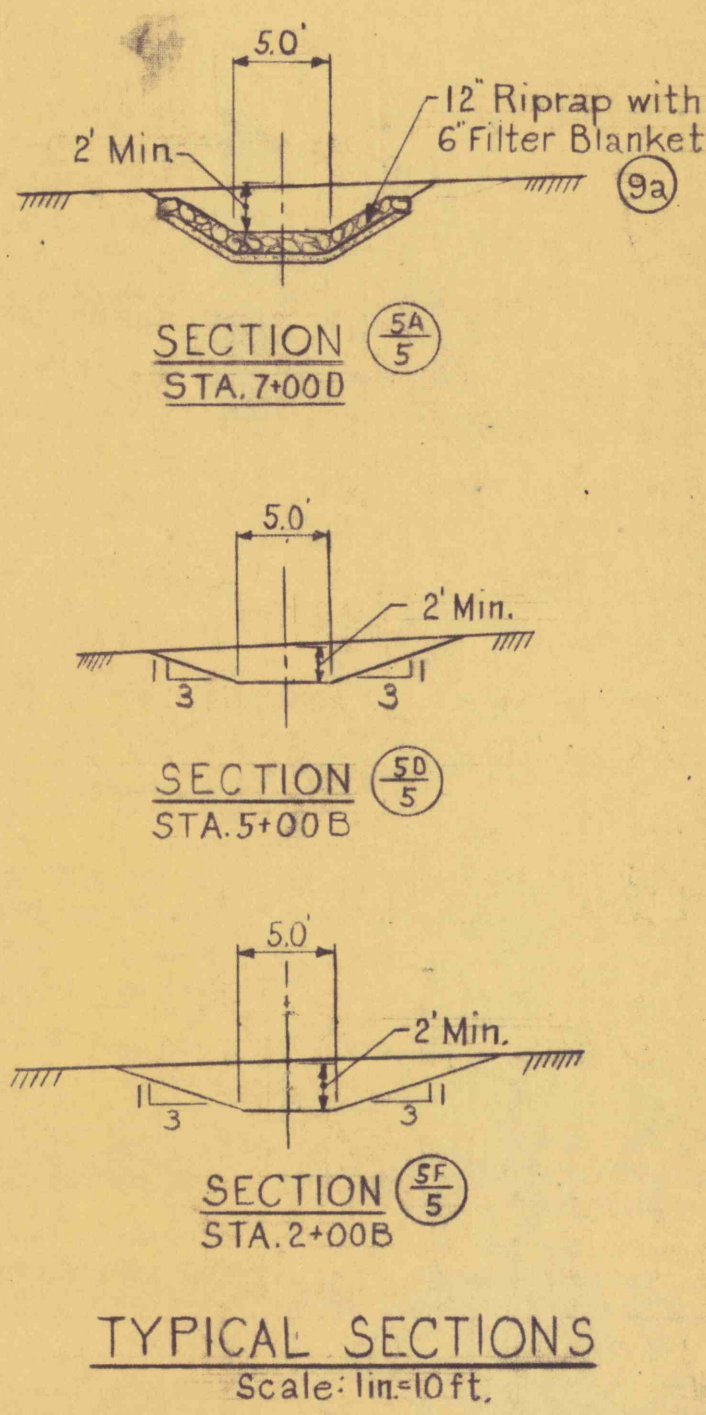

PLAN
Scale: 1in=30ft.

- NOTES:**
1. (N) Indicates payment items.
 2. Refer to Dwg. No. 1.3 for details of Embankment and Dwg. No. 1.7 for details of Drop Structure, rock barriers and overflow.
 3. The Engineer will determine the exact location of stream at the site.

NO.	DATE	REVISION	APPR.
102178		As built	
SUBMITTED		P. Gupta	
APPROVED		[Signature]	
APPROVED		[Signature]	



COMMONWEALTH OF PENNSYLVANIA
DEPARTMENT OF ENVIRONMENTAL RESOURCES
OFFICE OF RESOURCES MANAGEMENT

PROJECT NO. G40:5-101.1
DRAINAGE IMPROVEMENTS TO LARKSVILLE FLUME

LUZERNE CO. PENNSYLVANIA
DRAINAGE DITCHES PLAN AND SECTIONS