


LEGEND FOR CROSS SECTIONS
(N.T.S.)

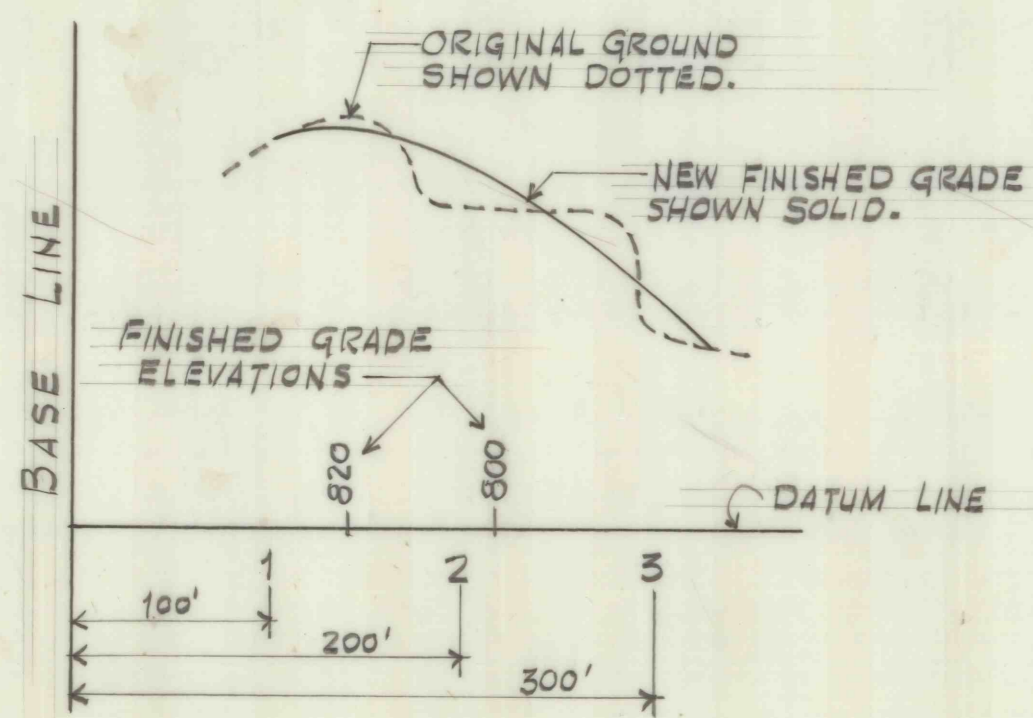

NOTES:

- FOR THE LOCATION OF THE CROSS SECTION, BASE LINE SEE DRAWINGS NO. 3 & 4.
- ALL ELEVATIONS SHOWN ARE FINISHED GRADE ELEVATIONS.

CROSS SECTIONS STATIONS 1+00 THROUGH 4+00

SCALE — HORIZONTAL 1" = 100'
VERTICAL 1" = 50'

Note: These sections not revised to show As Built contours. For As Built contours, see new plan Dwg. No. A1 of 3 thru A3 of 3.

NO. 10-185	As built	REVISION	APPR. <i>[Signature]</i>	CONTRACT NO. ASMR-18
SUBMITTED				STRIP MINE RESTORATION
PROFESSIONAL <i>[Signature]</i>				SOLOMON CREEK WATERSHED
APPROVED <i>[Signature]</i>				WILKES-BARRE TWP. LUZERNE CO., PA.
CHIEF - DIVISION OF MINE RECLAMATION				LACY, ATHERTON & DAVIS
APPROVED <i>[Signature]</i>				ARCHITECTS & ENGINEERS
DIRECTOR - BUREAU OF DESIGN				WILKES-BARRE HARRISBURG WILLIAMSPORT
			(Seal)	SITE CROSS SECTIONS
COMMONWEALTH OF PENNSYLVANIA				DRAWN BY
DEPARTMENT OF ENVIRONMENTAL RESOURCES				DATE 4-28-80
OFFICE OF RESOURCES MANAGEMENT				DRAWING NO. 5
				CHECKED BY
				SCALE