


LEGEND
 --- = EXISTING GRADE
 ——— = FINISHED GRADE
 (700) = EXISTING GRADE
 700 = FINISHED GRADE
 = DITCH TYPE SEE DWG. # D-1

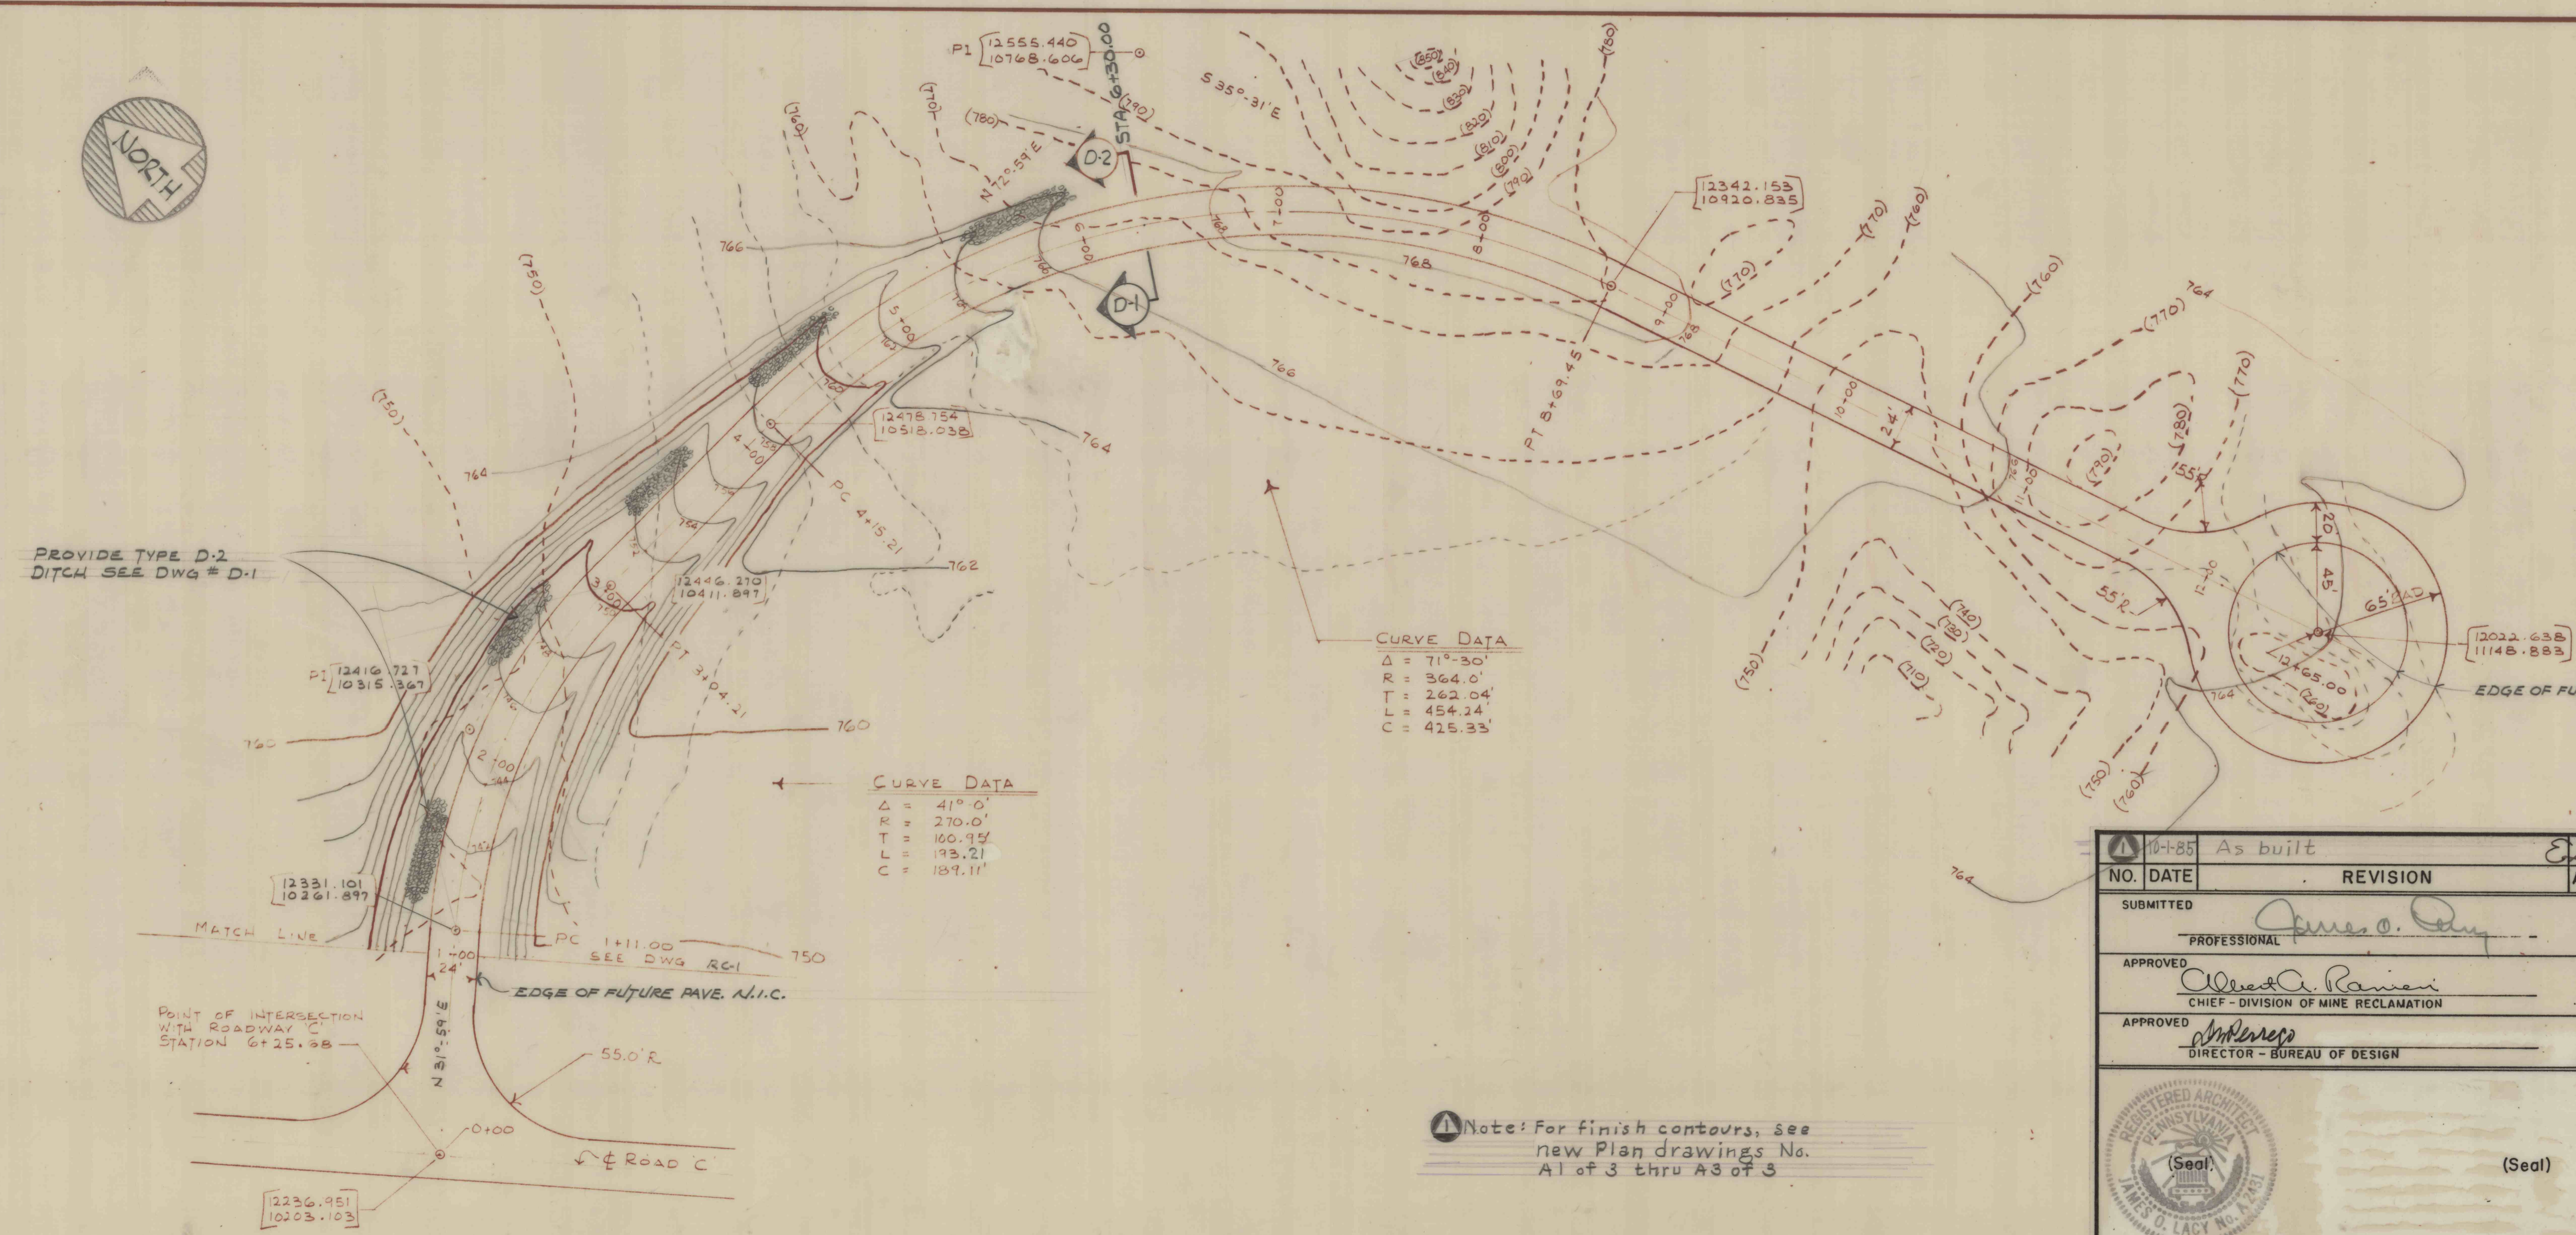

Note: For finish contours, see new Plan drawings No. A1 of 3 thru A3 of 3

NO. DATE	REVISION	CONTRACT NO. ASMR-18
10-1-85 As built		
SUBMITTED		STRIP MINE RESTORATION
PROFESSIONAL <i>James O. Day</i>		SOLOMON CREEK WATERSHED
APPROVED <i>West A. Ramey</i>		WILKES-BARRE TWP. LUZERNE CO., PA.
APPROVED <i>James O. Day</i>		LACY, ATHERTON & DAVIS
DIRECTOR - BUREAU OF DESIGN		ARCHITECTS & ENGINEERS
		WILKES-BARRE HARRISBURG WILLIAMSPORT
COMMONWEALTH OF PENNSYLVANIA		ROADWAY PLAN & PROFILE
DEPARTMENT OF ENVIRONMENTAL RESOURCES		DRAWN BY DATE 4-28-80 DRAWING NO. RD-1
OFFICE OF RESOURCES MANAGEMENT		CHECKED BY SCALE As shown