


ECKLEY MINE *Yien - ?*
 LUZERNE COUNTY
 OWNERS (SURF. & MINERAL) TENCH COXE ESTATE.
 ADDRESS - DRIFTON, PA.
 UNDER LEASE - TO JEDDO-HIGHLAND COAL CO., JEDDO, PA.
 OPERATOR - JEDDO-HIGHLAND COAL CO., JEDDO, PA.
 MINING ENGINEER - MR. G.H. HOLLAND, JEDDO, PA.
 PRESIDENT - MR. W.C. JONES, JEDDO, PA.
 SCALE 1" = 100'
 MAY 8, 1963.

LEGEND:
 ROADS:
 BANKS:
 STRIPPINGS:
 POWER LINES:

D.D.H. 461
 628.0
 S.M. 160
 631.7
 D.D.H. 462
 633.5
 D.D.H. 463
 1636.5
 D.D.H. 459
 1631.2
 D.D.H. 458
 1640.5
 D.D.H. 457
 1630.3
 D.D.H. 456
 1655.5
 D.D.H. 455
 1658.1
 D.D.H. 454
 1658.9
 D.D.H. 453
 1660.9
 D.D.H. 452
 1662.4
 D.D.H. 451
 1664.6
 D.D.H. 450
 1664.9
 D.D.H. 449
 1645.0

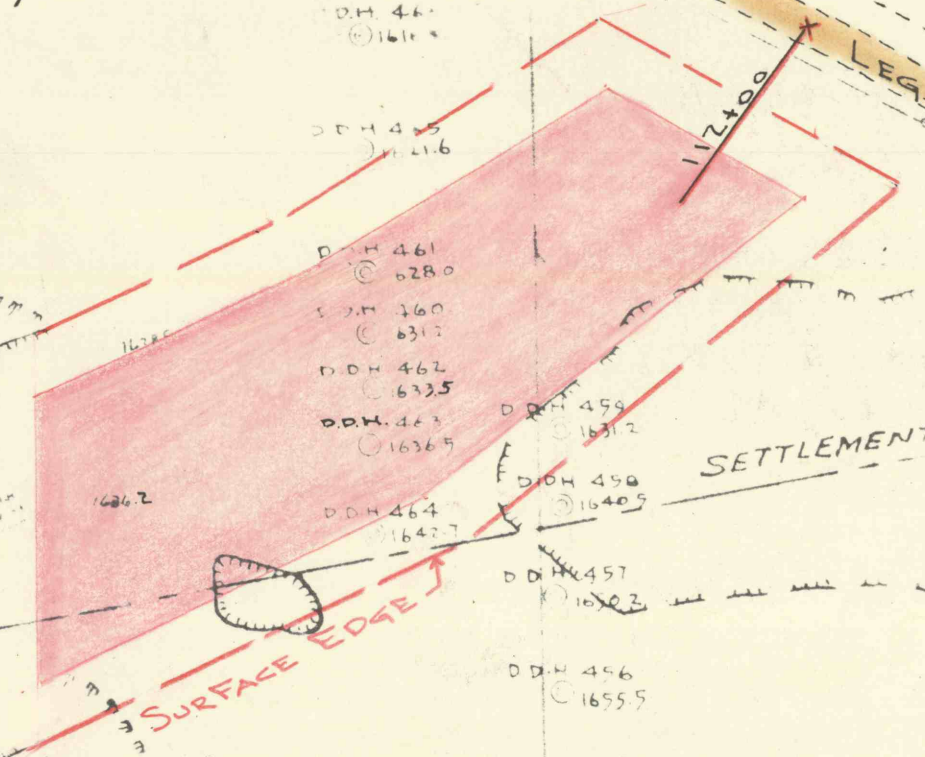

8" WATER LINE
 58000
 59000
 C.D.H. 537
 1628.3
 C.D.H. 782
 16199
 C.D.H. 781
 16324

Numerous handwritten annotations including:
 - "PROVING" (rectangle)
 - "9" PIPE" (line)
 - "199947 BOTTLER" (line)
 - "LEG. ROUTE 40006" (road)
 - "TRUCK ROAD" (road)
 - "SETTLEMENT" (red area)
 - "SURFACE EDGE" (red line)
 - "8\"/>