


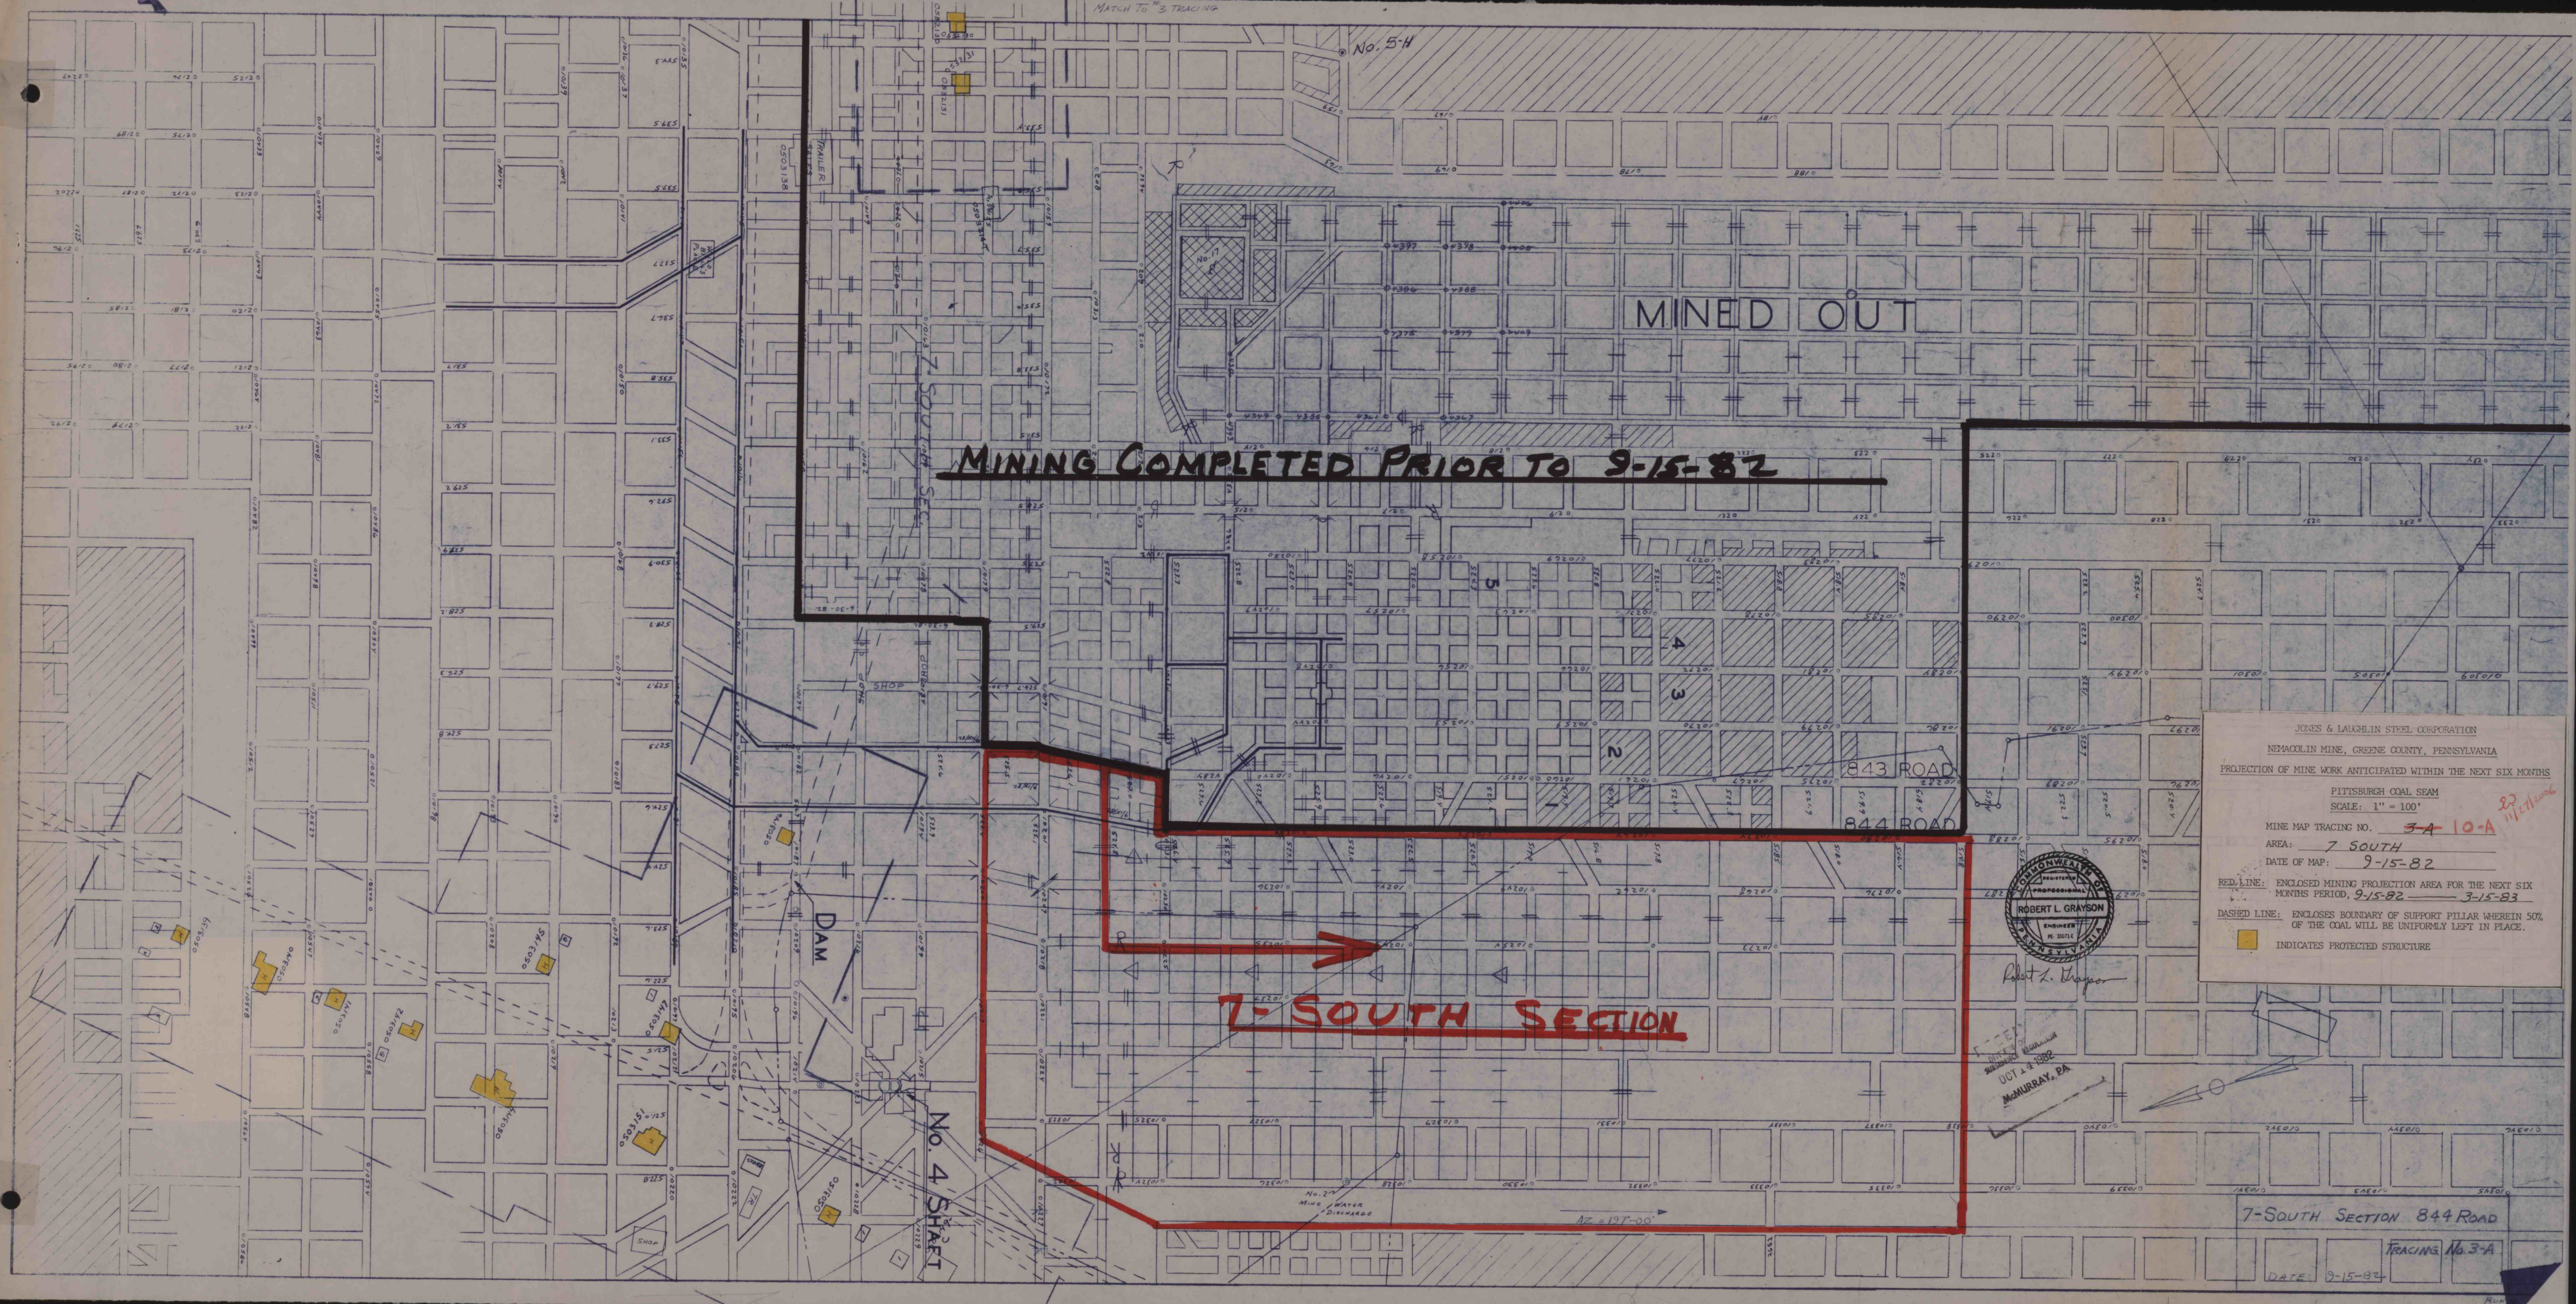

MINING COMPLETED PRIOR TO 9-15-82

MINED OUT

7-SOUTH SECTION

JONES & LAUGHLIN STEEL CORPORATION
NEPAULIN MINE, GREENE COUNTY, PENNSYLVANIA
PROJECTION OF MINE WORK ANTICIPATED WITHIN THE NEXT SIX MONTHS
PITTSBURGH COAL SEAM
SCALE: 1" = 100'
MINE MAP TRACING NO. 3-A-10-A
AREA: 7 SOUTH
DATE OF MAP: 9-15-82
RED LINE: ENCLOSED MINING PROJECTION AREA FOR THE NEXT SIX MONTHS PERIOD, 9-15-82 TO 3-15-83
DASHED LINE: ENCLOSES BOUNDARY OF SUPPORT PILLAR WHEREIN 50% OF THE COAL WILL BE UNIFORMLY LEFT IN PLACE.
INDICATES PROTECTED STRUCTURE



Robert L. Grayson

McMURRAY, PA
JUL 14 1982

7-SOUTH SECTION 844 ROAD

TRACING No. 3-A

DATE: 9-15-82