
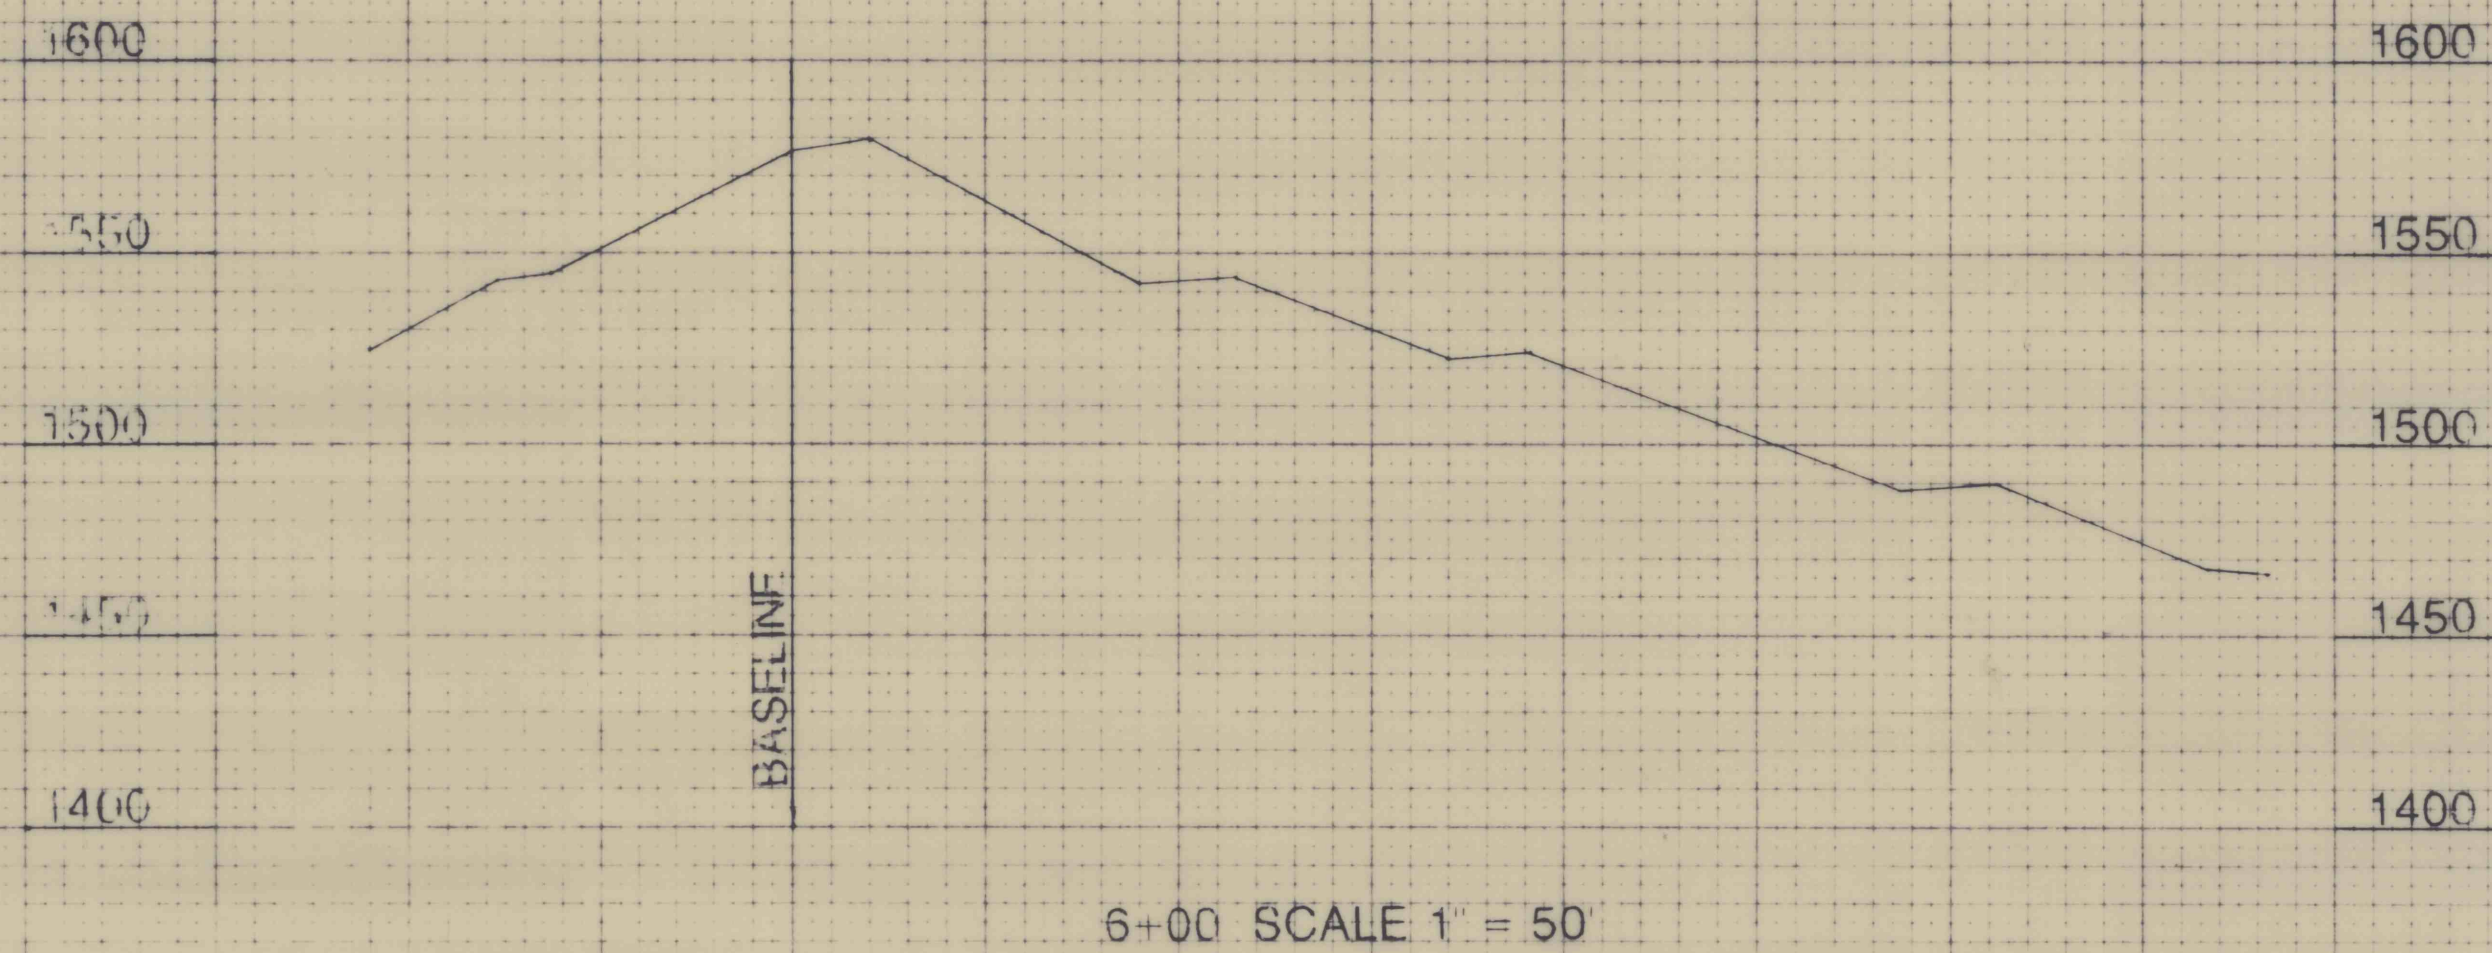


FINAL SURVEY
 SURVEYED
 PLOTTED
 ROUTE BLOCK AREA
 DATE
 BY
 AREA, LTR. SEC.

ORIGINAL SURVEY
 SURVEYED
 PLOTTED
 ROUTE BLOCK AREA
 DATE
 BY
 AREA, LTR. SEC.

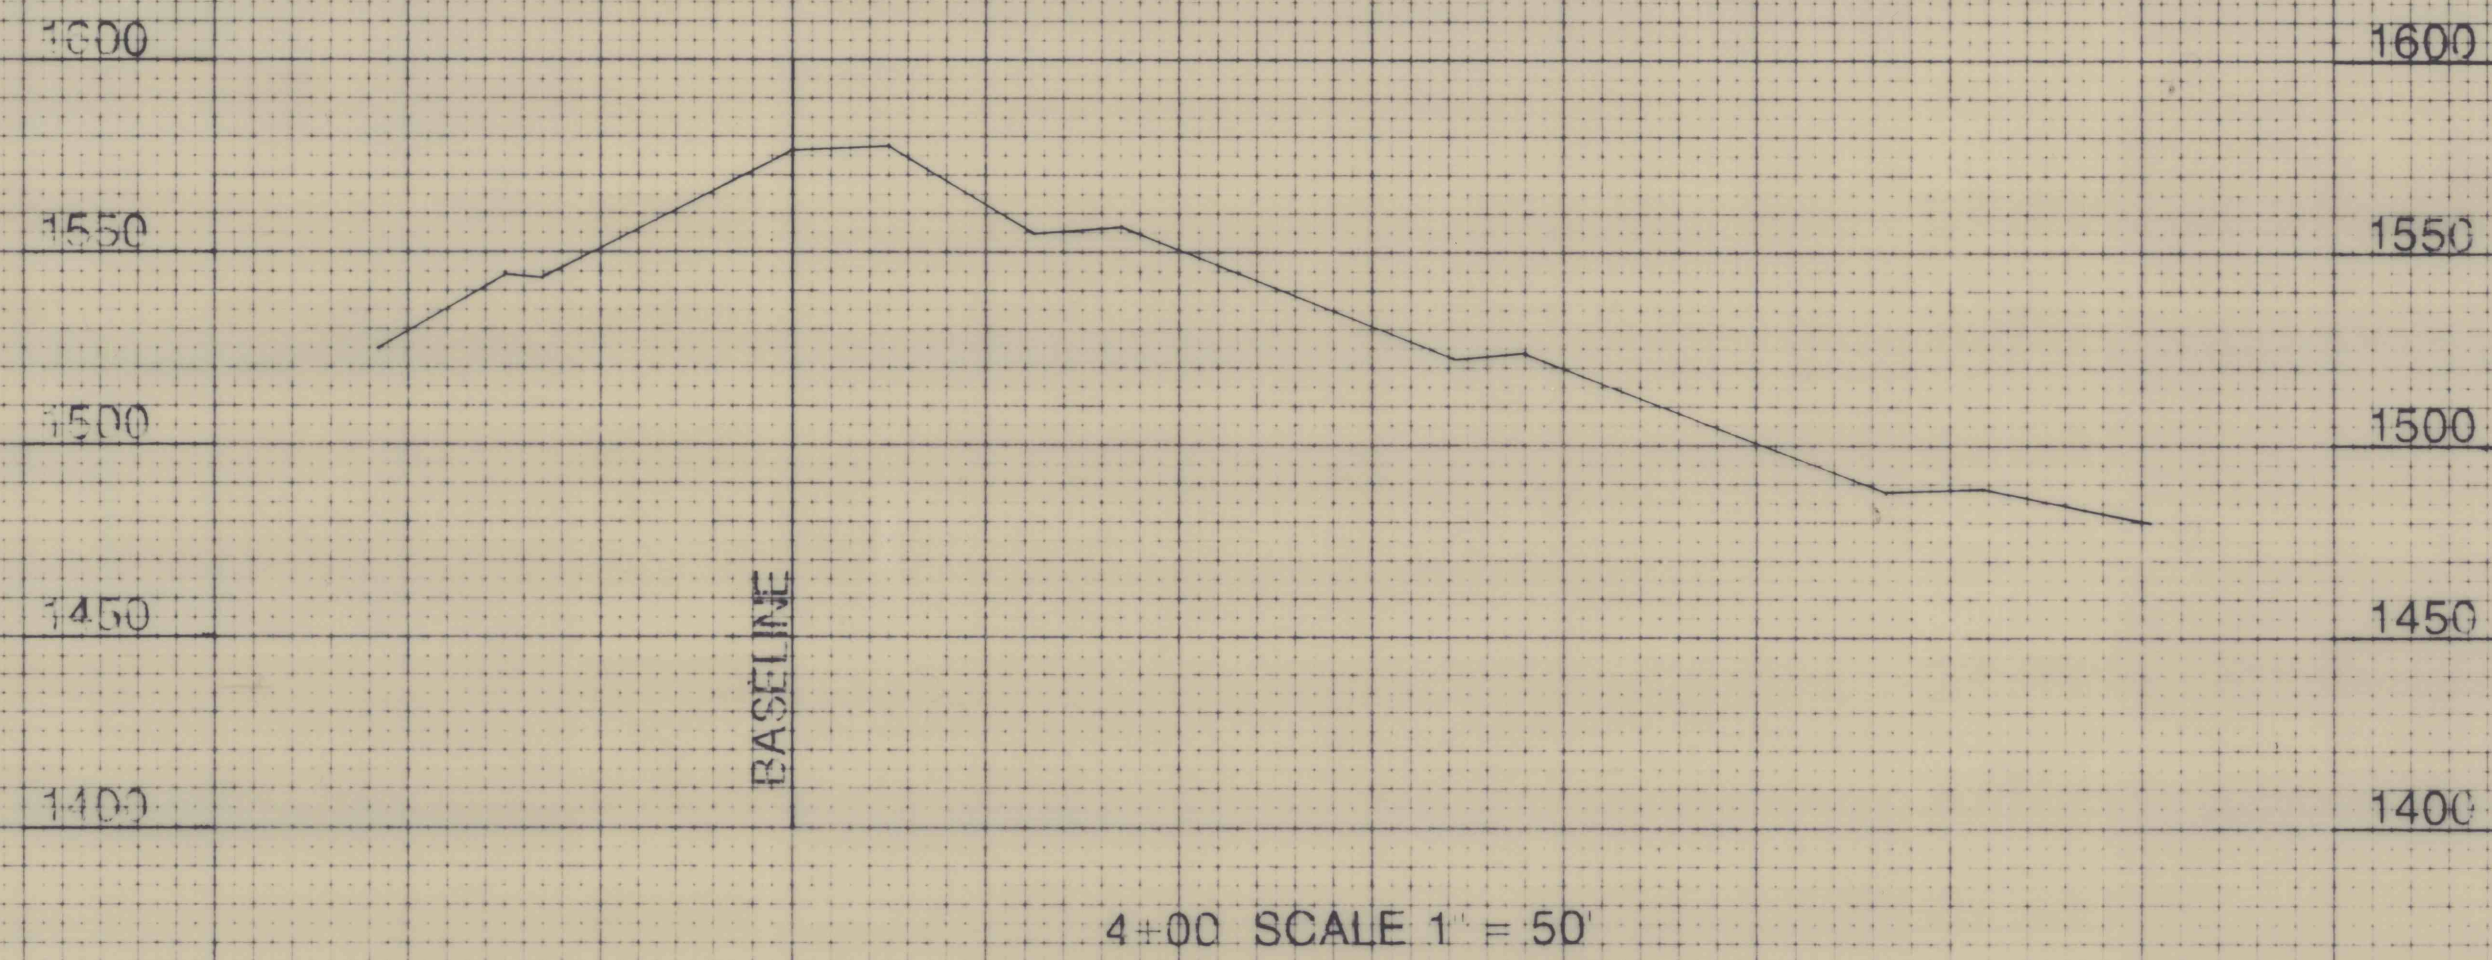

DWG. NO.		REVISIONS		NO.	DATE	BY
NORTH HOLLOW IMPOUNDMENT AS BUILT SECTIONS BETHENERGY MINES INC. SOUTHERN DIVISION CHARLESTON, W.VA.						
DESIGN	DATE	CHECKED	DATE	DIBP NO.		
101.14.11	11/14/89			FILE NO. 15-15-45		
SCALE	1" = 50'					
APPROVED				DWG. NO. 101-R4-238		
DATE						