


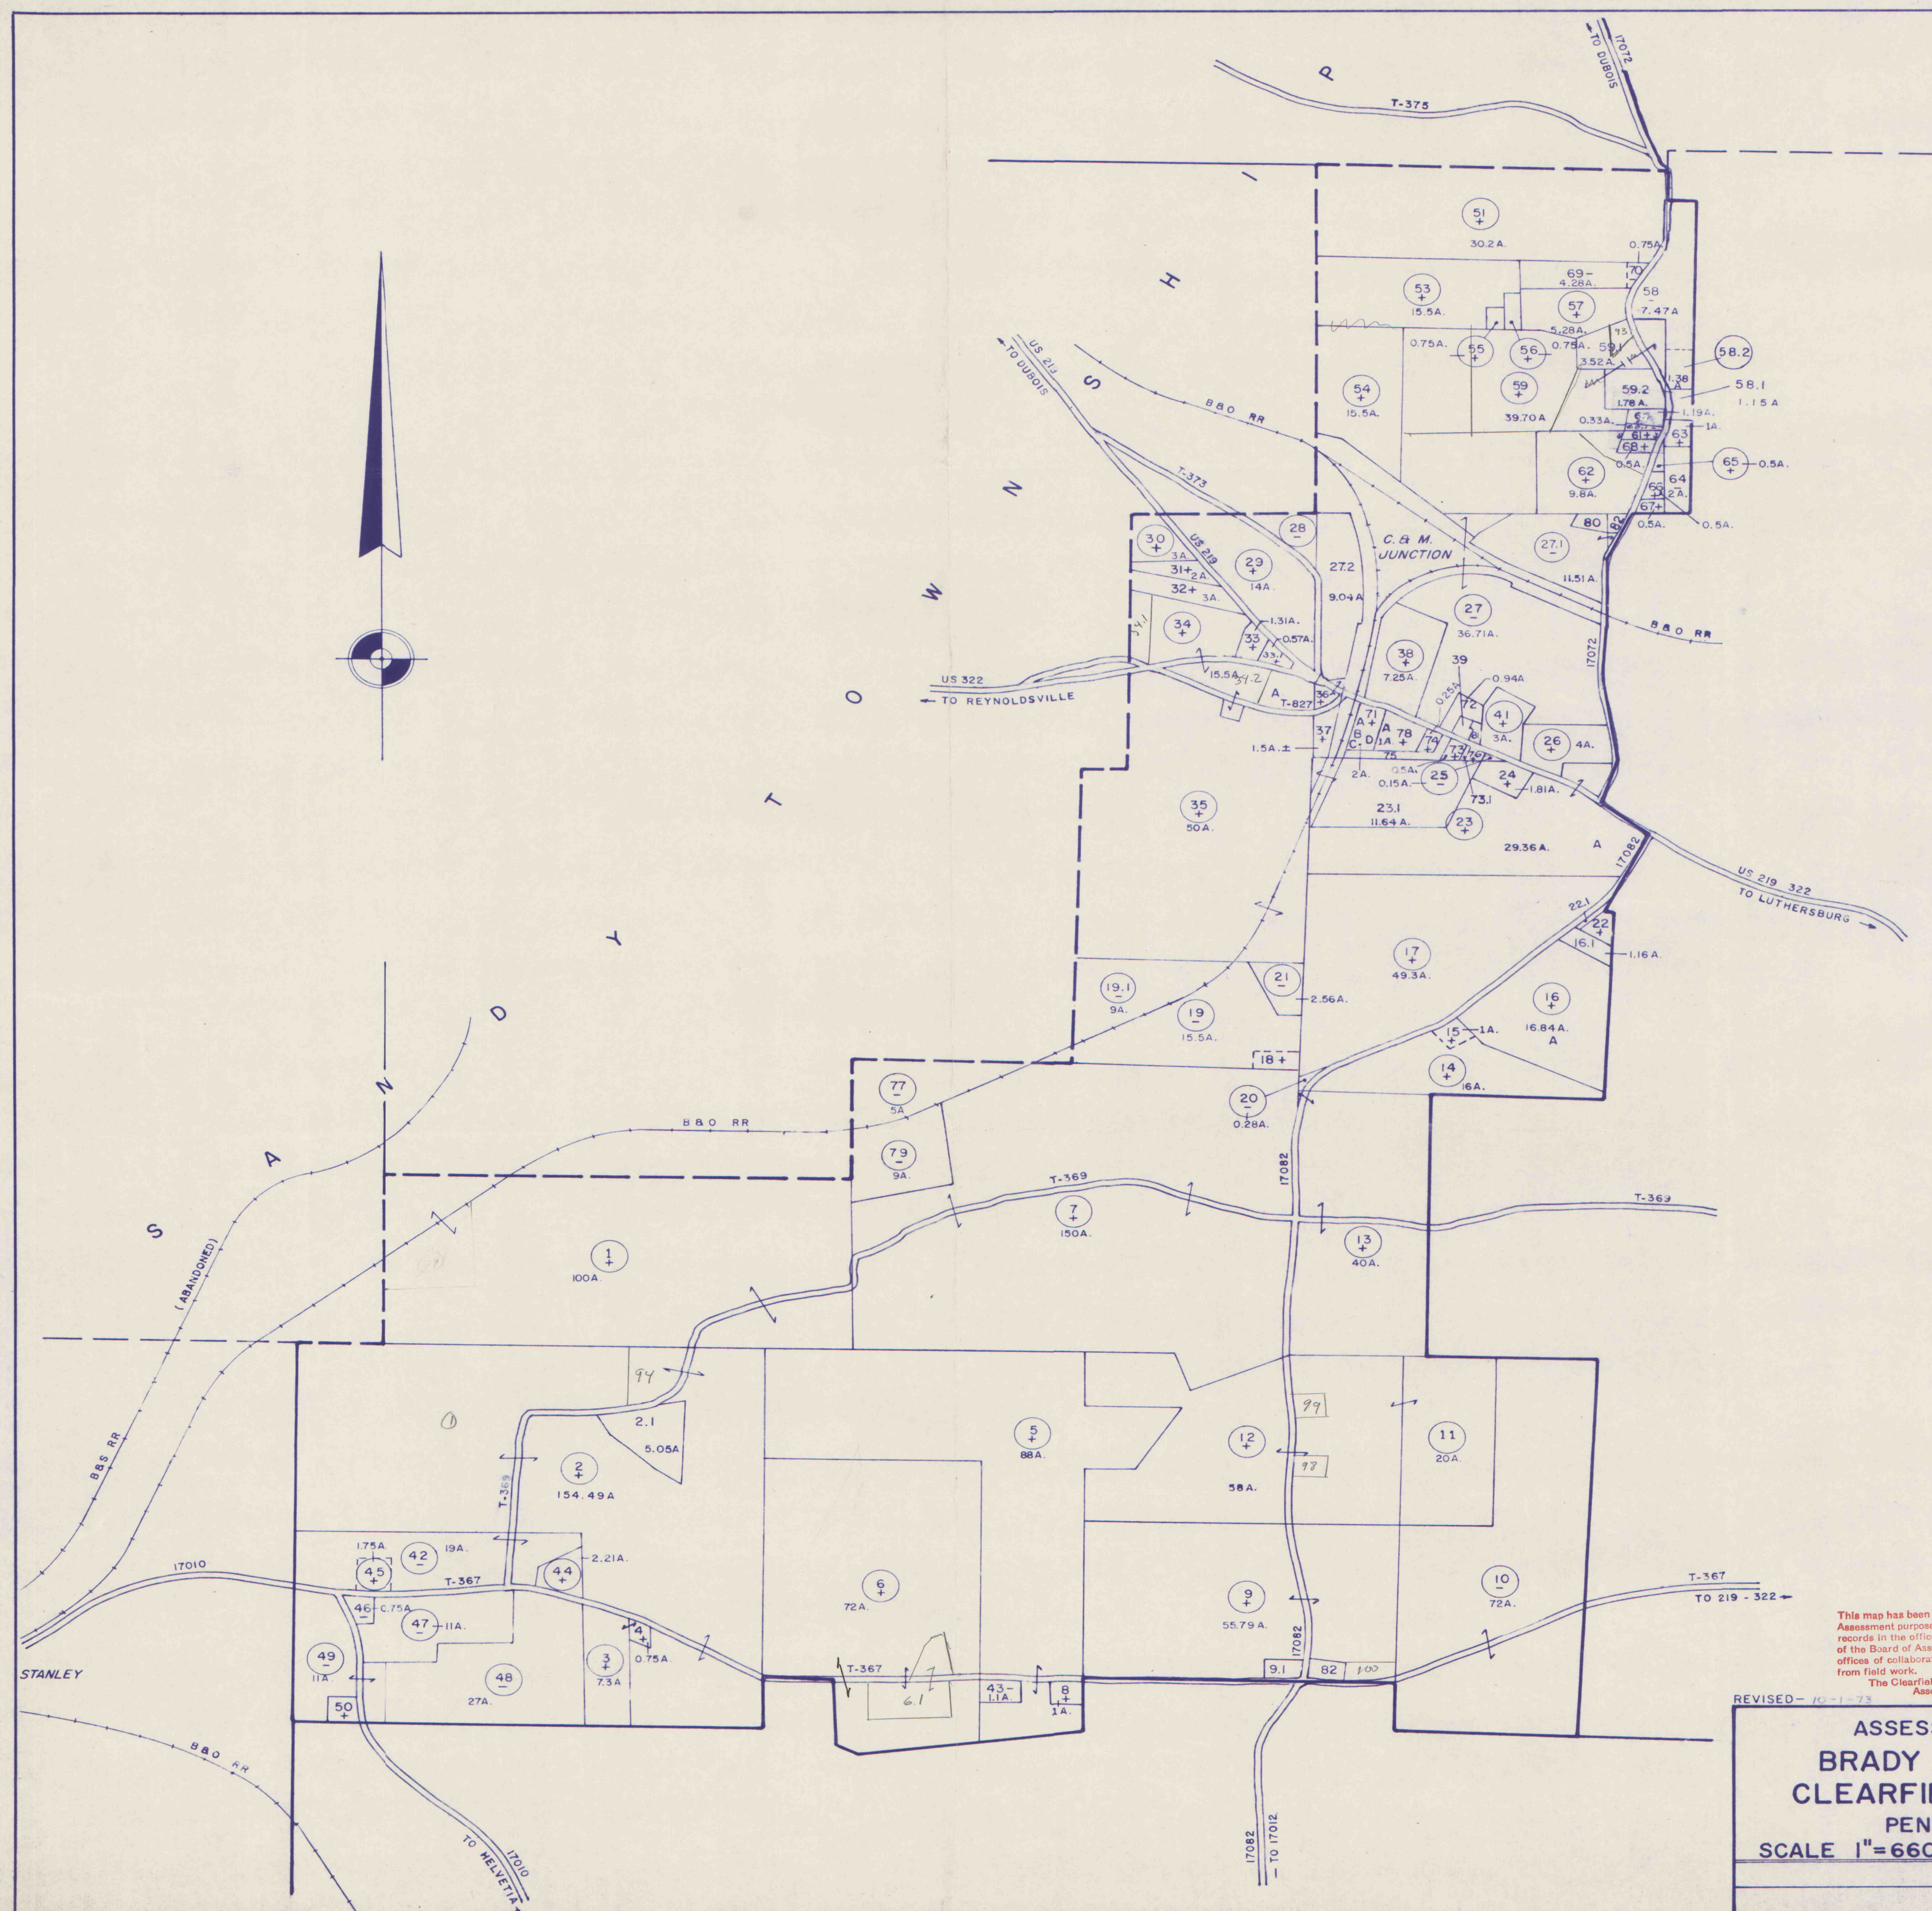

107
4

ASSESSMENT MAP
BRADY TOWNSHIP
CLEARFIELD COUNTY
PENNSYLVANIA
SCALE 1"=660' AD-1957
MAP NO. B5

1. DeLarme, Dale & Clementine
2. Kriner, Raymond & Gladys
3. Crain, Frederick C. & Dorothy M.
4. Crain, Frederick C. & Dorothy M.
5. Scholl, Charles A. & Nora C.
6. Kriner, ~~Leon D. & Hazel D.~~
7. Kriner, Leon D. & Hazel D.
8. Kriner, Philip H. et. ux.
9. DeLarme, Bert M. & Jean D.
9.1 Fike, William G. & Florence J.
10. ~~Conner, Perry & Susan~~
11. Hanzely, Henry E. & Rita F.
11. Malewicz, Stanley et al
12. Hanzely, Henry E. & Rita F.
12. Malewicz, Stanley et al
13. ~~Alsbough, Harry~~
14. ~~Gray, Albert~~
15. Gray, James A. & Maxine
16. Lendel, Emery
16. Lendel, Emery
16.1 Nepper, Leonard S. & Esther M.
17. ~~Wishell, John E. & Della M.~~
18. Passmore, Ruby G.
19. Passmore, Ruby G.
19.1 DeLarme, Frank E. & Helen K.
20. Passmore, Ruby G.
21. Passmore, Ruby G.
22. Shaffer, Elmer & Vera
22.1 Shafer, Joseph R. & Dorothy
23. London, Mazie C.
23. London, Mazie C.
23.1 Green, John C.
23.1 London, Mazie C.
24. Hall Motor Transit Co.
25. Hall Motor Transit Co.
26. Morgan, Lawrence & Muriel
27. ~~Chapman, T. E.~~
27. Chapman, T. W. & Winifred C.
27.1 Crytser, Theodore J. & Rona C.
27.1 DuBois-Area Industrial Develop Fund
28. Bailey, Keith F. & Twila M.
29. Whitesell, C. & Ida Mae
30. Cowan, Alexander
31. Richmond, Robert A. & Marian P.
32. Cribbs, William J. & Grace A.
33. Weygandt, Merle T. & Mary L.
34. Utzinger, William
34. Utzinger, William
35. DeLarme, Frank E.
35. DeLarme, Frank E. & Helen
36. Gardlock, Haley & Maxine
36. Gardlock, Jack
36. Ammerman, Clair F. & Doris
37. DeLarme, Frank E. & Helen K.
38. Downer, Geo. W.
39. Shaffer, Lawrence O. & Francis Wally
41. Hartzfeld, Ralph
42. Rochester & Pittsburgh Coal Co.
43. Gifford, William B.
44. Wingert, Grace H. & Karl M.
47. Rochester & Pittsburgh Coal Co.
48. Rochester & Pittsburgh Coal Co.
49. Rochester & Pittsburgh Coal Co.
50. Sandy, Carl J. & Linda J.
51. Hand, Francis E. & Joyce A.
52. Heitz, J. S. Est.
53. Delaney, Patrick J.
54. Delaney, Patrick J.
55. Delaney, Patrick J.
56. Delaney, Patrick J.
57. Sunderlin, Joseph R. & Cleon K.
58. Kolash, Joseph N. & Joan L.
59. Michael, John Francis, George Jr. and Thomas
59.1 Carlson, Carl & Josephine
59.2 DeBoer, John A. & Mary Ann
60. Horn, William
60.1 Jenney, Abel E. & Helen
61. Salada, Chester H.
62. Whaling, Harry
63. Salada, Irvin M. & Geraldine M.
64. Gearhart, James
65. Marsh, Charles
66. Gearhart, James
67. Gearhart, Clarence
68. Jenny, Able E. & Helen D.
69. Delaney, Patrick J.
70. Kotsbauer, William F. & Ruth Fay
71. McFall, Ray D. & Hazel L.
71A McFall, Ray D. & Hazel L.
71B McFall, Ray D. & Hazel L.
71C McFall, Ray D. & Hazel L.
71D McFall, Ray D. & Hazel L.
72. Ashenfelter, Geo. N. & Alta M.
73. Ashenfelter, Rosa
73.1 Shortway-Hi Co., Inc.
74. Ashenfelter, Geo. N. & Alta M.
75. Ashenfelter, Geo. N. & Alta M.
76. Krach, George, Raymond and Arthur Gearhart
77. Amikavich, John K. & Gertrude J.
78. Downer, Geo. W.
79. Bender, Harry
80. Wells, Herbert A. & Ruth A.
81. ~~Thomella, Samuel & Grace~~
82. ~~VANDERKENDONCK, LEON F. & ELIZABETH A.~~
83. ~~Slattery, William~~

10143-85 Map B-5

4