
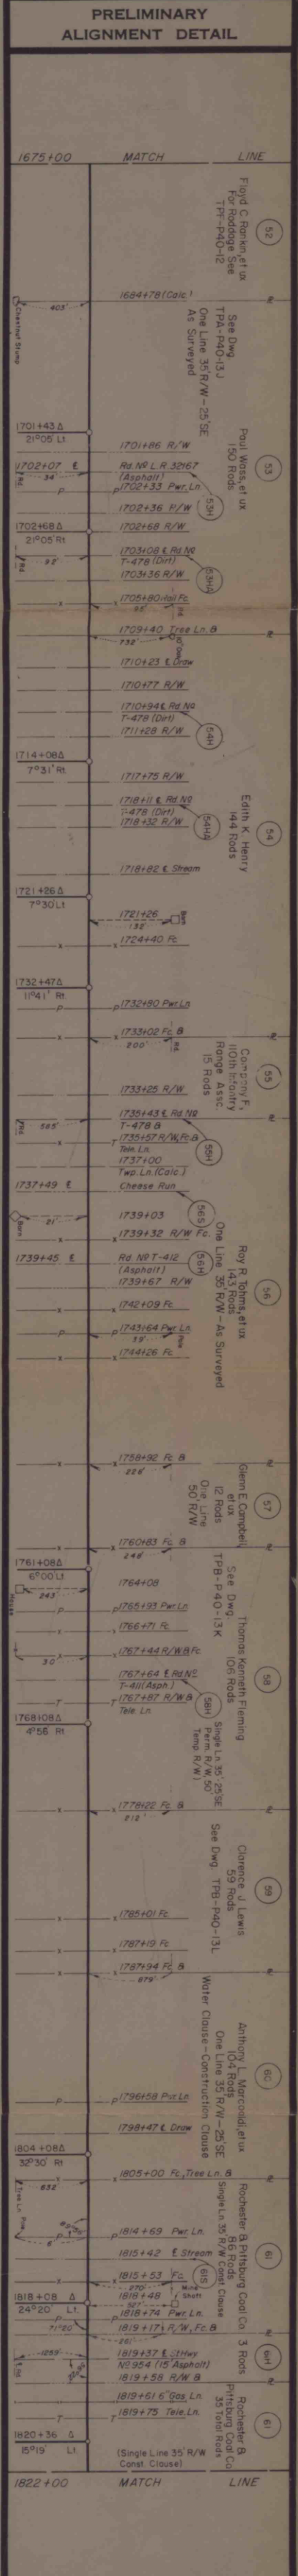
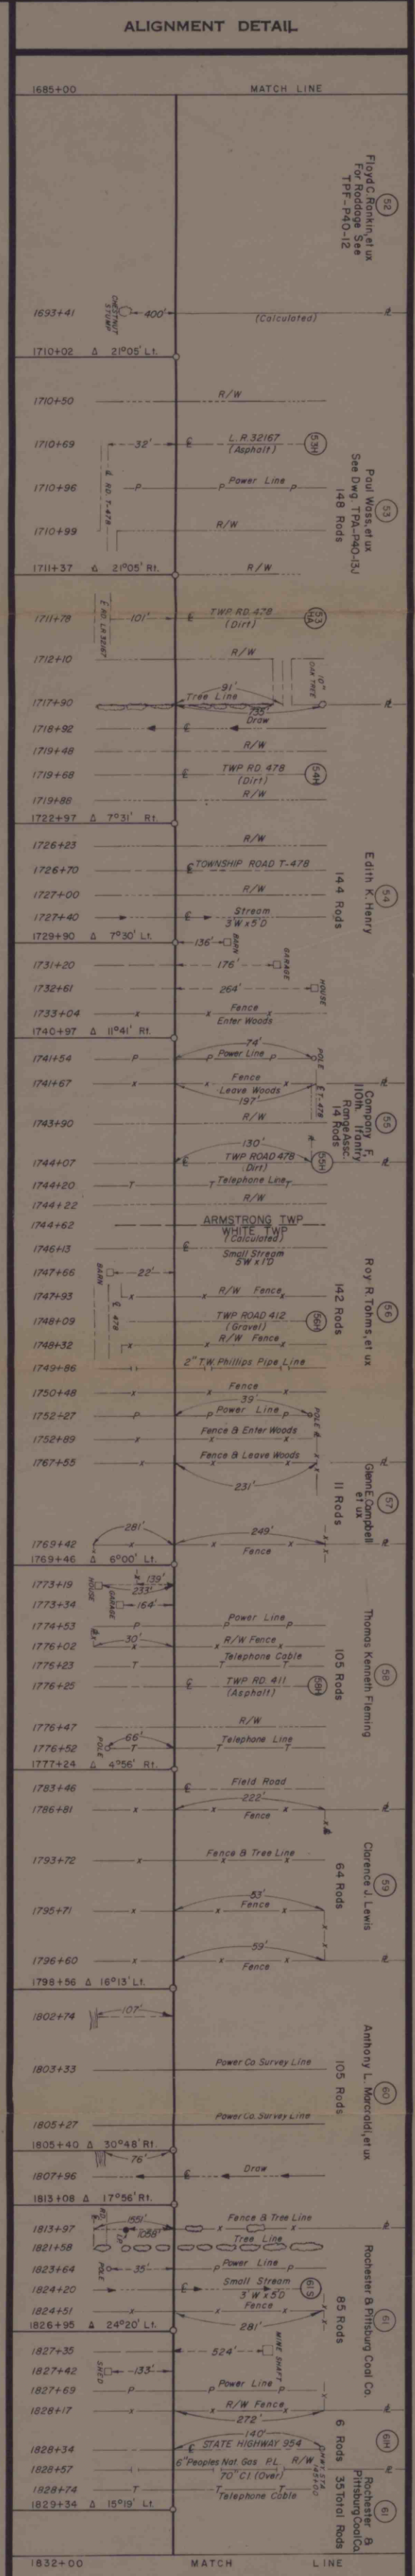


FIELD	NOTES
1	As Built
2	As Built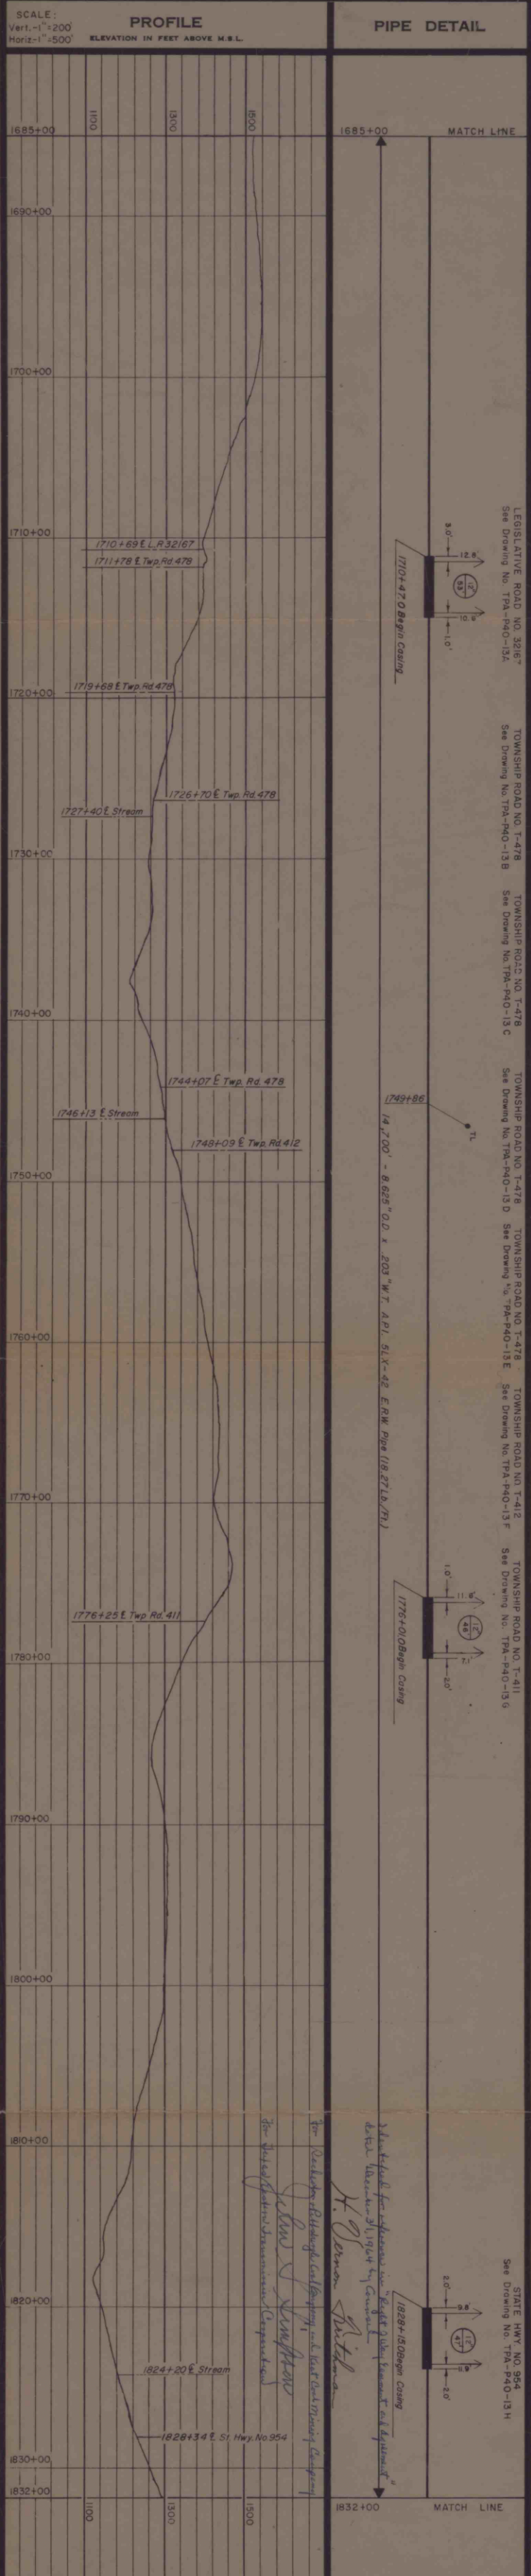
TEXAS EASTERN TRANSMISSION CORPORATION
LITTLE BIG INCH DIVISION - HOUSTON, TEXAS

AS BUILT
8" LINE NO. P40
INDIANA COUNTY, PENNSYLVANIA

DRAWN BY: C.A.T. DATE: 10-63 APPROVED: DATE: DATE:
CHECKED: G.C.C. DATE: 4-2-64 APPROVED: DATE: DATE:

REFERENCE DRAWINGS
AS BUILT OCT 1964

FIELD BOOK NO. 14 PAGES 41-51

LEGEND

- Tract Number
- Tract Number (Possible Condemnation)
- Federal Highway
- State Highway
- Mile Post
- Elevation
- Foreign Pipe Line
- Power Line
- Telephone Line
- Telephone Cable (Underground)
- Fence
- Valve (Line Size Shown)
- Check Valve
- Relief Valve
- Meter Station
- Casing (Size & Length)
- C.L. Weight
- Conc. Weight
- Anchor
- Electrolysis Test Site & Type
- Elec. Ground Bed Number of Anodes Ground Bed w/Rectifier

GENERAL NOTES

1-30-64 As Built Per W.O.C. 1805-R.G.W.
As Built Per W.O.C. 1848-Construction

W.A. 1 J.F.

REV. DATE REVISION BY APP.

6-19-64 Added Special Provisions Tr. 58 C.A.T. M.E.N.
6-16-64 Added Special Provisions Tr. 61 C.A.T. G.C.C.
5-5-64 Added Mile Posts C.A.T. G.C.C.
4-23-64 Added Sta. 1804+08 To M.L. C.A.T. G.C.C.
4-7-64 Revised Tract 55 C.A.T. G.C.C.
4-4-64 Checked & Corrected C.A.T. G.C.C.

REV. DATE REVISION BY APP.