



[illegible]

## PRELIMINARY SEGMENT DETAIL

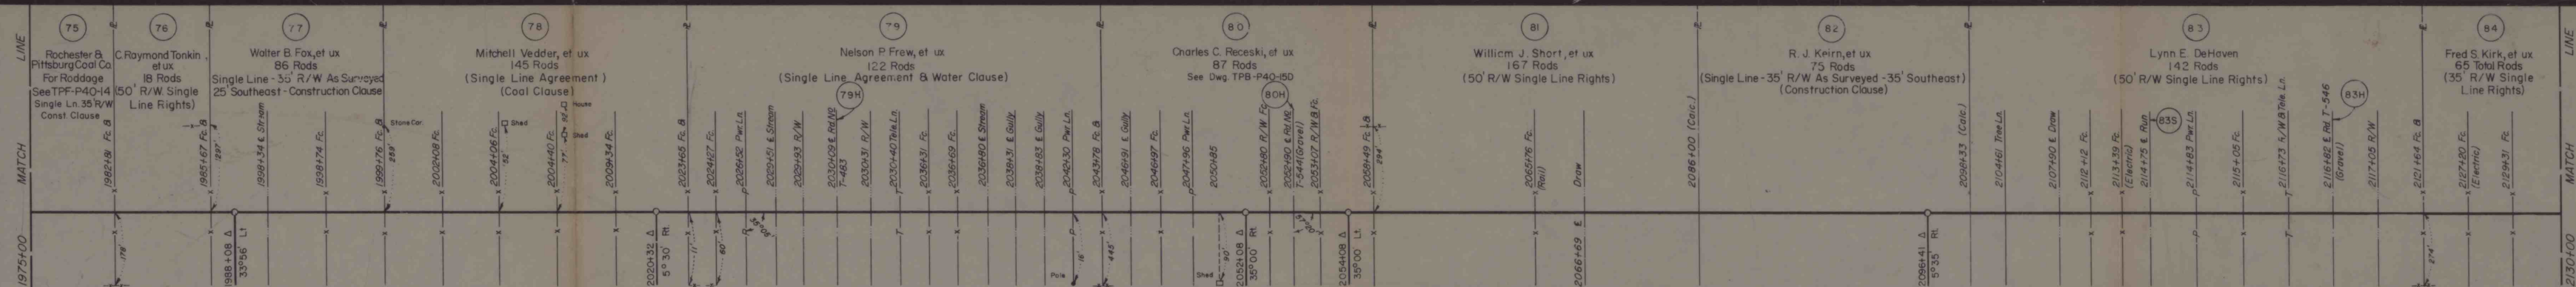


### ALIGNMENT DETAIL

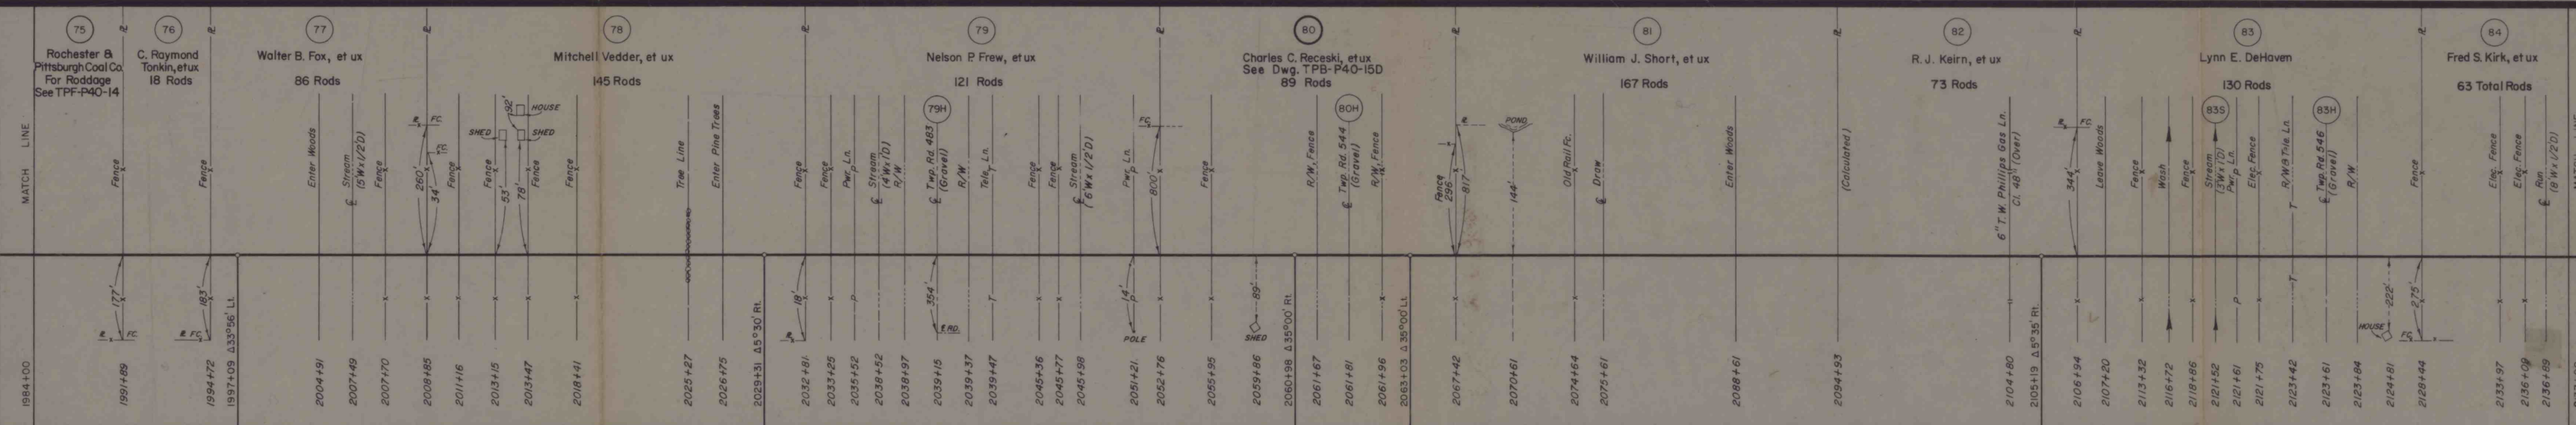

## GENERAL NOTES



### PIPE DETAIL

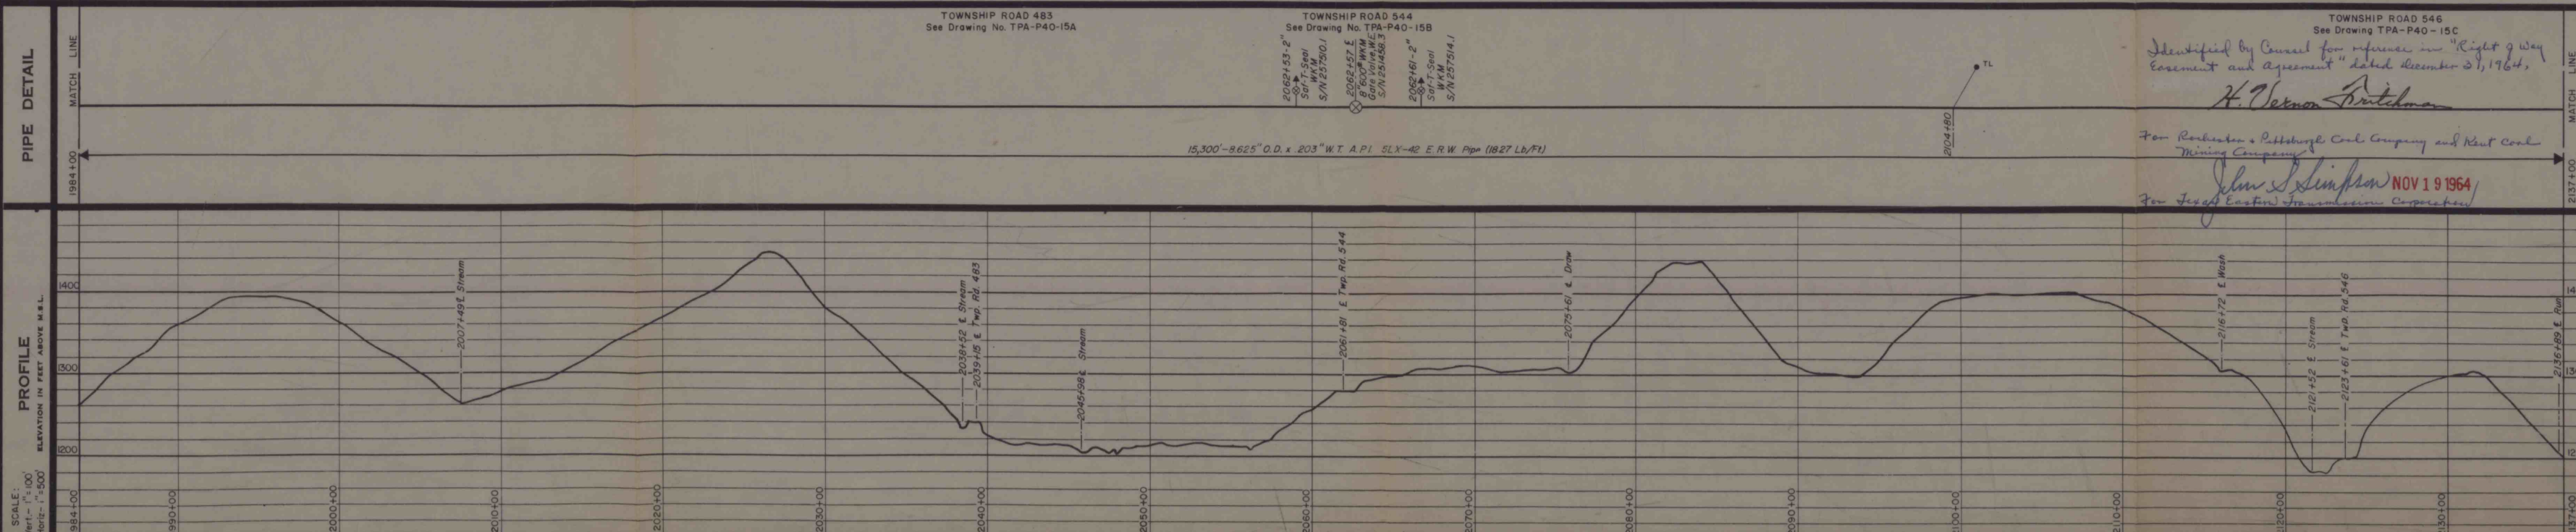

**TEXAS EASTERN TRANSMISSION CORPORATION**  
LITTLE BIG INCH DIVISION • HOUSTON, TEXAS

AS BUILT October 18, 1964  
8" LINE NO. P40  
INDIANA COUNTY, PENNSYLVANIA

|             | DATE        | CORRECT  | DATE |
|-------------|-------------|----------|------|
|             | DATE        | APPROVED | DATE |
| N BY C.A.T. | DATE 1-3-64 |          |      |
| KED G.C.C.  | DATE 4-3-64 |          |      |

## REFERENCE DRAWINGS

BOOK NO 14 PAGES 61-69

1000

**TEXAS EASTERN TRANSMISSION C**  
LITTLE BIG INCH DIVISION - HOUSTON

8" LINE NO. P40  
INDIANA COUNTY, TENNESSEE  
AS BUILT Oct

| IN BY CAT     | DATE 1-3-64 | CORRECT  |
|---------------|-------------|----------|
| WEEKED G.C.C. | DATE 4-3-64 | APPROVED |

## REFERENCE DRAWINGS

BOOK NO. 14 PAGES 61-69

3  
5  
2  
2  
1  
1  
0  
0  
0  
0

Scale: 1" = 1'

|      |      |
|------|------|
| 500' | TP   |
|      | SHEP |

F-P40-

15

10

1

5006-10

300

\_\_\_\_\_

10

10

