

Table with 2 columns: BK, PAGES. Row 1: P43, 20-29.

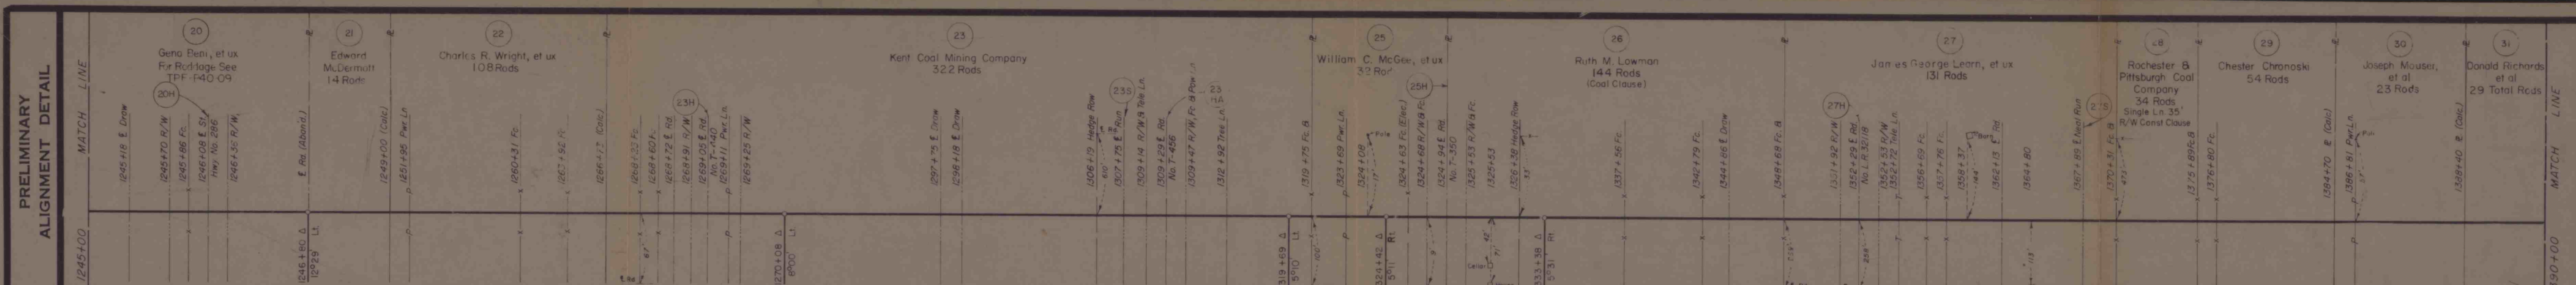


Table with 2 columns: JOB NO., DATE. Row 1: 1245+00, 12/29/54.


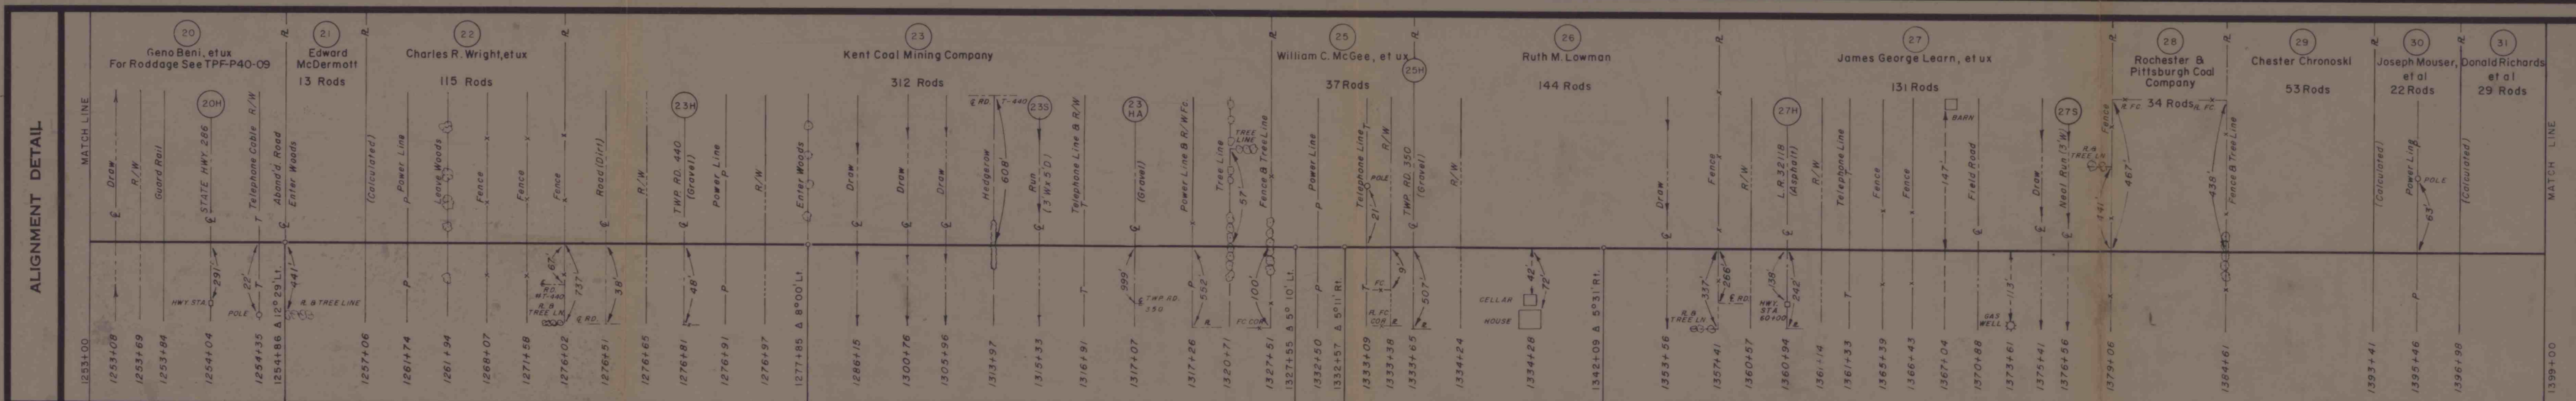


Table with 2 columns: GENERAL NOTES, DATE. Row 1: 1253+00, 12/29/54.

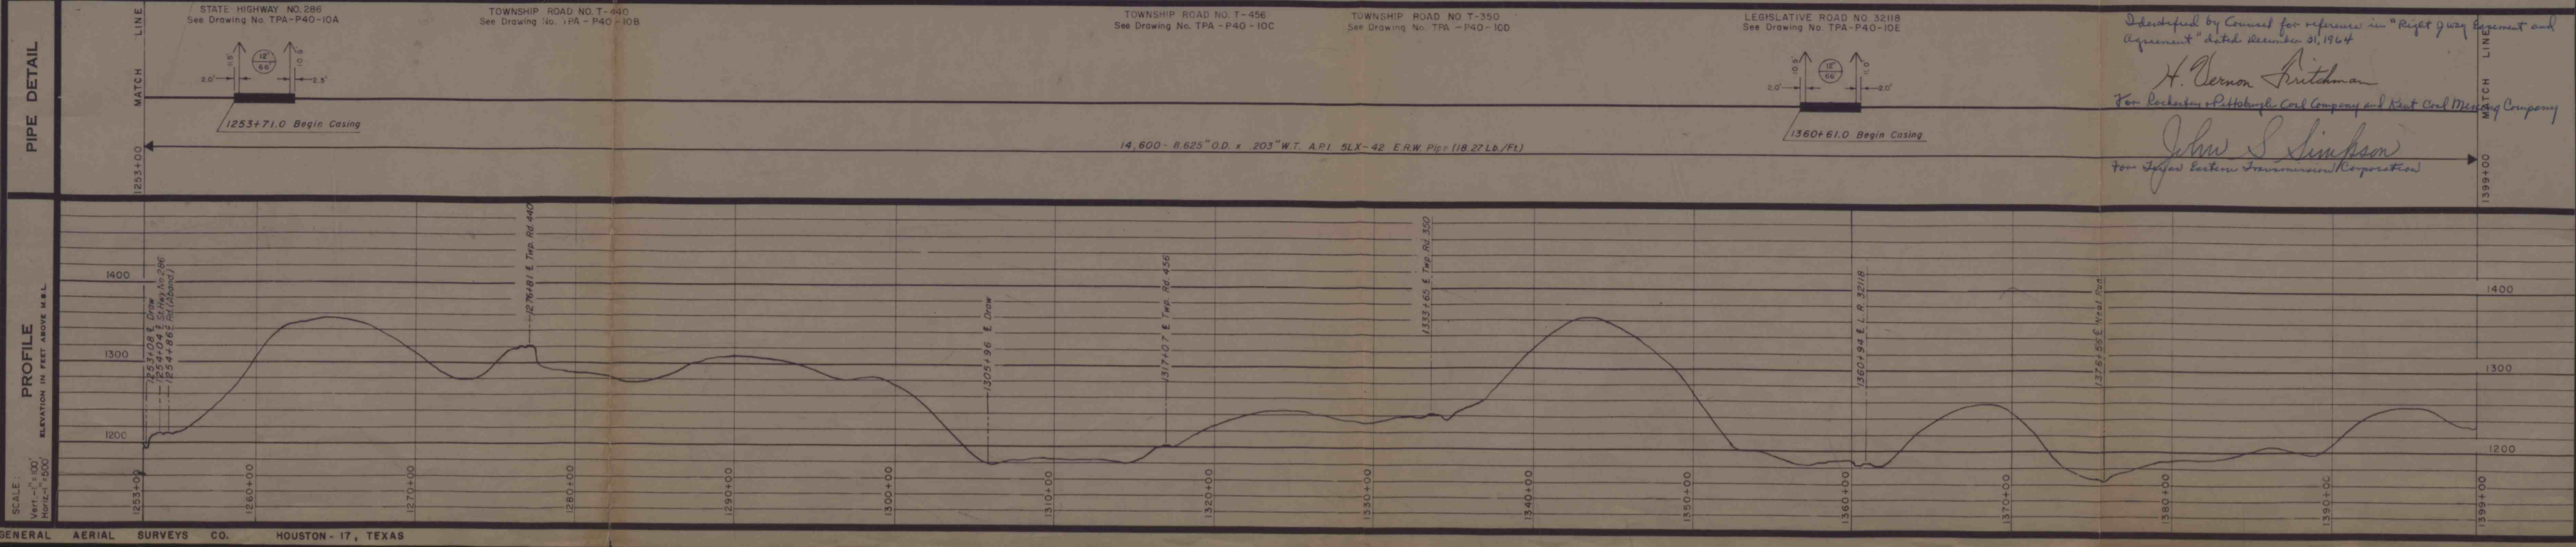

TEXAS EASTERN TRANSMISSION CORPORATION. 8" LINE NO. P40. AS BUILT. Includes a table with columns: DRAWN BY, DATE, CHECKED, DATE, and a signature block for H. Vernon Smithman and John S. Simpson.

IMAPS # 101