


IMAS 10720


FIELD NOTES	
BLK.	PAGES
P-40	29-30
P-41	4-13
P-42	14-16

PRELIMINARY
ALIGNMENT DETAIL

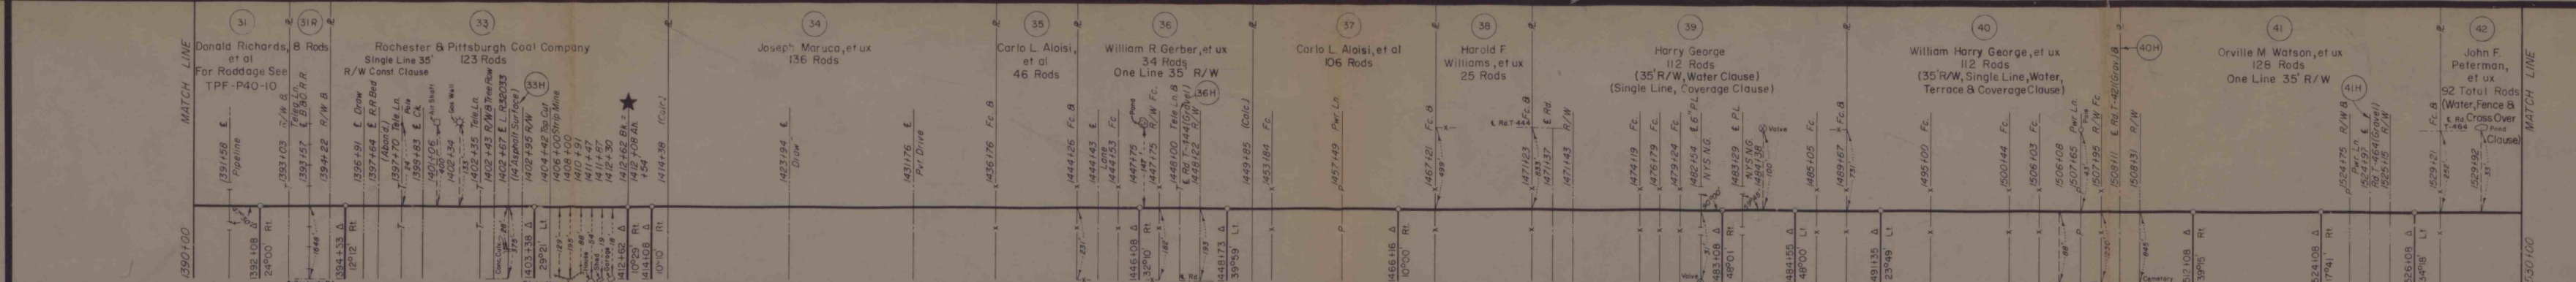

REV.	DATE	REVISION	BY	APP.
1	10-1-64	Added Special Provision Tr. 33	CAT	1522
2	10-1-64	Added Special Provision Tr. 33	CAT	1522
3	10-1-64	Added Special Provision Tr. 33	CAT	1522
4	10-1-64	Added Special Provision Tr. 33	CAT	1522
5	10-1-64	Added Special Provision Tr. 33	CAT	1522
6	10-1-64	Added Special Provision Tr. 33	CAT	1522
7	10-1-64	Added Special Provision Tr. 33	CAT	1522
8	10-1-64	Added Special Provision Tr. 33	CAT	1522
9	10-1-64	Added Special Provision Tr. 33	CAT	1522
10	10-1-64	Added Special Provision Tr. 33	CAT	1522

ALIGNMENT DETAIL

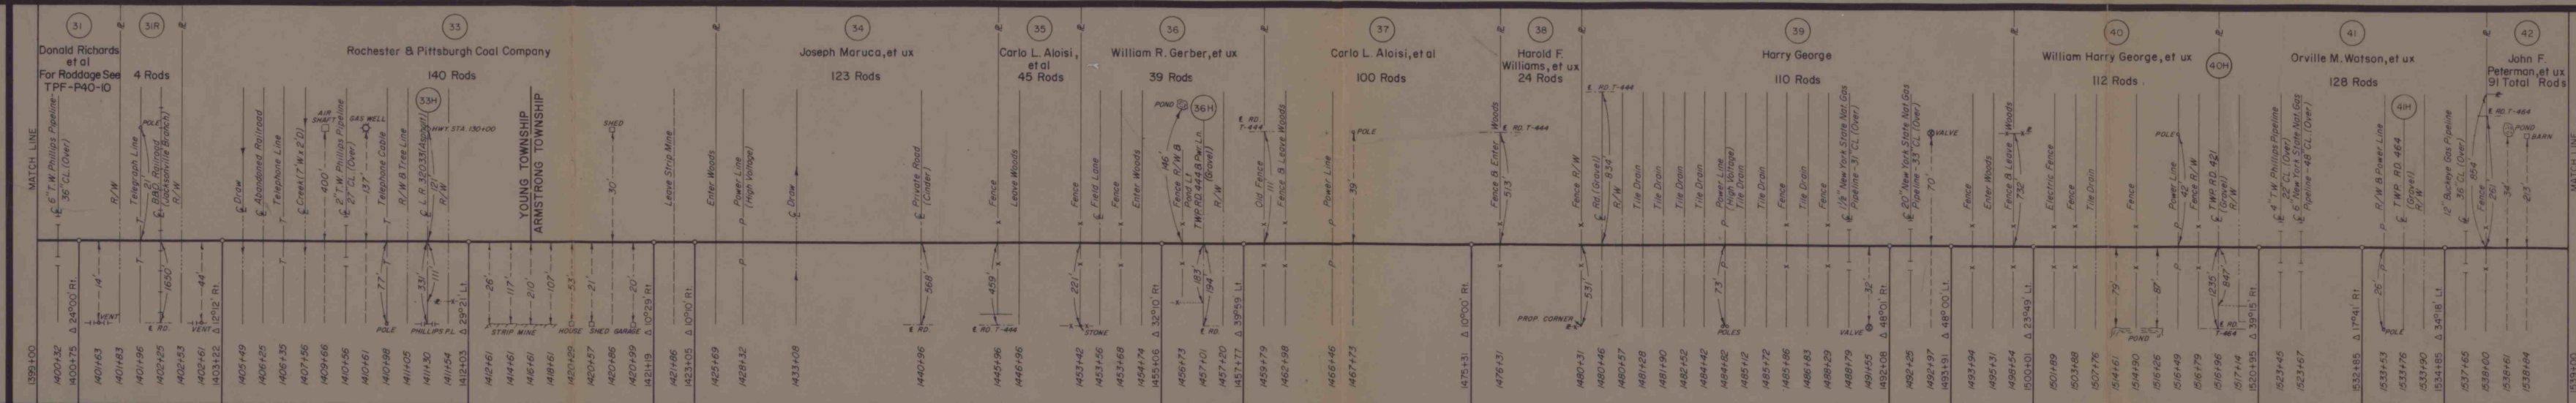


REV.	DATE	REVISION	BY	APP.
1	10-1-64	Added Special Provision Tr. 33	CAT	1522
2	10-1-64	Added Special Provision Tr. 33	CAT	1522
3	10-1-64	Added Special Provision Tr. 33	CAT	1522
4	10-1-64	Added Special Provision Tr. 33	CAT	1522
5	10-1-64	Added Special Provision Tr. 33	CAT	1522
6	10-1-64	Added Special Provision Tr. 33	CAT	1522
7	10-1-64	Added Special Provision Tr. 33	CAT	1522
8	10-1-64	Added Special Provision Tr. 33	CAT	1522
9	10-1-64	Added Special Provision Tr. 33	CAT	1522
10	10-1-64	Added Special Provision Tr. 33	CAT	1522



REV.	DATE	REVISION	BY	APP.
1	10-1-64	Added Special Provision Tr. 33	CAT	1522
2	10-1-64	Added Special Provision Tr. 33	CAT	1522
3	10-1-64	Added Special Provision Tr. 33	CAT	1522
4	10-1-64	Added Special Provision Tr. 33	CAT	1522
5	10-1-64	Added Special Provision Tr. 33	CAT	1522
6	10-1-64	Added Special Provision Tr. 33	CAT	1522
7	10-1-64	Added Special Provision Tr. 33	CAT	1522
8	10-1-64	Added Special Provision Tr. 33	CAT	1522
9	10-1-64	Added Special Provision Tr. 33	CAT	1522
10	10-1-64	Added Special Provision Tr. 33	CAT	1522

PIPE DETAIL

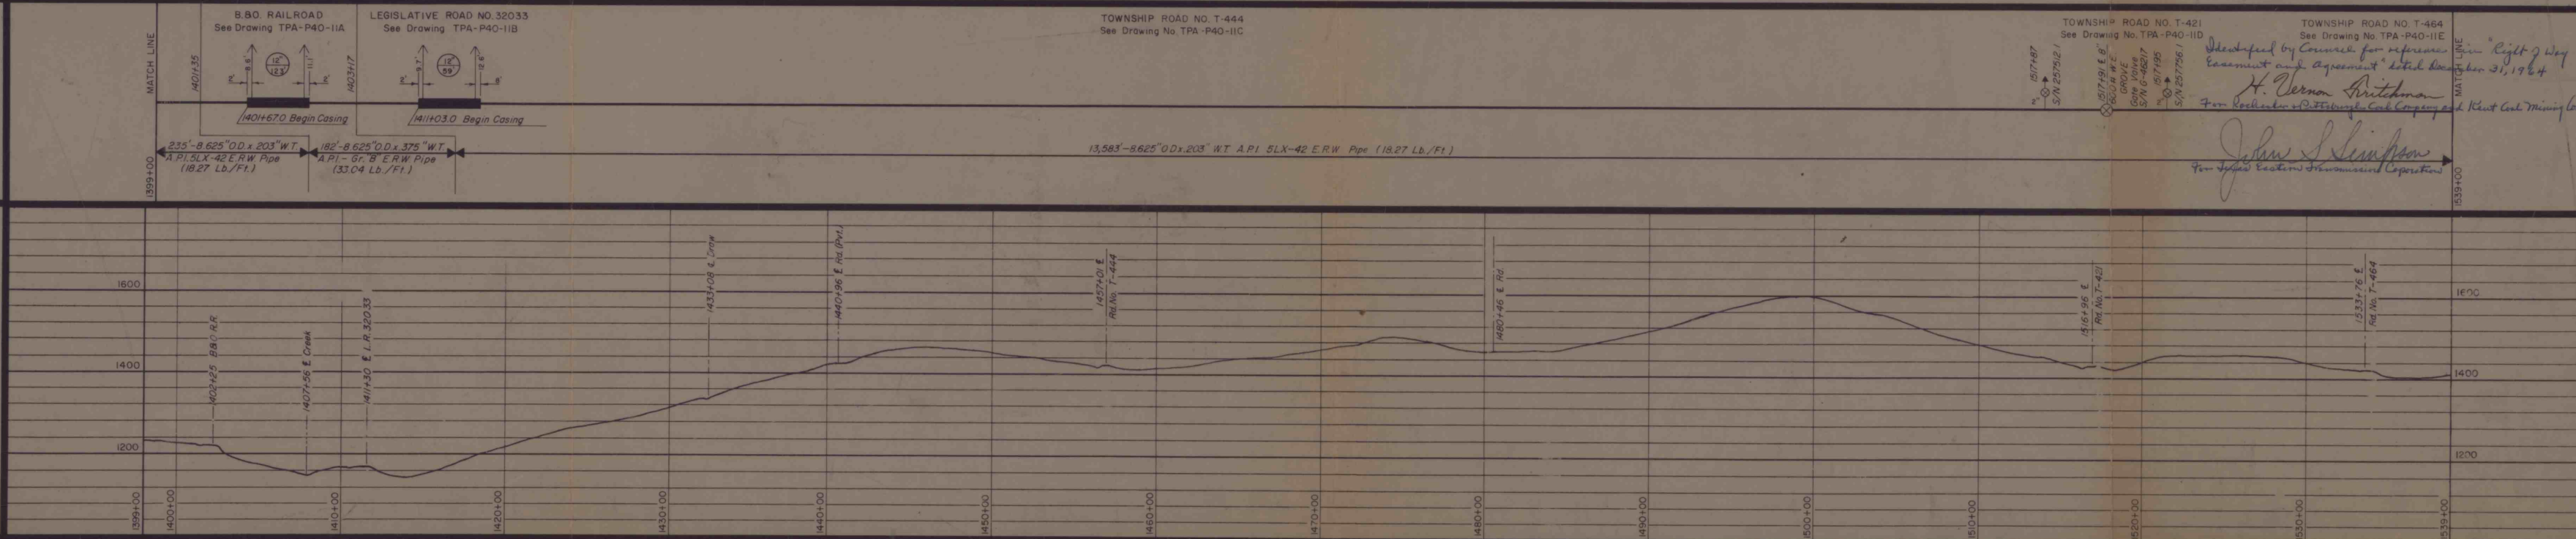

TEXAS EASTERN TRANSMISSION CORPORATION
LITTLE BIG INCH DIVISION • HOUSTON, TEXAS

AS BUILT
8" LINE NO. P40
INDIANA COUNTY, PENNSYLVANIA

DATE: 10-1-64
APPROVED: [Signature]
DATE: 10-1-64
APPROVED: [Signature]

REFERENCE DRAWINGS
AS BUILT OCT 12 1964

TPF-P40-II

Scale: 1"=500' SHEET OF