

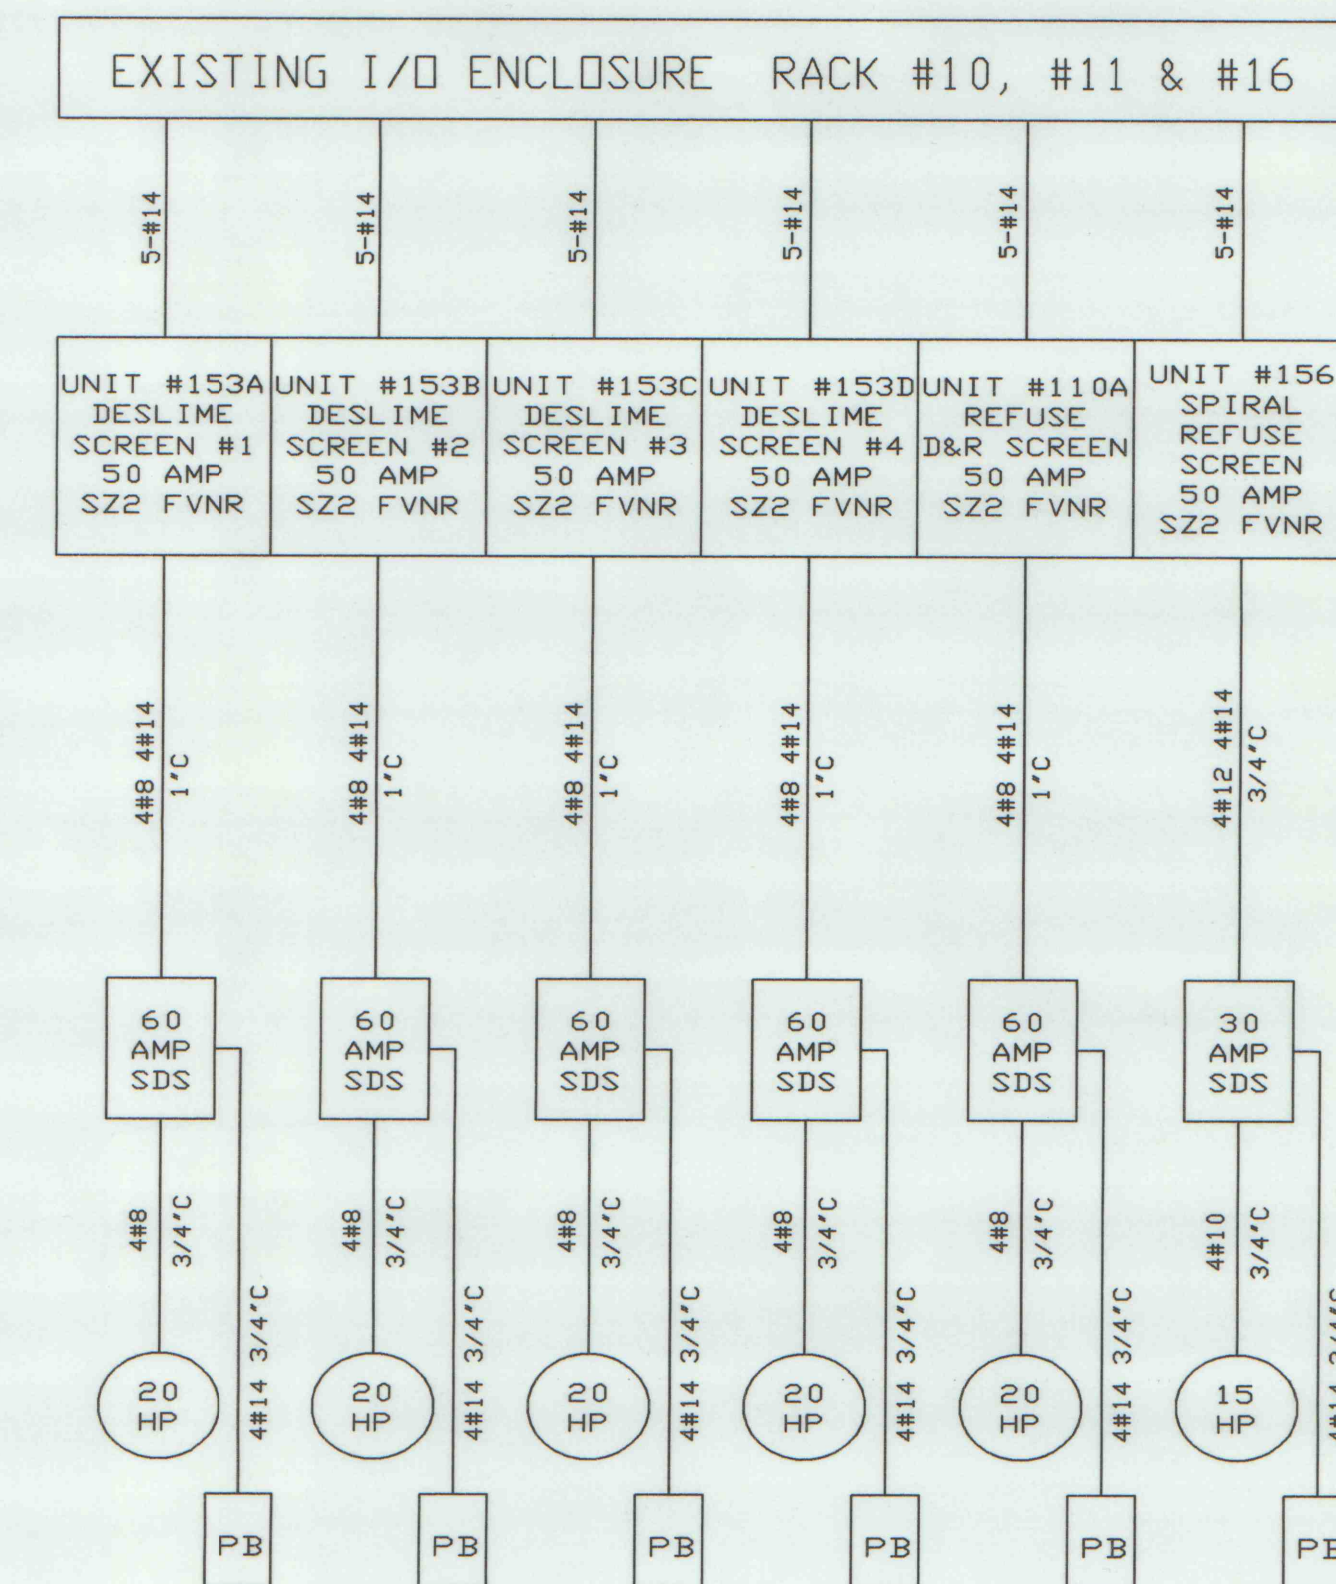


 
* EXISTING STARTER RELOCATED FROM MCC #5

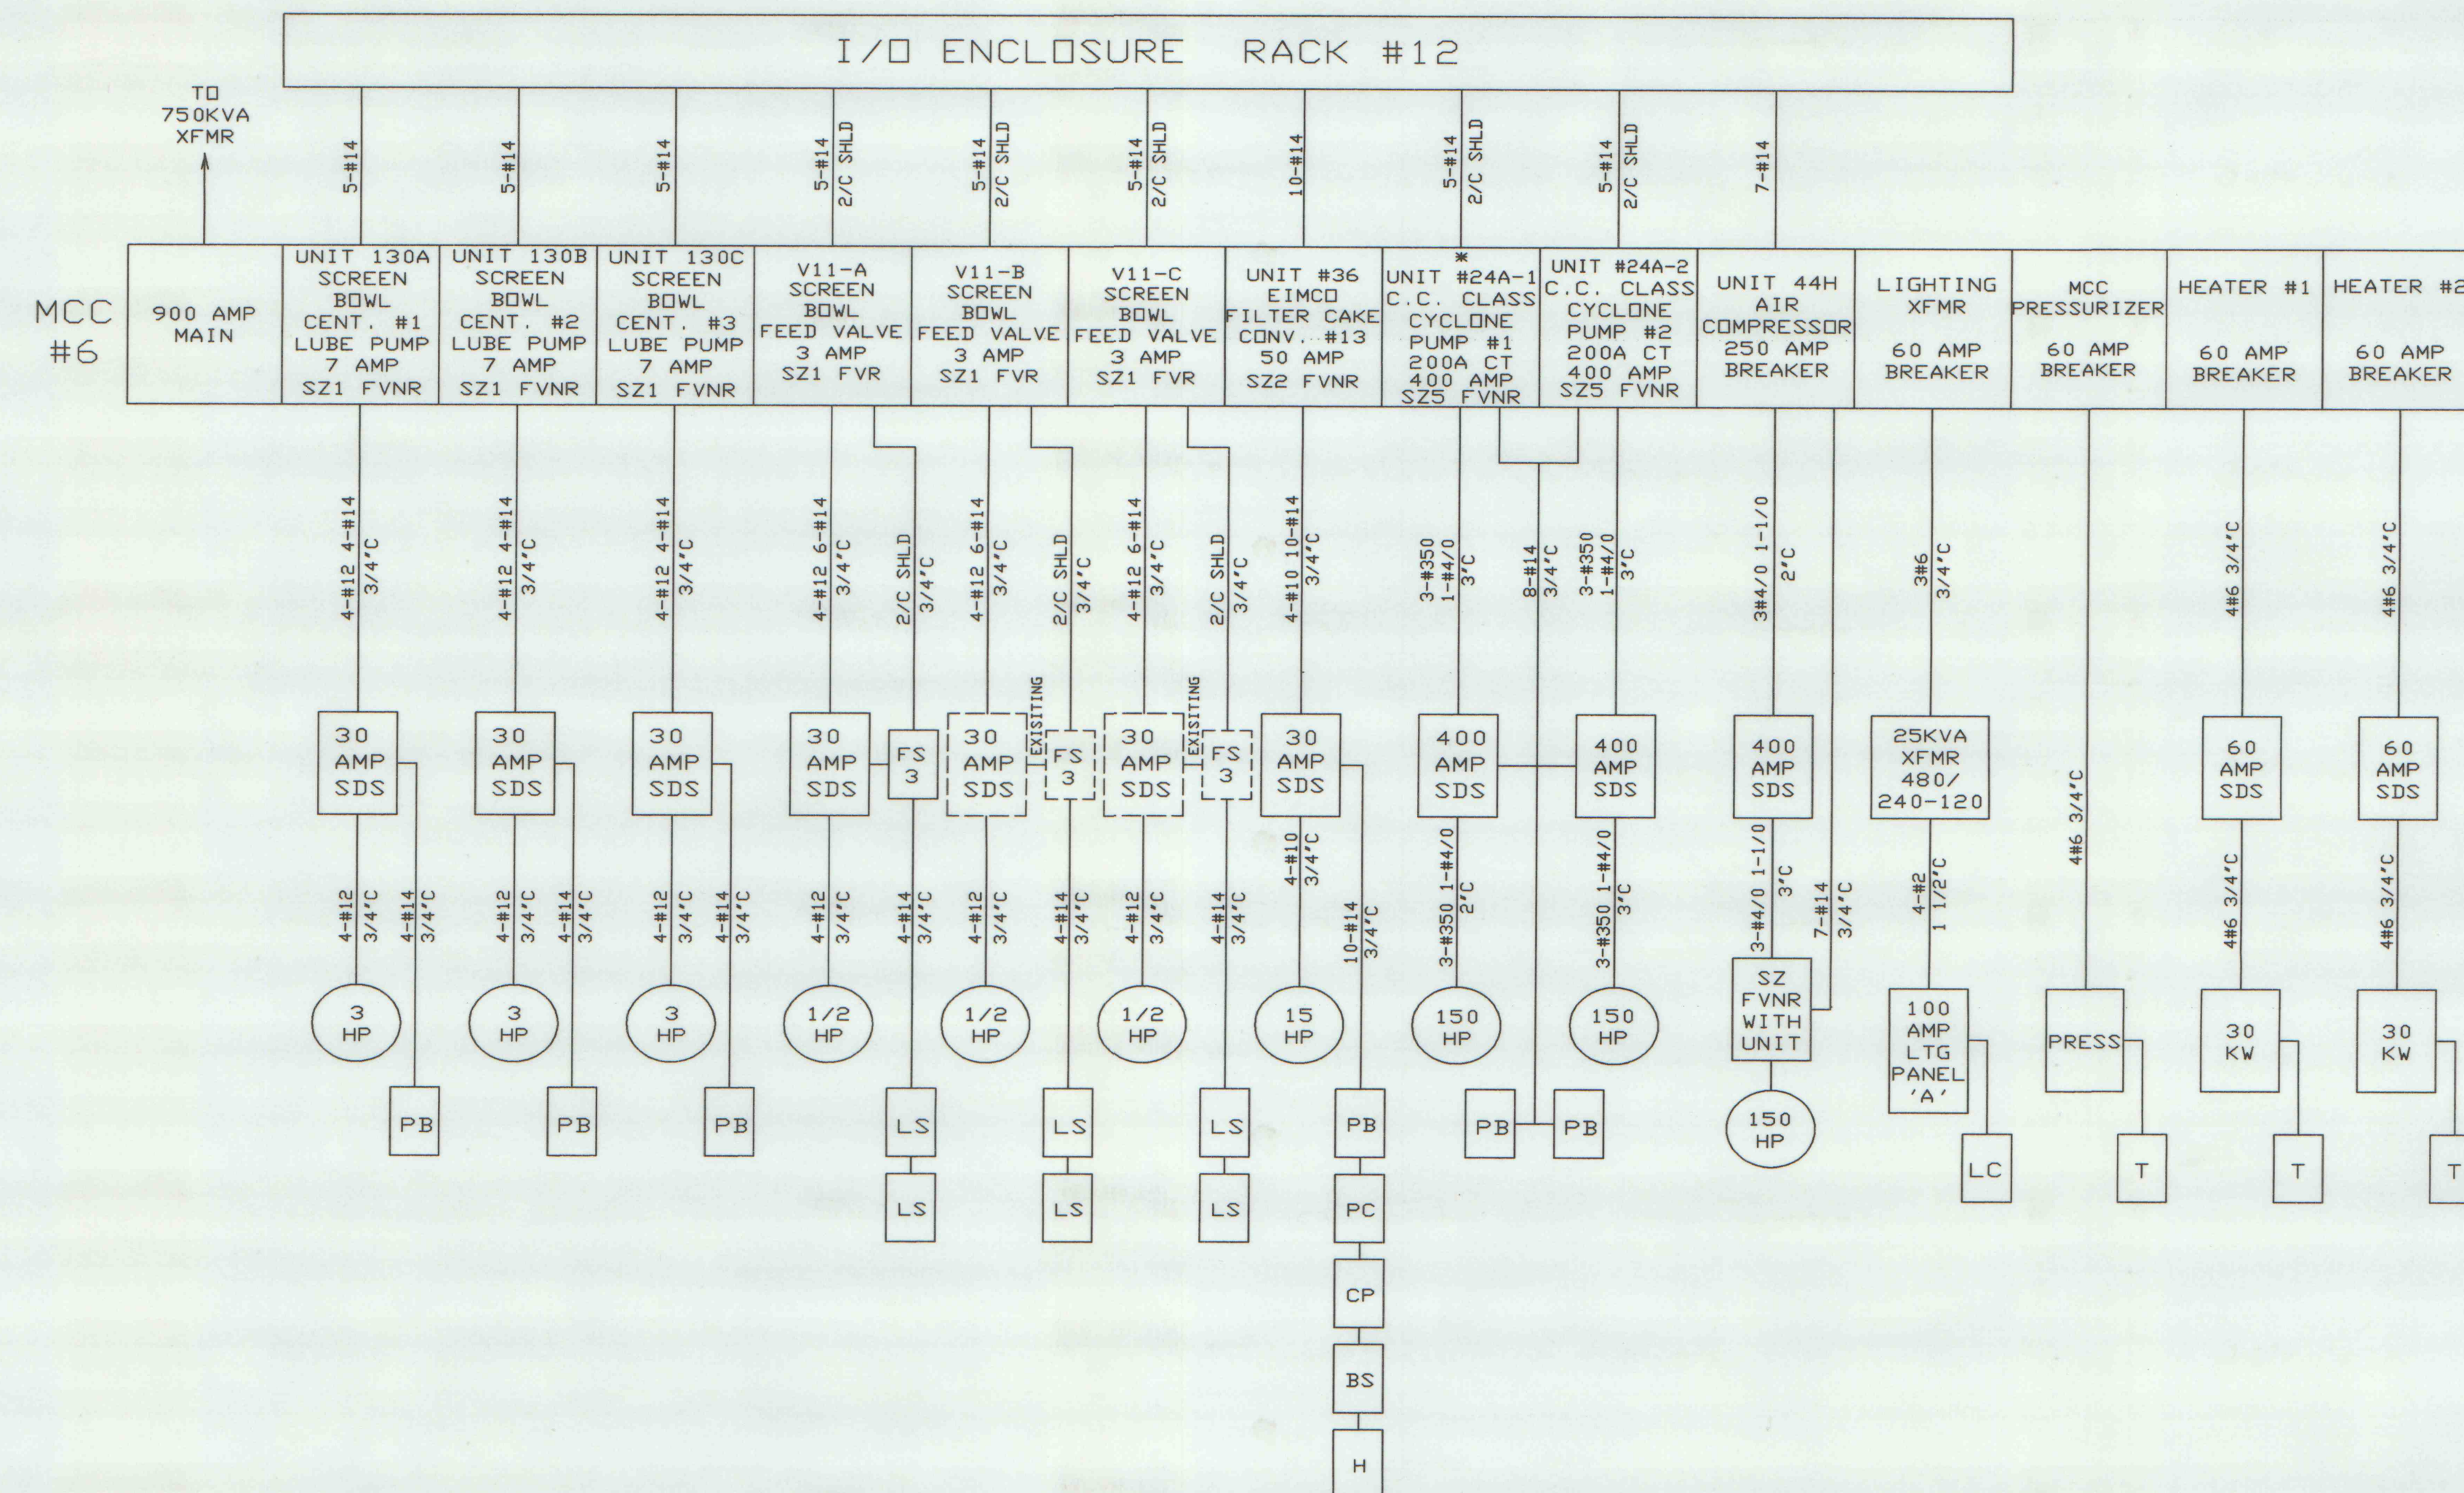

EXISTING
MCC P2 & P3

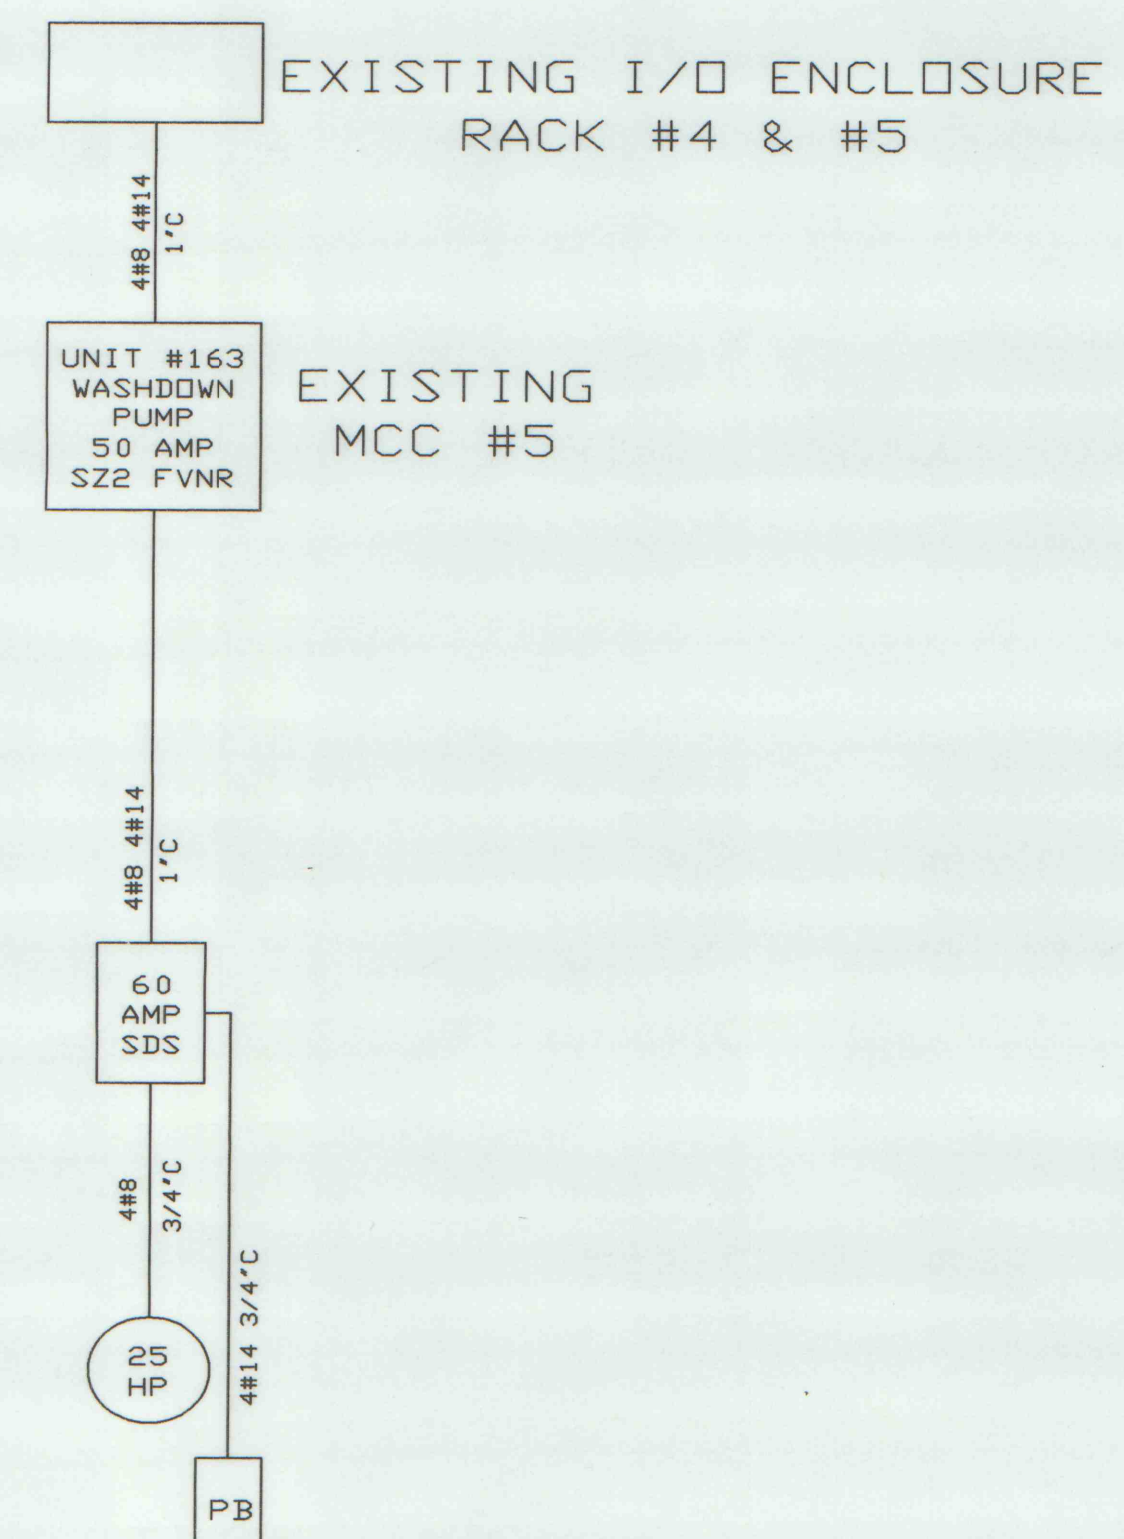

IMAPS # 15231

	REVISION DESCRIPTION					MADE BY	DATE	CHECKED BY	DATE	DRAWN BY	DATE	COKE	05/11/95	ROCHESTER & PITTSBURGH COAL COMPANY	NO. DWGS. THIS PROJECT	SCALE	PROJECT NO.
	1.) GENERAL REVISION					COKE	3/18/95			DESIGNED BY	DATE	R.F.	5/13/95	KEYSTONE COAL MINING CORP.		NONE	94-164
	2. REV. PER AS BUILT					COKE	10/26/95			CHECKED BY	DATE			PREPARATION PLANT MODIFICATIONS		DRAWING NO.	FILE NO.
										APPROVED BY	DATE			ELECTRICAL ONE LINE		EL-04	94-164-04

01450 A