


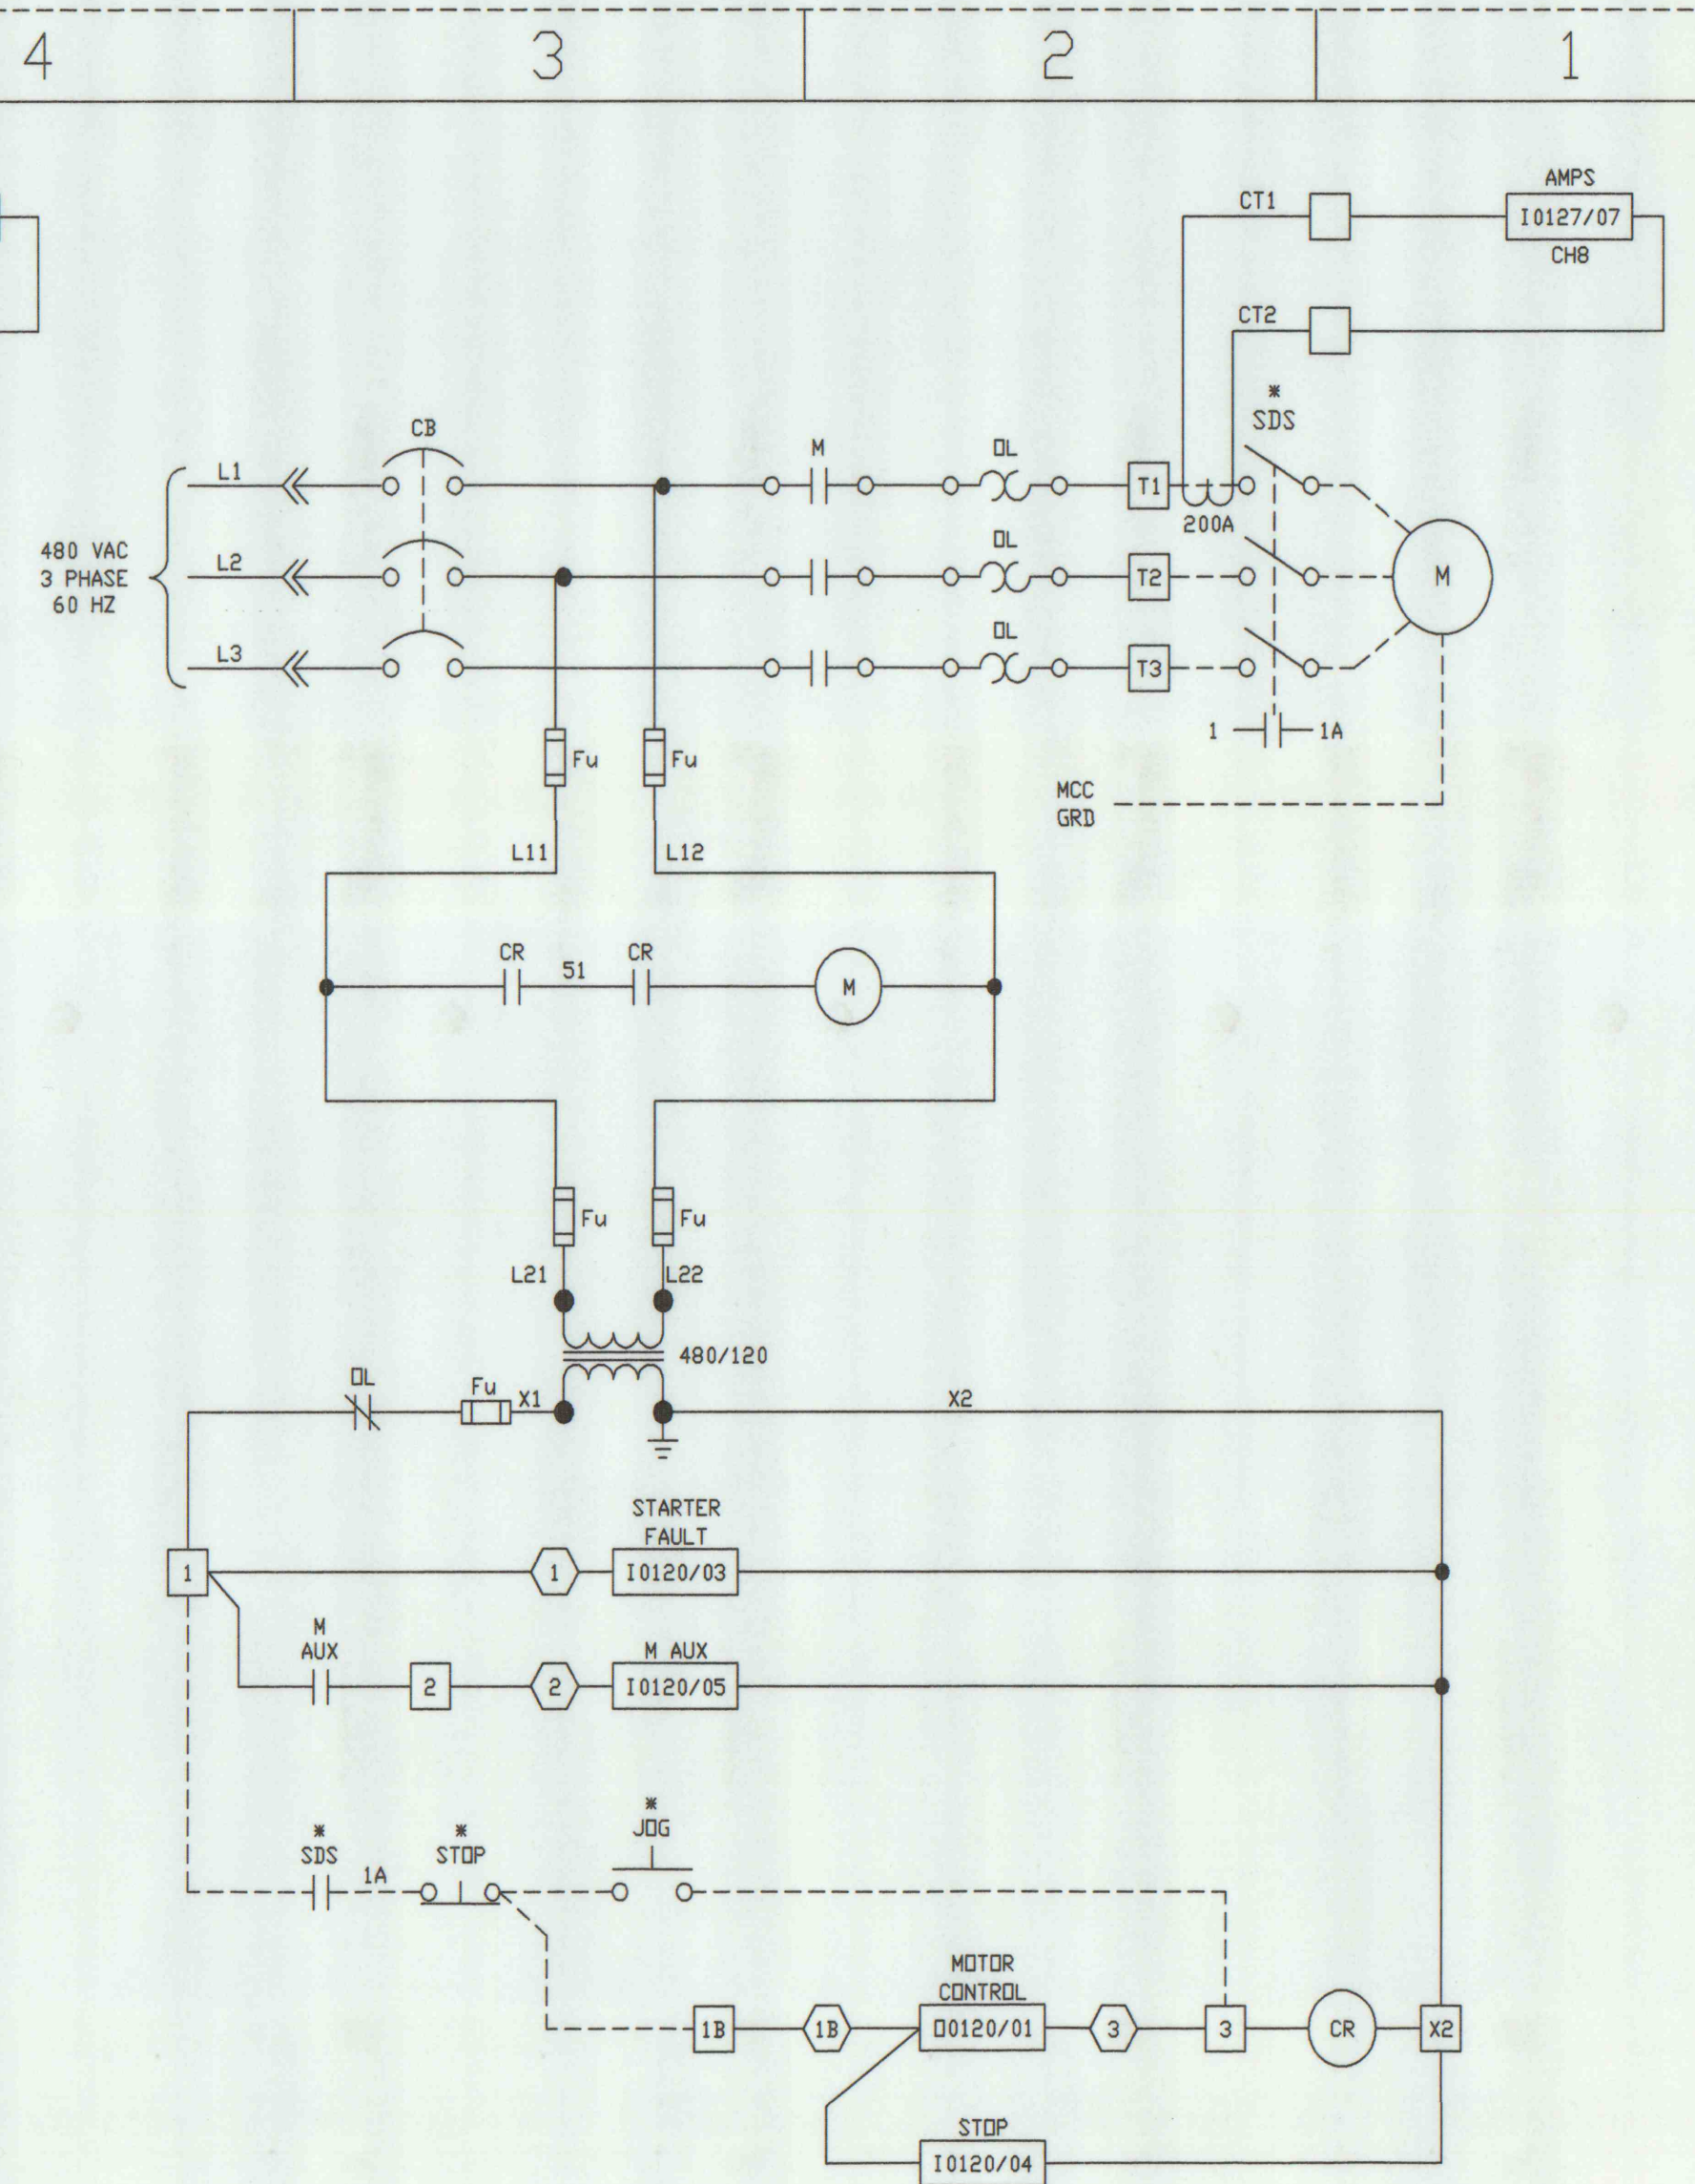

UNIT No.	DESCRIPTION	HP	MCC
24A-2	CLEAN COAL CLASSIFYING CYCLONE PUMP No. 2	150	6

 TERMINAL BLOCK IN STARTER

 TERMINAL BLOCK IN I/O RACK ENCLOSURE

----- FIELD WIRING

----- MCC & I/O RACK ENCLOSURE WIRING

* REMOTE DEVICE

~ W.G. Electric ~

THIS DRAWING IS SUPPORTED BY
AUTOCAD ELECTRONIC CAD SOFTWARE
DO NOT REVISE MANUALLY

REVISIONS	No.	DESCRIPTION	DATE	BY	CHK'D	DATE	DRAWN BY:	DATE	ROCHESTER & PITTSBURGH COAL COMPANY	SCALE	PROJECT NUMBER
	1	REVISED PER AS BUILT	10/26/95	COKE			COKE	3/20/95		NTS	94-164
	2	REVISED PER AS BUILT	12/1/95	COKE			DESIGNED BY:	DATE	KEYSTONE COAL MINING CORP.		
							CHECKED BY:	DATE	PREPARATION PLANT MODIFICATIONS	DRAWING NUMBER	FILE NUMBER
							APPROVED BY:	DATE	SCHEMATICS	EL-09	94-164-09