


10 9 8 7 6 5 4 3 2 1


A
B
C
D
E
F
G
H

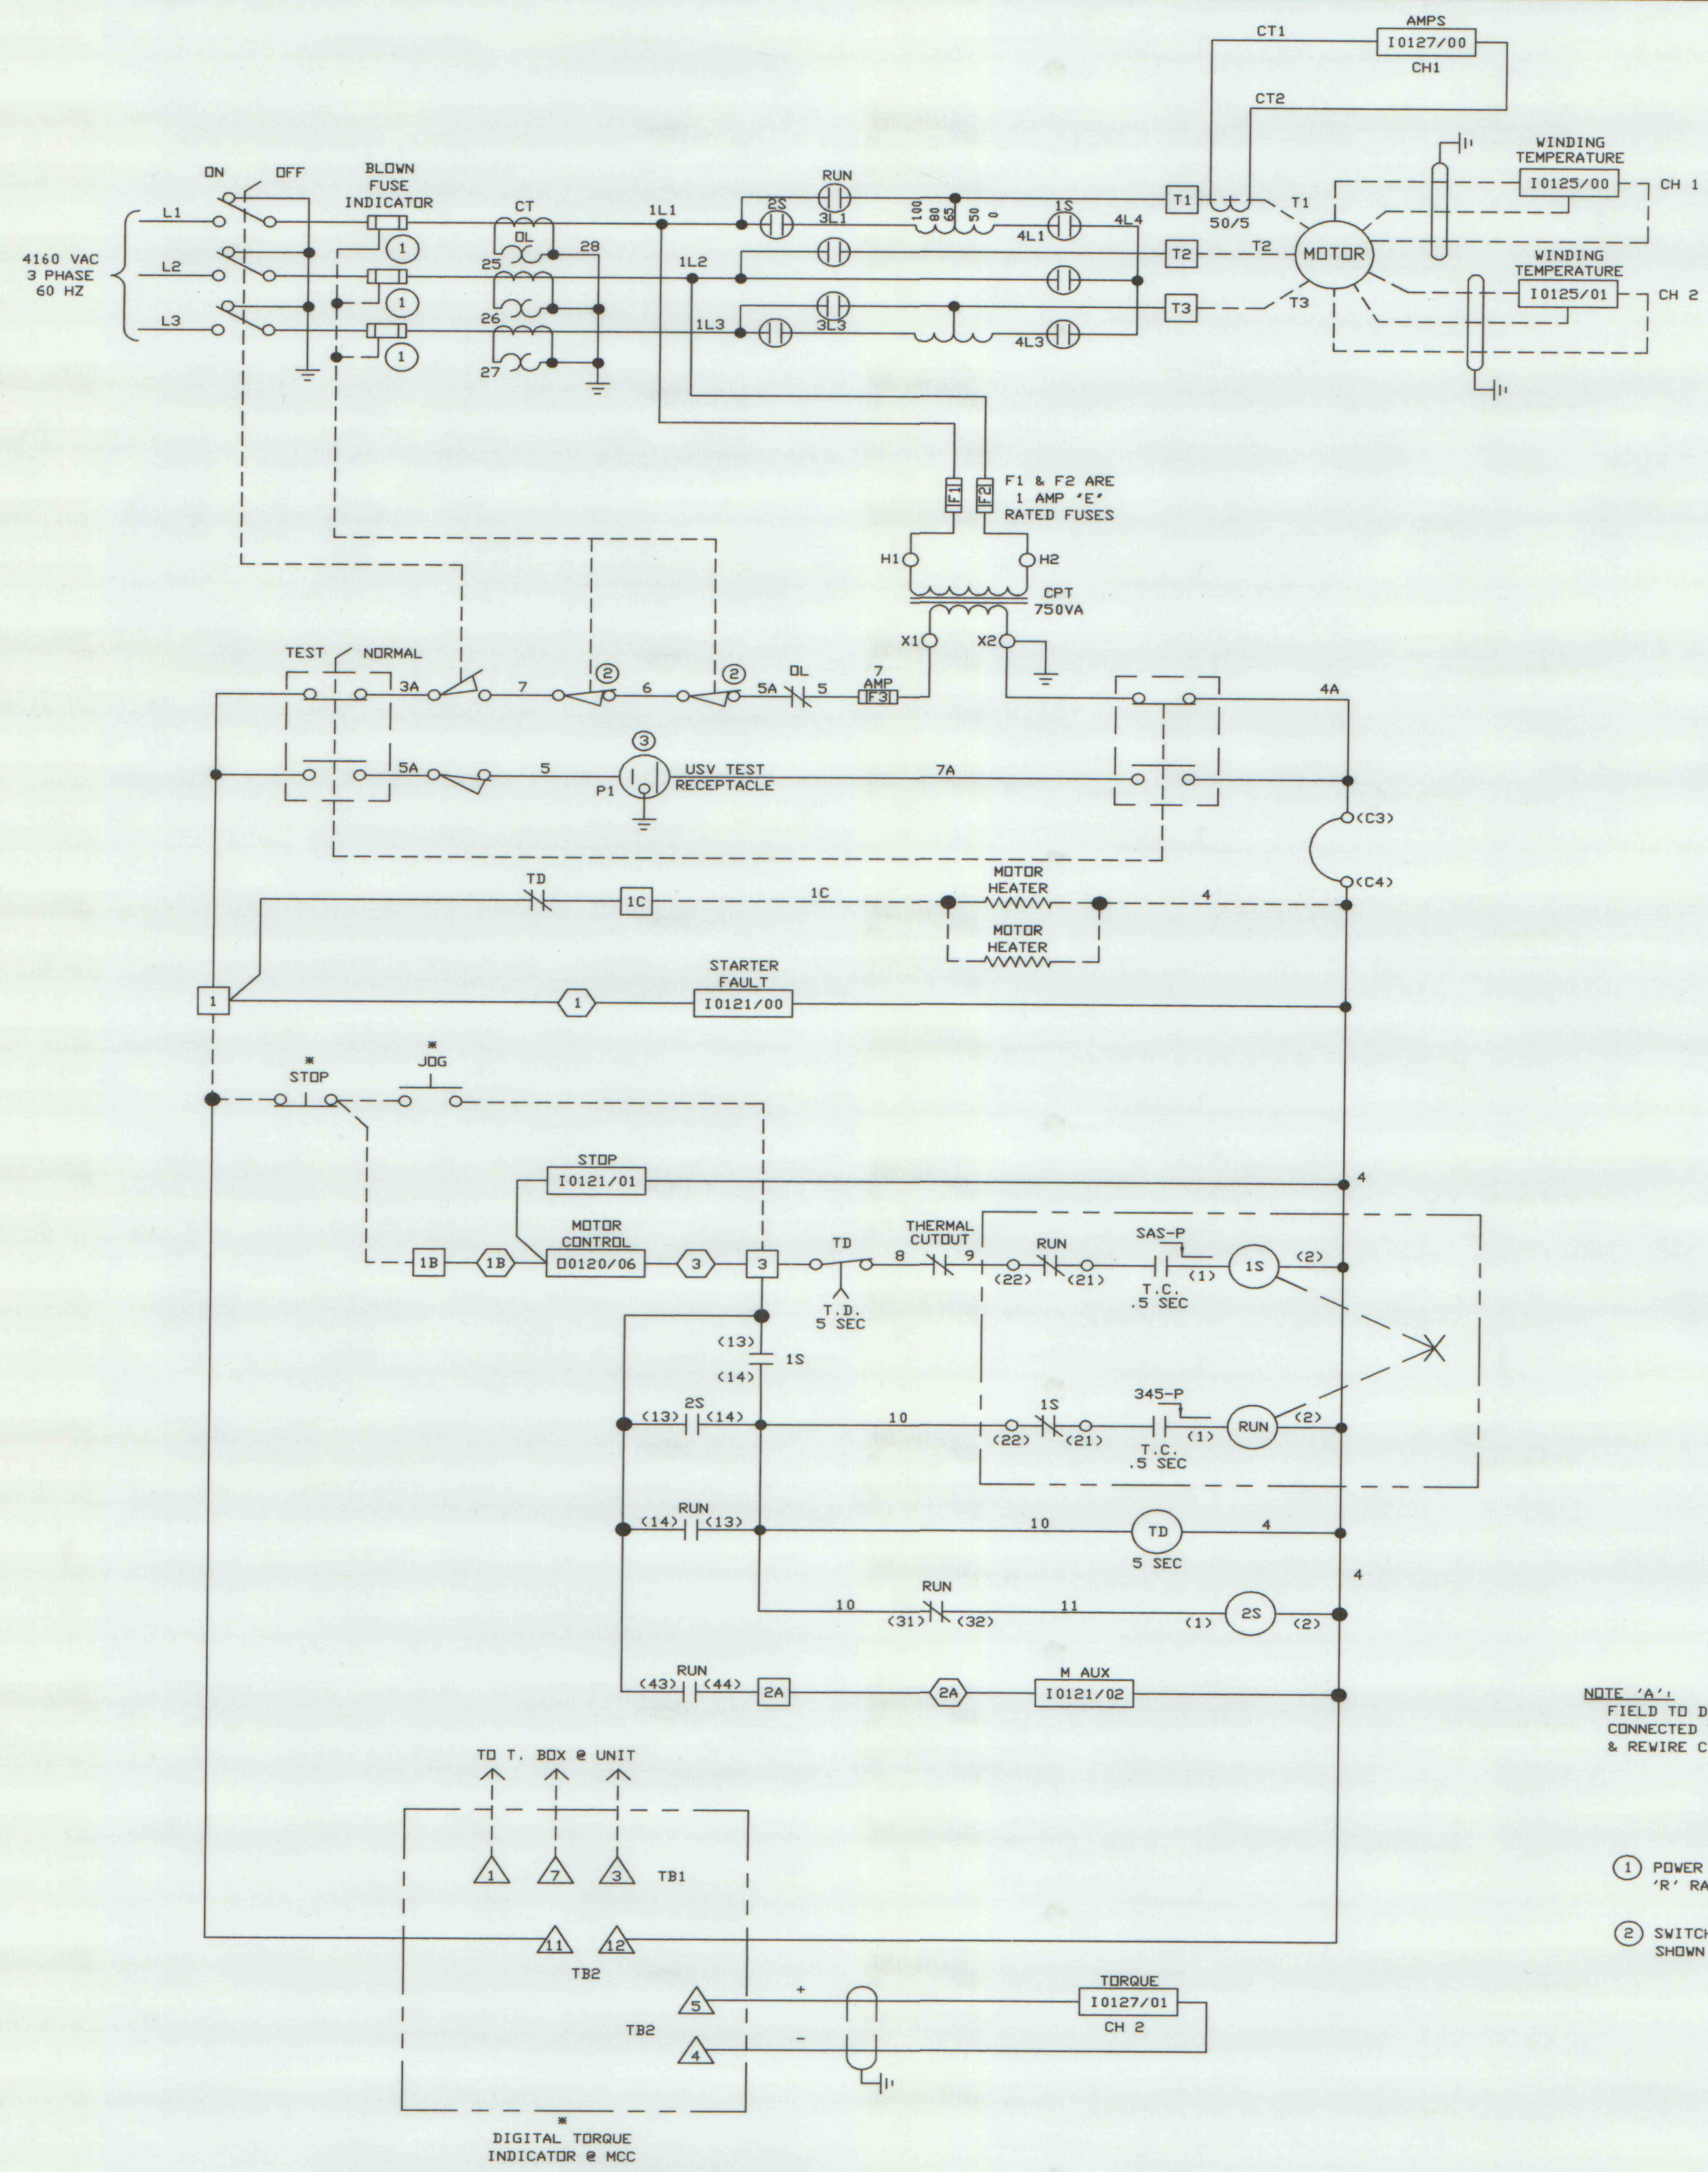

UNIT No.	DESCRIPTION	HP	MCC
129A	SCREEN BOWL CENTRIFUGE No. 1 ROTATION	250	6

NOTE 'A':
FIELD TO DISCONNECT WIRING
CONNECTED TO 'RUN' CONTACT
& REWIRE CIRCUIT AS SHOWN


- ① POWER FUSES ARE
'R' RATED
- ② SWITCHES OPEN IF FUSEBLOWS,
SHOWN WITH TRIP BAR IN PLACE

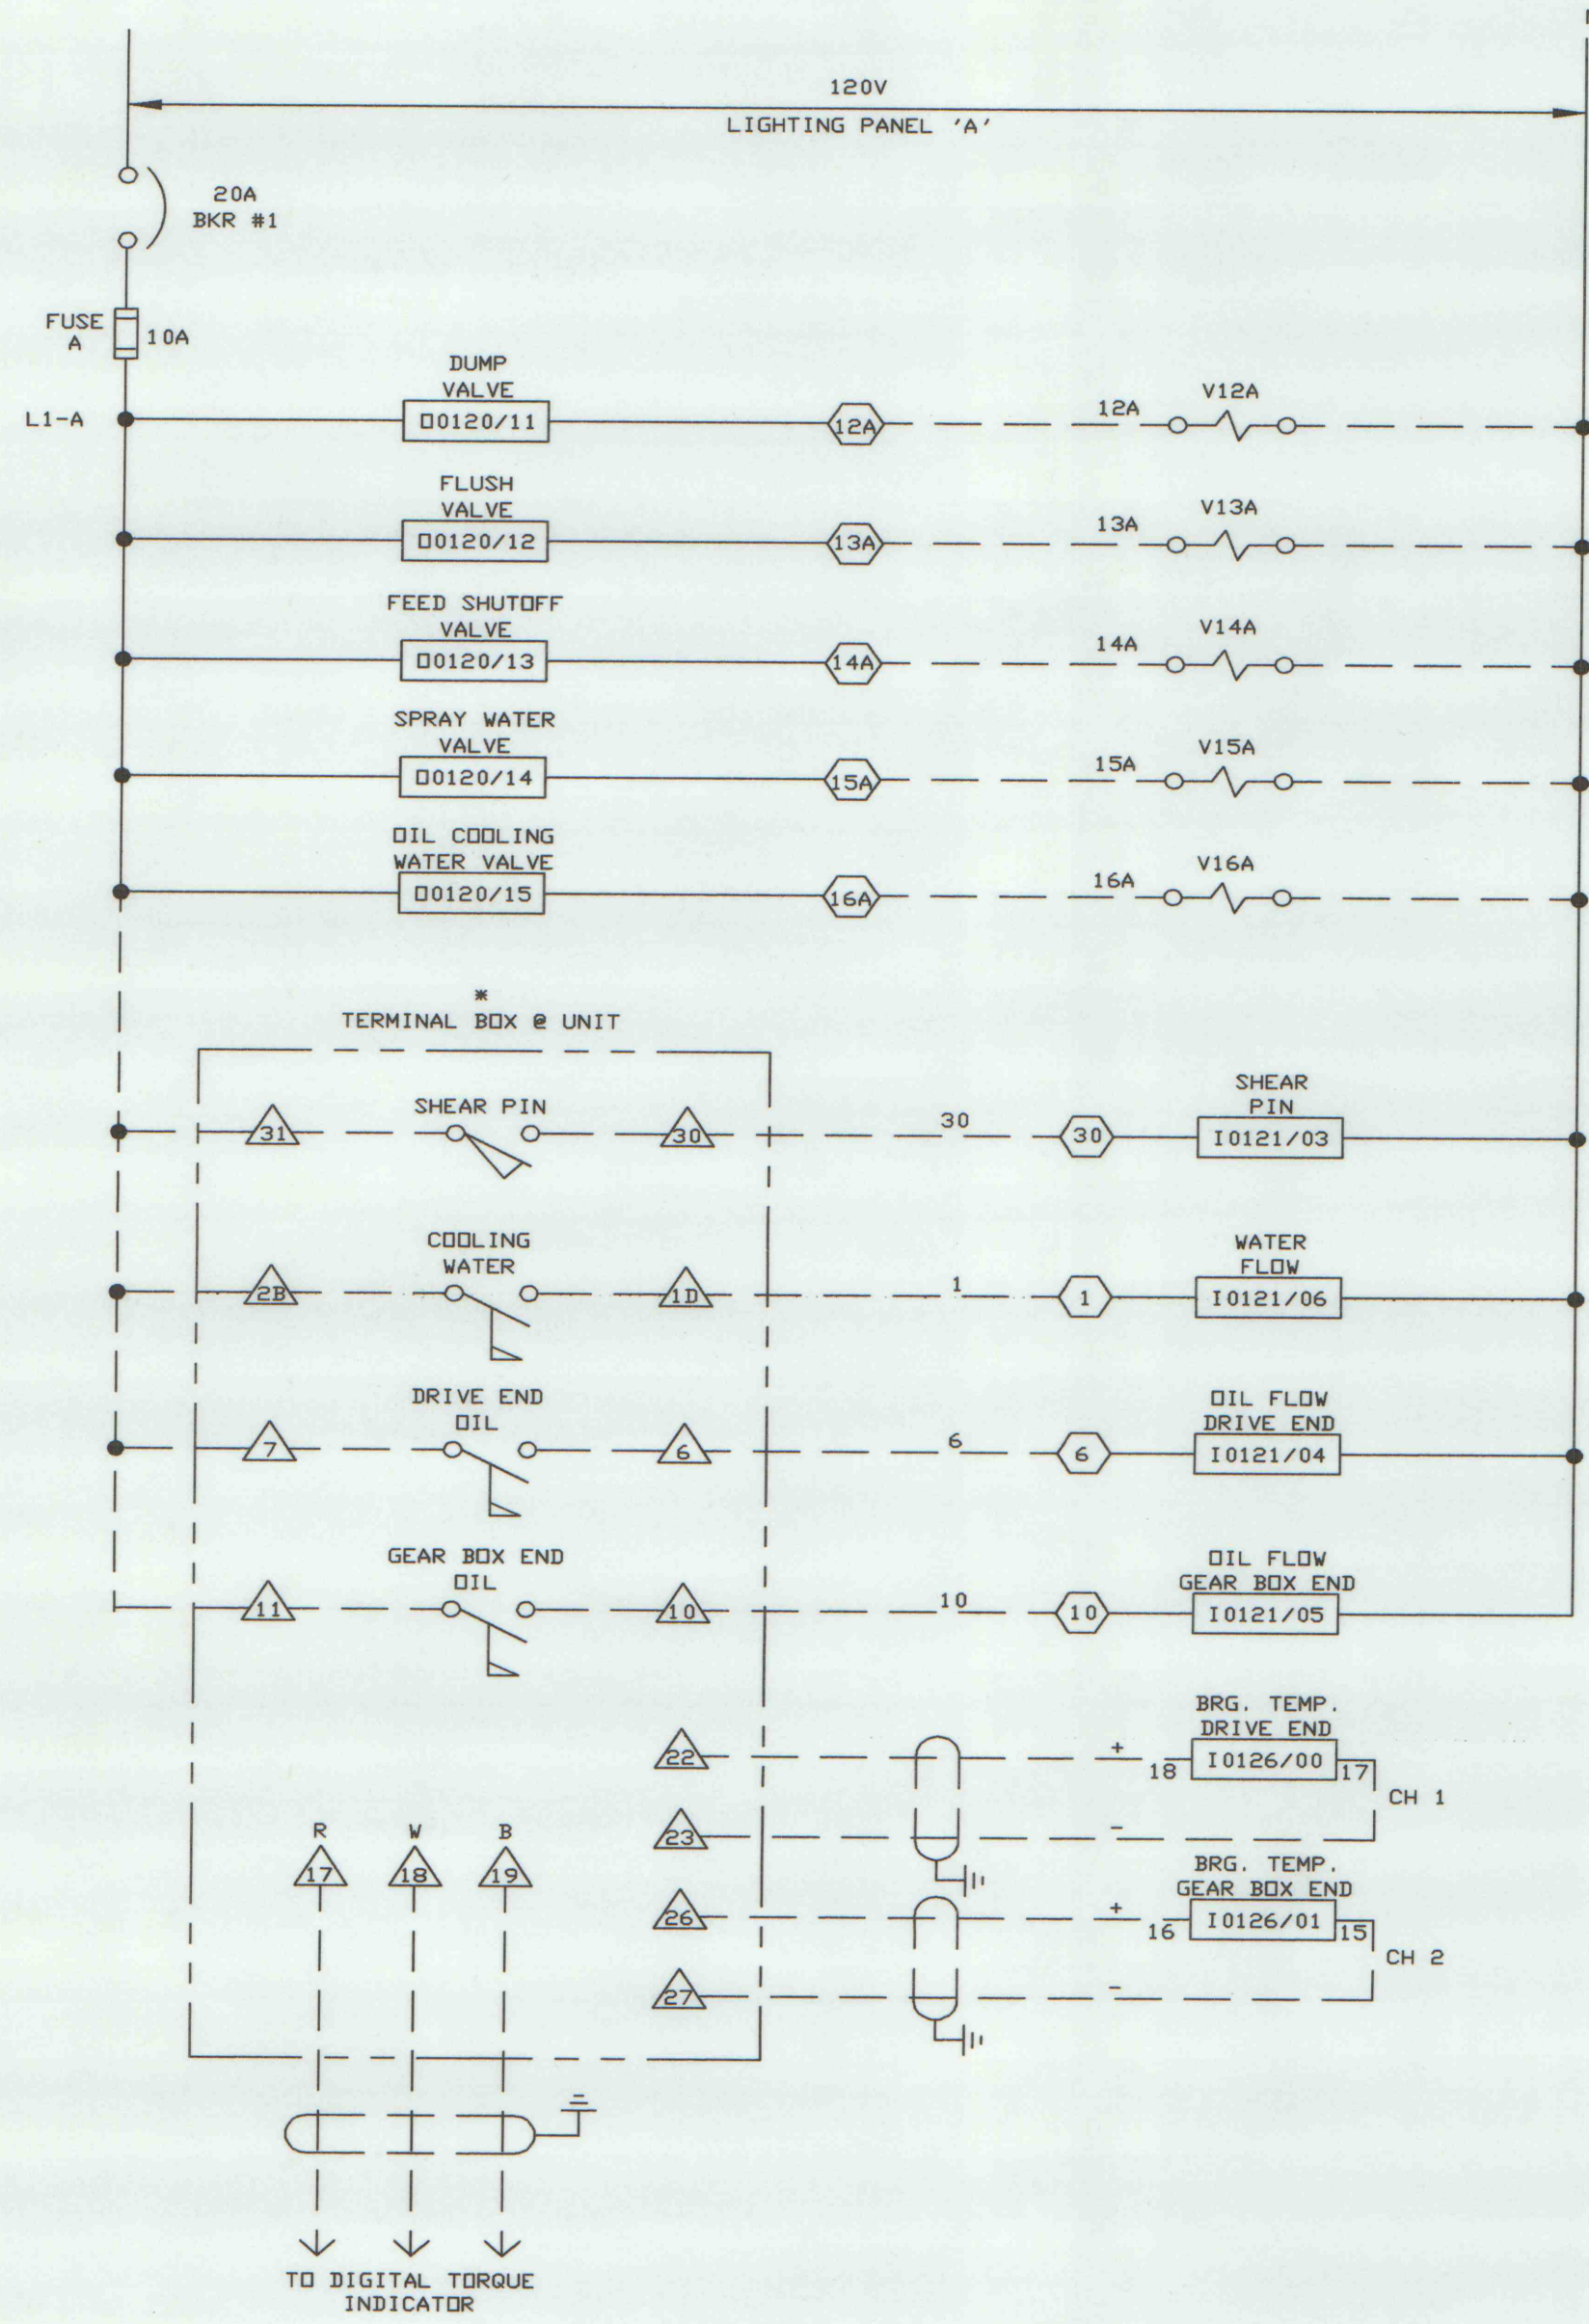

- LEGEND
- △ TERMINAL BLOCK IN VENDOR SUPPLIED EQUIPMENT
 - TERMINAL BLOCK IN STARTER
 - TERMINAL BLOCK IN I/O RACK ENCLOSURE
 - FIELD WIRING
 - MCC & I/O RACK ENCLOSURE WIRING
 - * REMOTE DEVICE

IMAPS # 15238

THIS DRAWING IS SUPPORTED BY
AUTOCAD ELECTRONIC CAD SOFTWARE
DO NOT REVISE MANUALLY

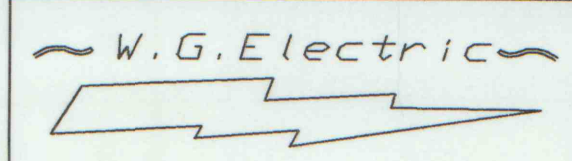

No.	DESCRIPTION	DATE	BY	CHK'D.	DATE	DRAWN BY:	COKE	DATE 3/28/95	ROCHESTER & PITTSBURGH COAL COMPANY	SCALE	PROJECT NUMBER
1	REVISED PER AS BUILT	10/27/95	COKE			DESIGNED BY:	R.F.	DATE 5/13/95	KEYSTONE COAL MINING CORP.	NTS	94-164
2	REVISED PER AS BUILT	12/1/95	COKE			CHECKED BY:		DATE	PREPARATION PLANT MODIFICATIONS	DRAWING NUMBER	FILE NUMBER
						APPROVED BY:		DATE	SCHEMATICS	EL-11	94-164-11