


10 9 8 7 6 5 4 3 2 1


A
B
C
D
E
F
G
H

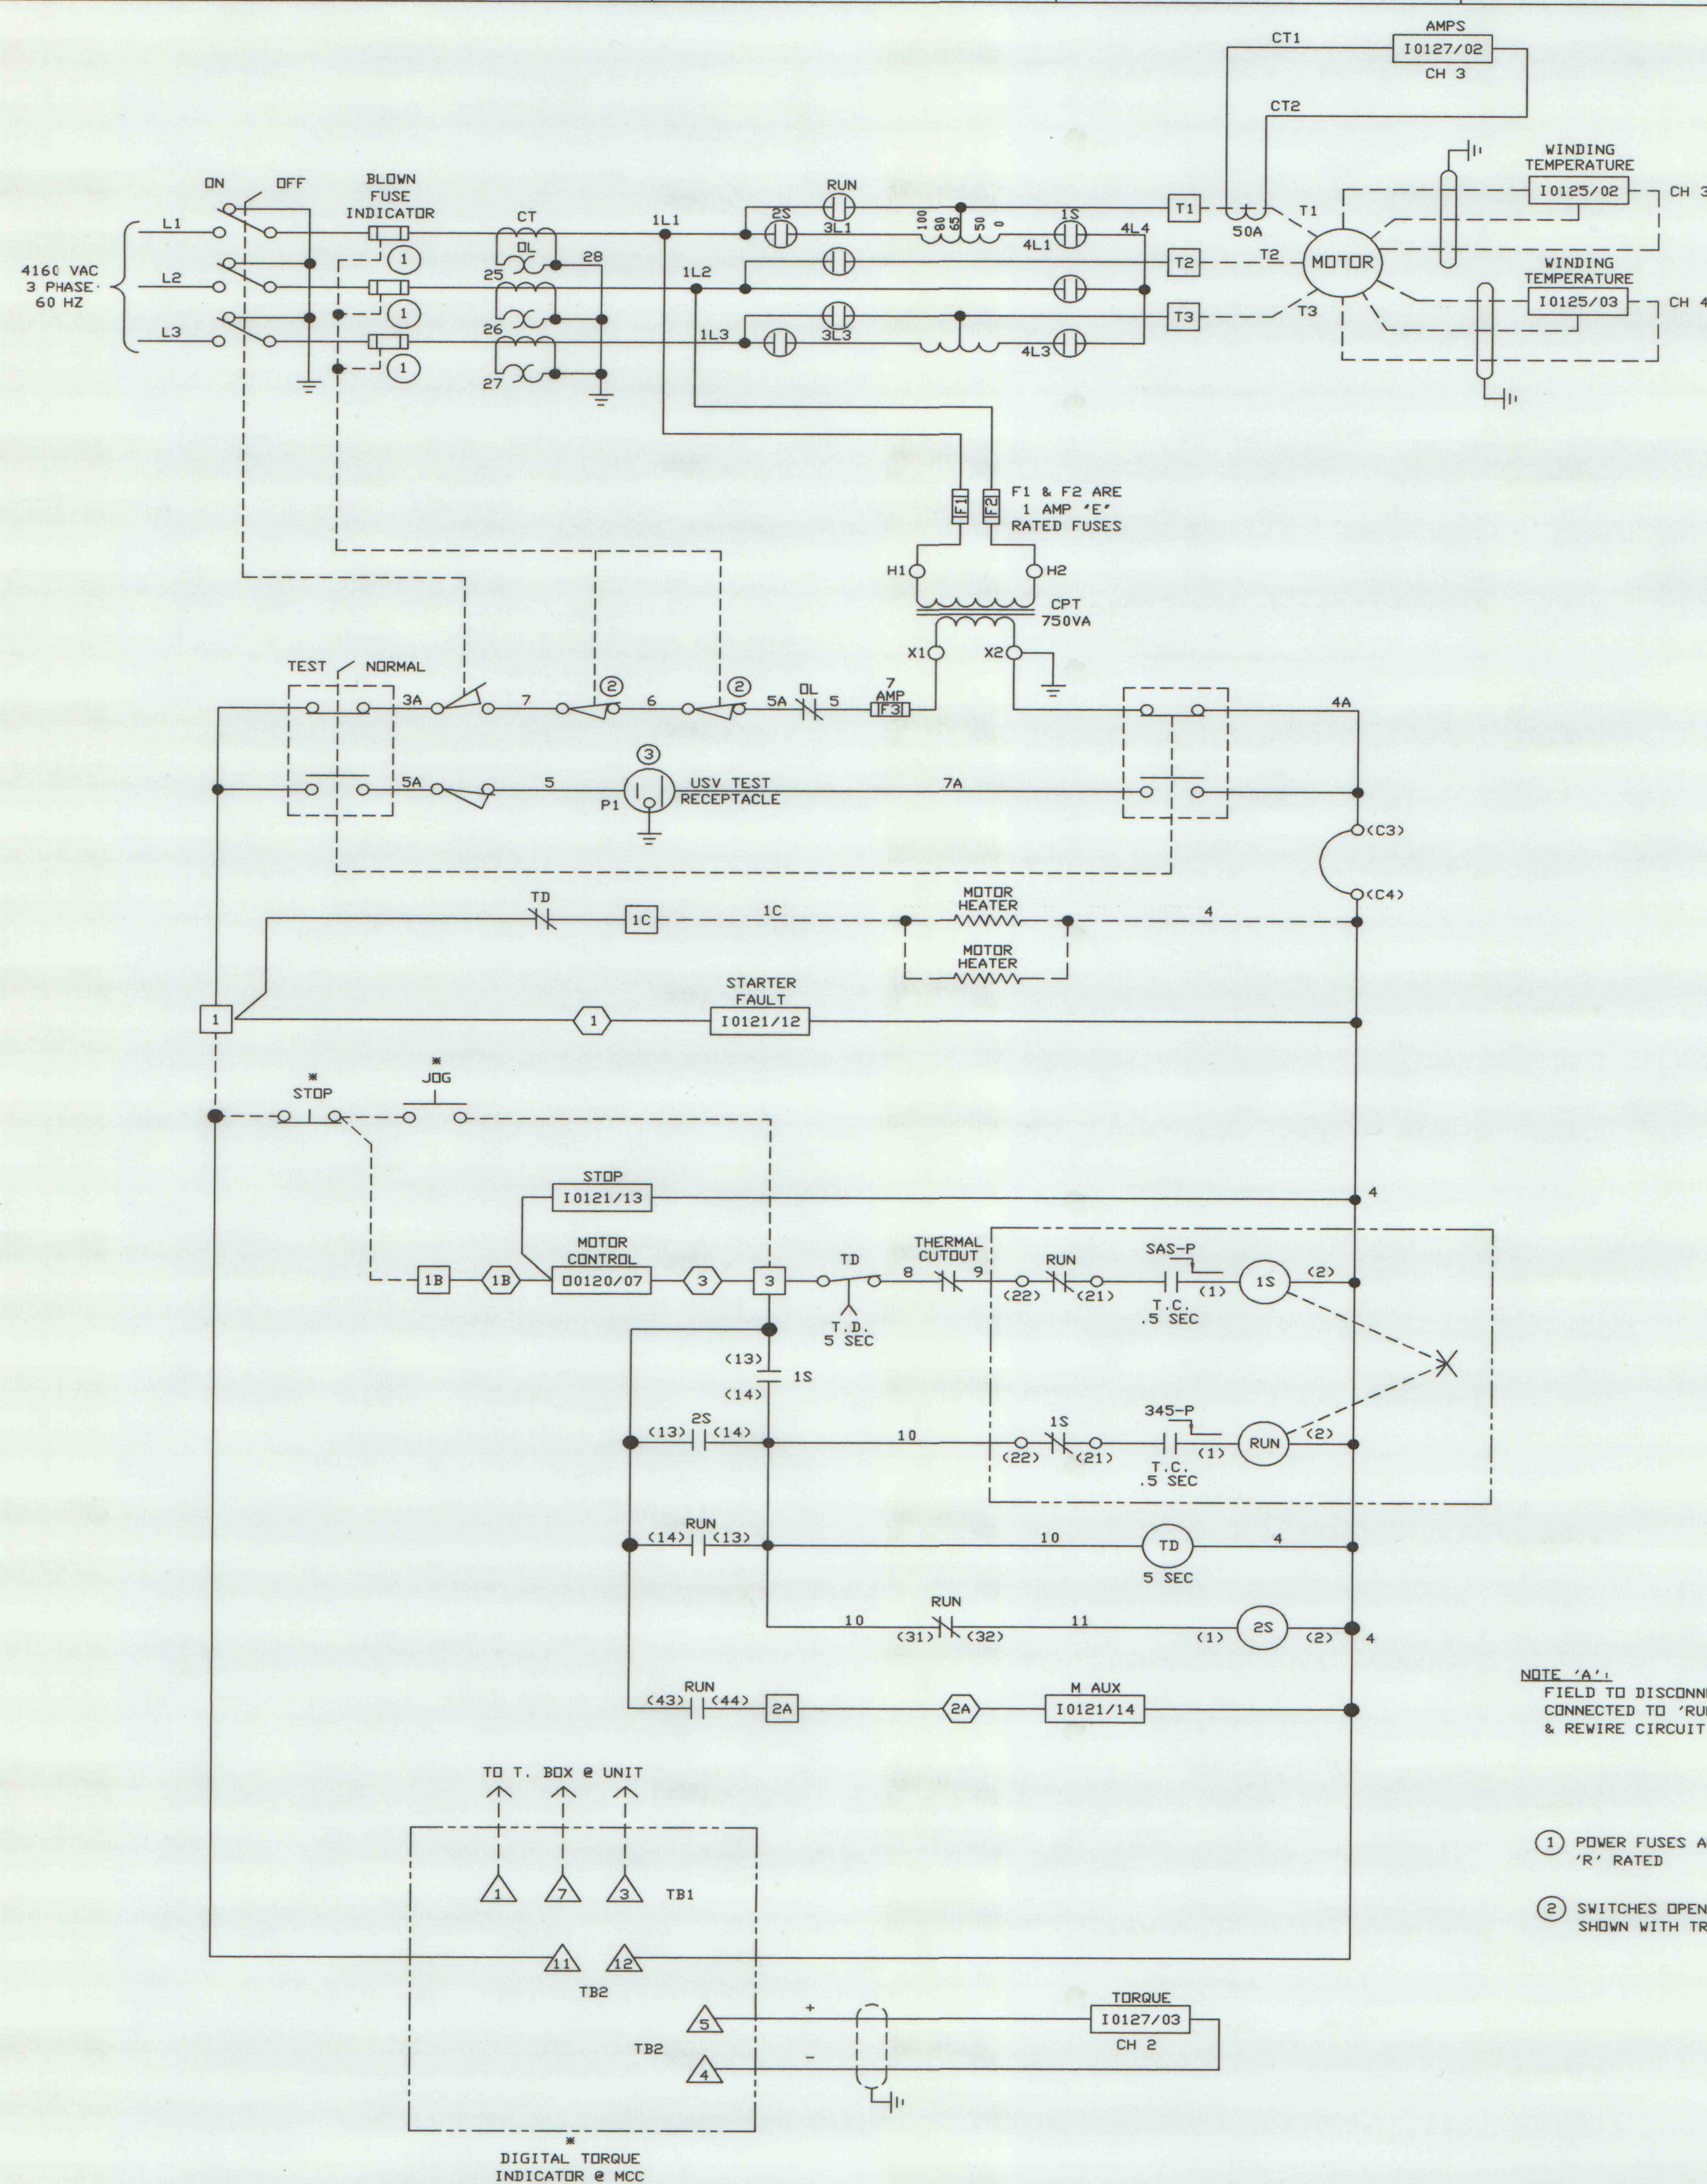

NOTE: 'A' FIELD TO DISCONNECT WIRING CONNECTED TO 'RUN' CONTACT & REVIRE CIRCUIT AS SHOWN

① POWER FUSES ARE 'R' RATED

② SWITCHES OPEN IF FUSEBLOWS, SHOWN WITH TRIP BAR IN PLACE

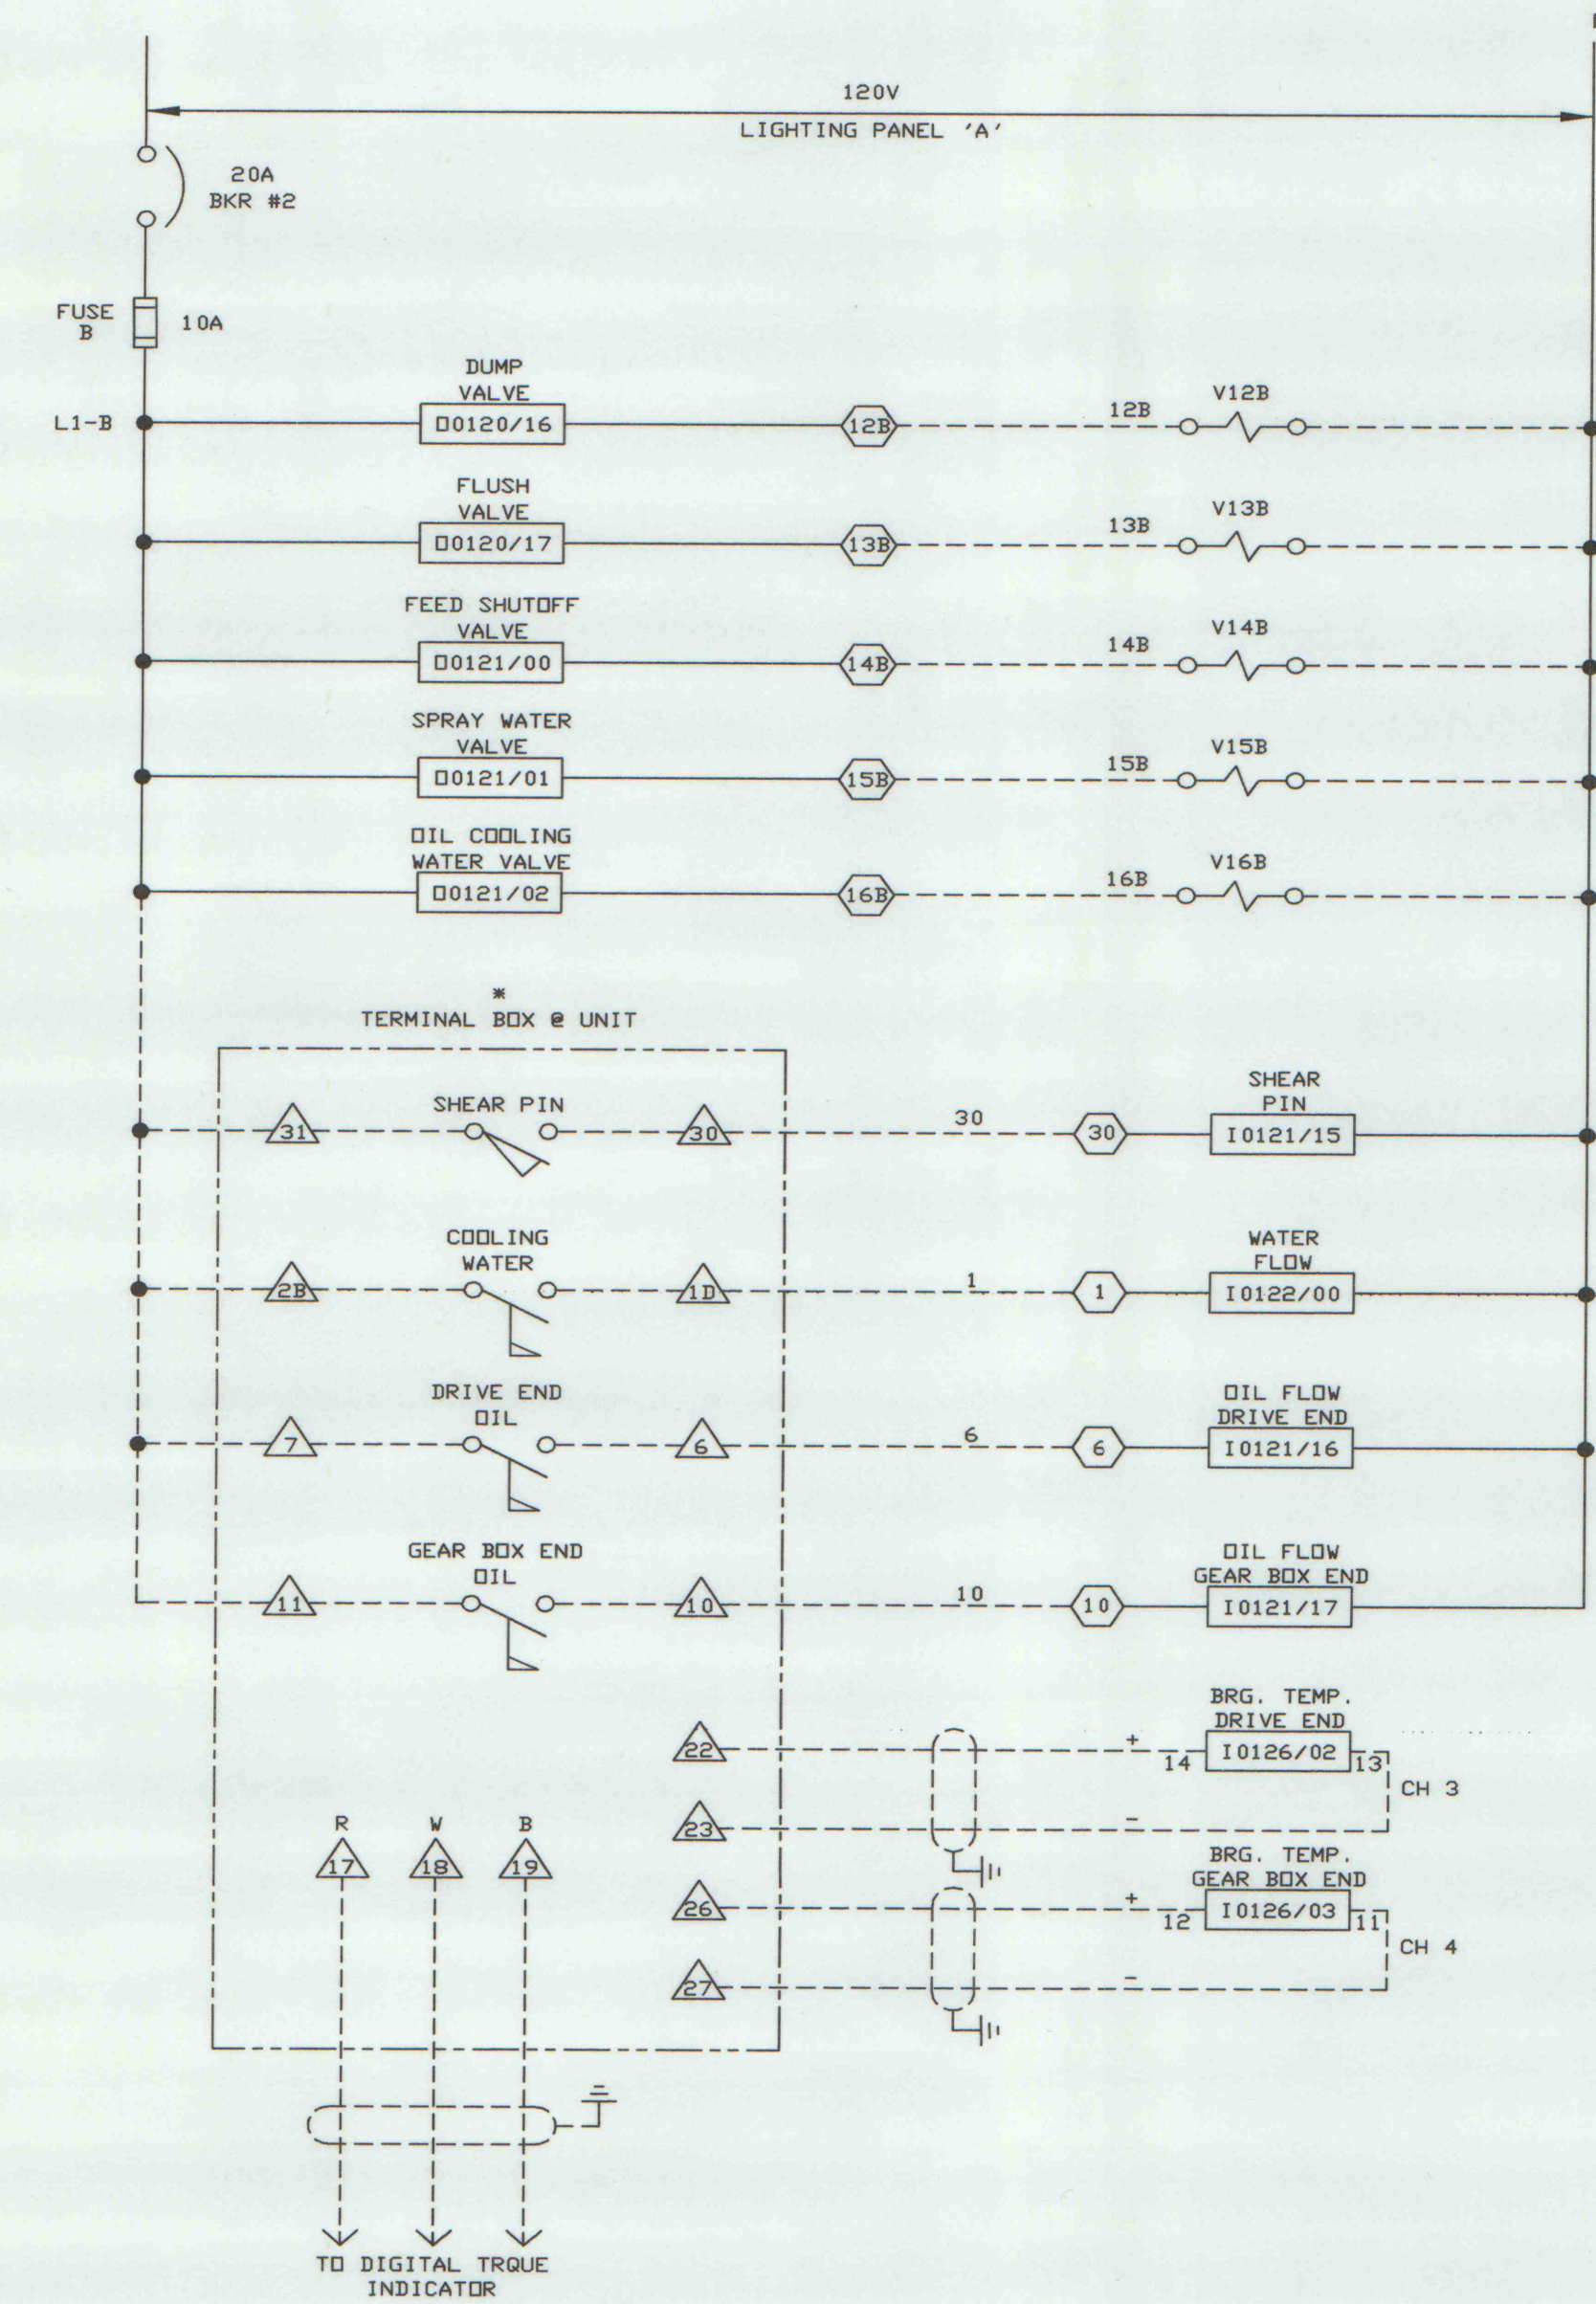

LEGEND

- △ TERMINAL BLOCK IN VENDOR SUPPLIED EQUIPMENT
- TERMINAL BLOCK IN STARTER
- ⬡ TERMINAL BLOCK IN I/O RACK ENCLOSURE
- FIELD WIRING
- MCC & I/O RACK ENCLOSURE WIRING
- * REMOTE DEVICE

UNIT No.	DESCRIPTION	HP	MCC
129B	SCREEN BOWL CENTRIFUGE No. 2 ROTATION	250	6

REV	No.	DESCRIPTION	DATE	BY	CHK'D	DATE	DRAWN BY	DATE	DESIGNED BY	DATE	CHECKED BY	DATE	APPROVED BY	DATE	SCALE	PROJECT NUMBER
1	1	REVISED PER AS BUILT	10/27/95	COKE				3/20/95		5/13/95					ROCHESTER & PITTSBURGH COAL COMPANY	94-164
2	2	REVISED PER AS BUILT	12/1/95	COKE											KEYSTONE COAL MINING CORP.	94-164
															PREPARATION PLANT MODIFICATIONS	FILE NUMBER
															SCHEMATICS	94-164-12

THIS DRAWING IS SUPPORTED BY AUTOCAD ELECTRONIC CAD SOFTWARE DO NOT REVISE MANUALLY



IMAPS # 15239

11480 A