



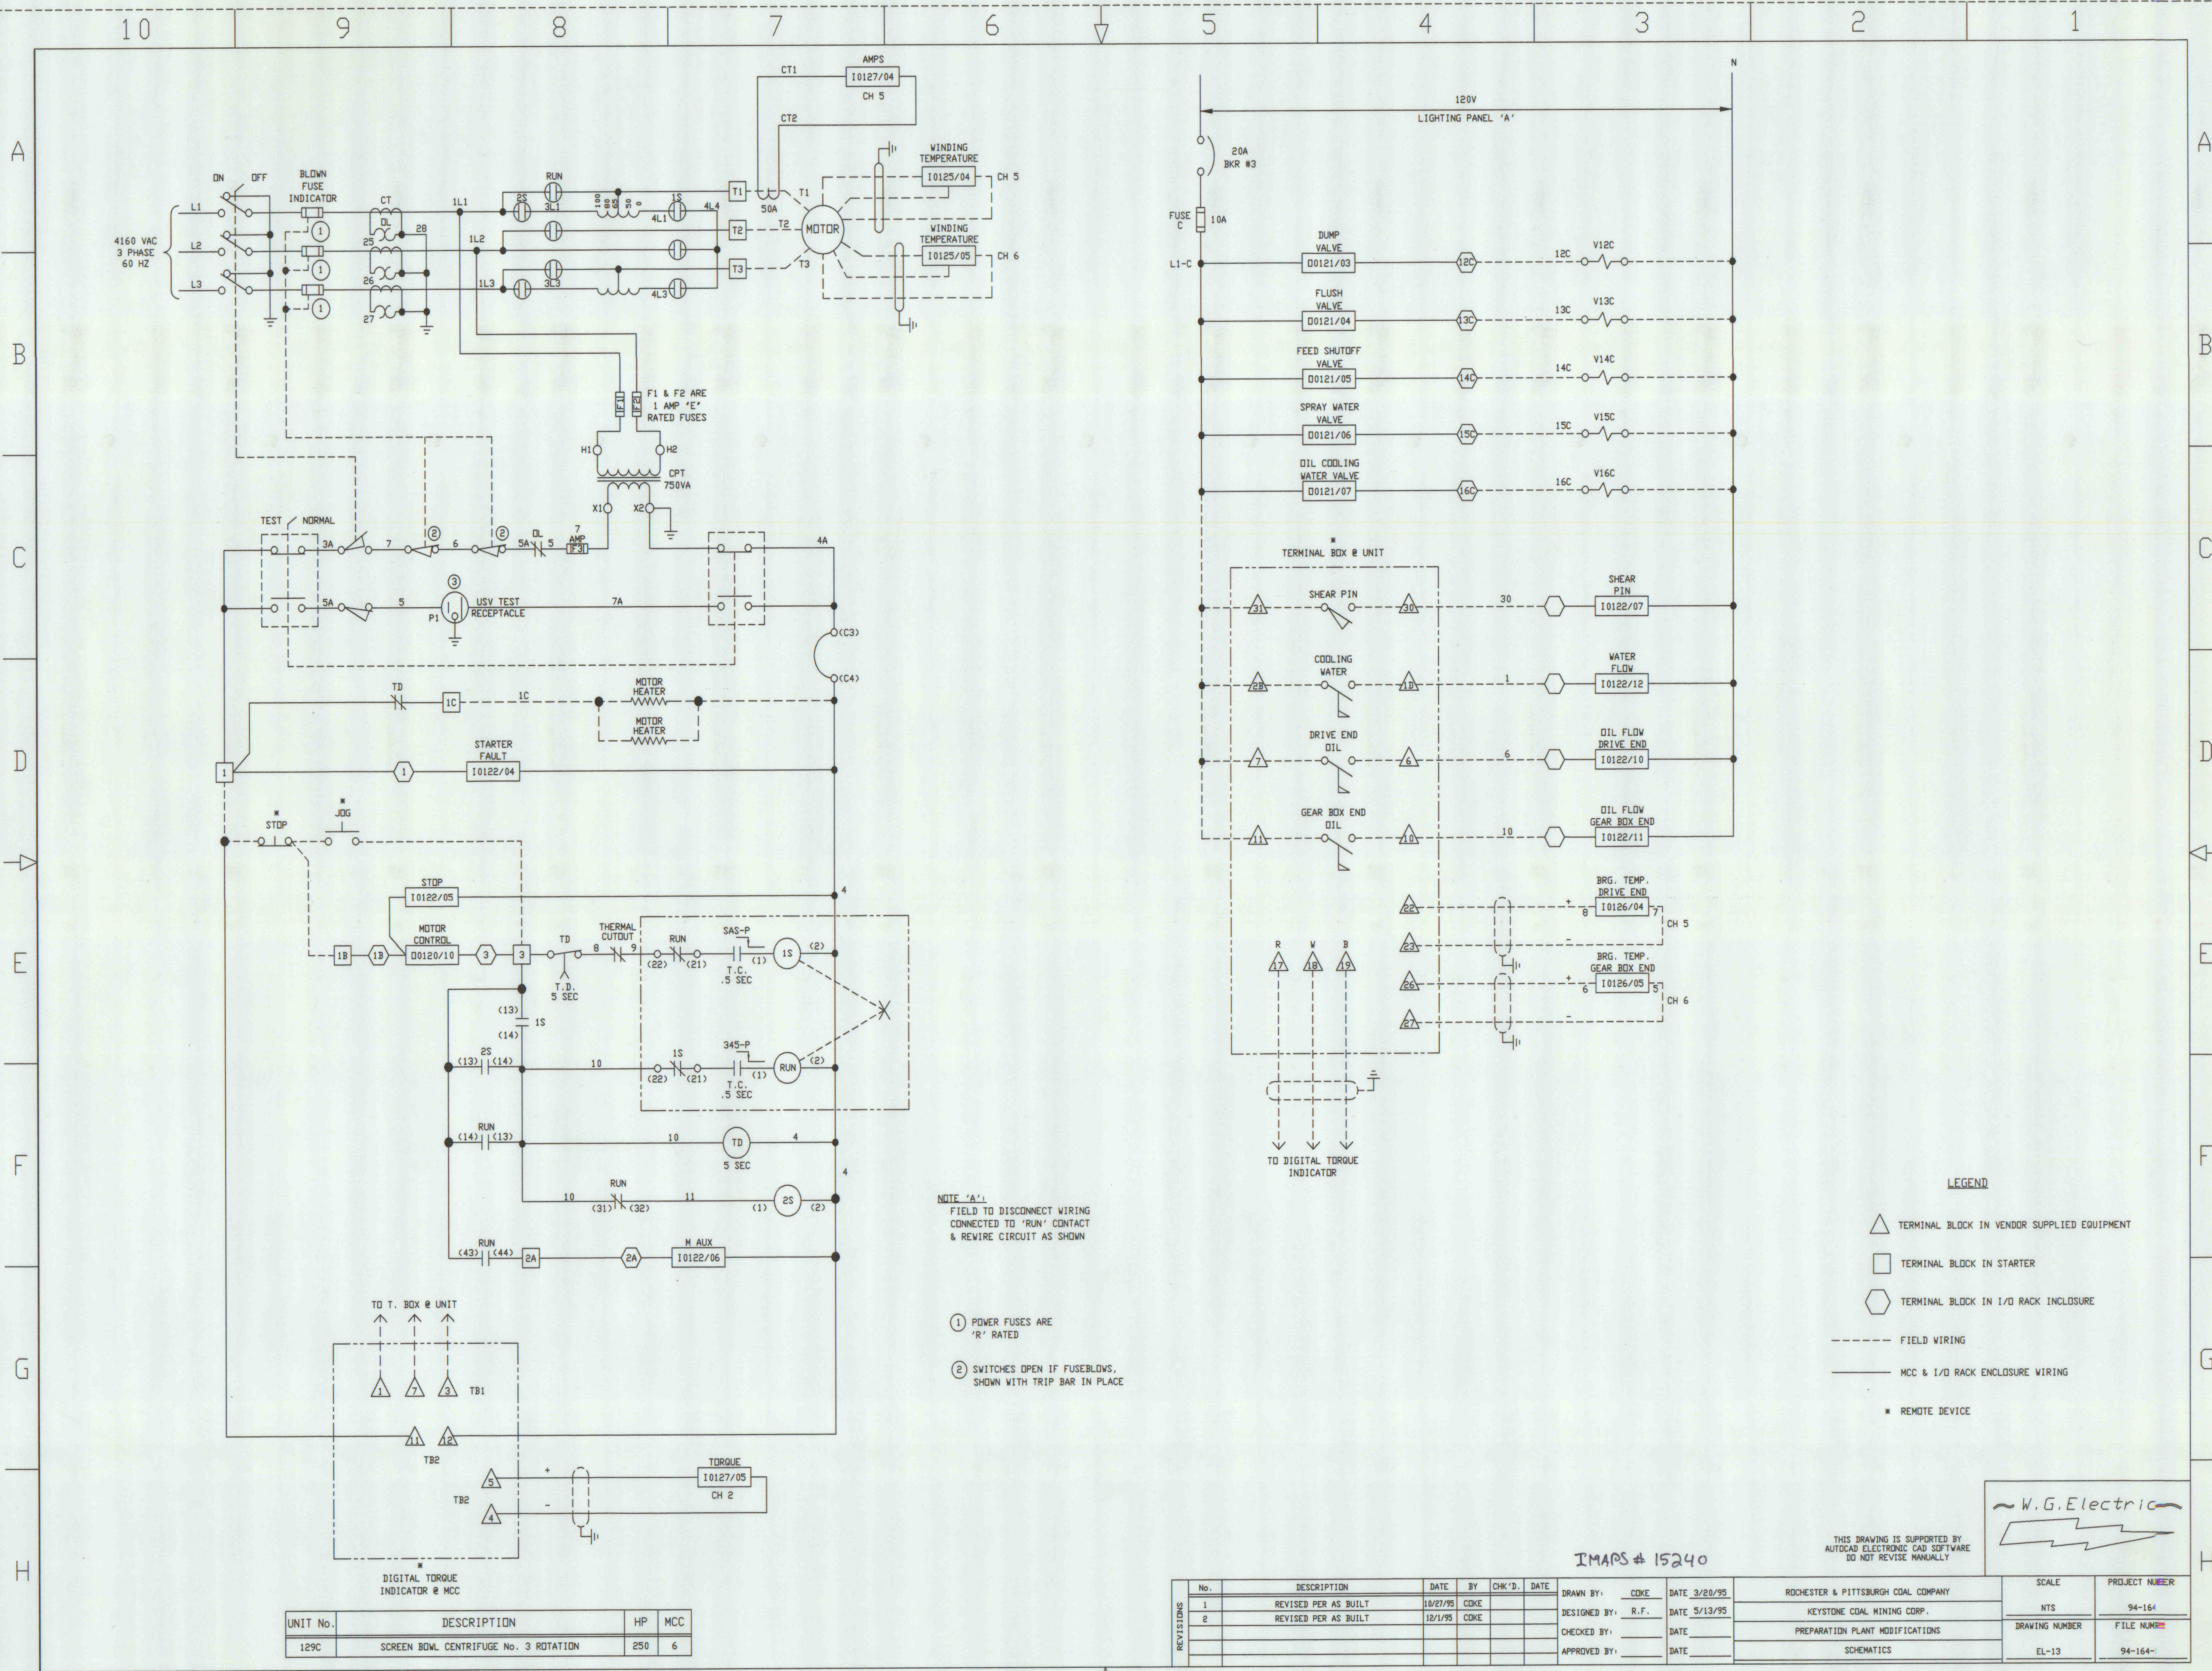

NOTE 'A':
FIELD TO DISCONNECT WIRING
CONNECTED TO 'RUN' CONTACT
& REWIRE CIRCUIT AS SHOWN

① POWER FUSES ARE
'R' RATED

② SWITCHES OPEN IF FUSEBLOWS,
SHOWN WITH TRIP BAR IN PLACE

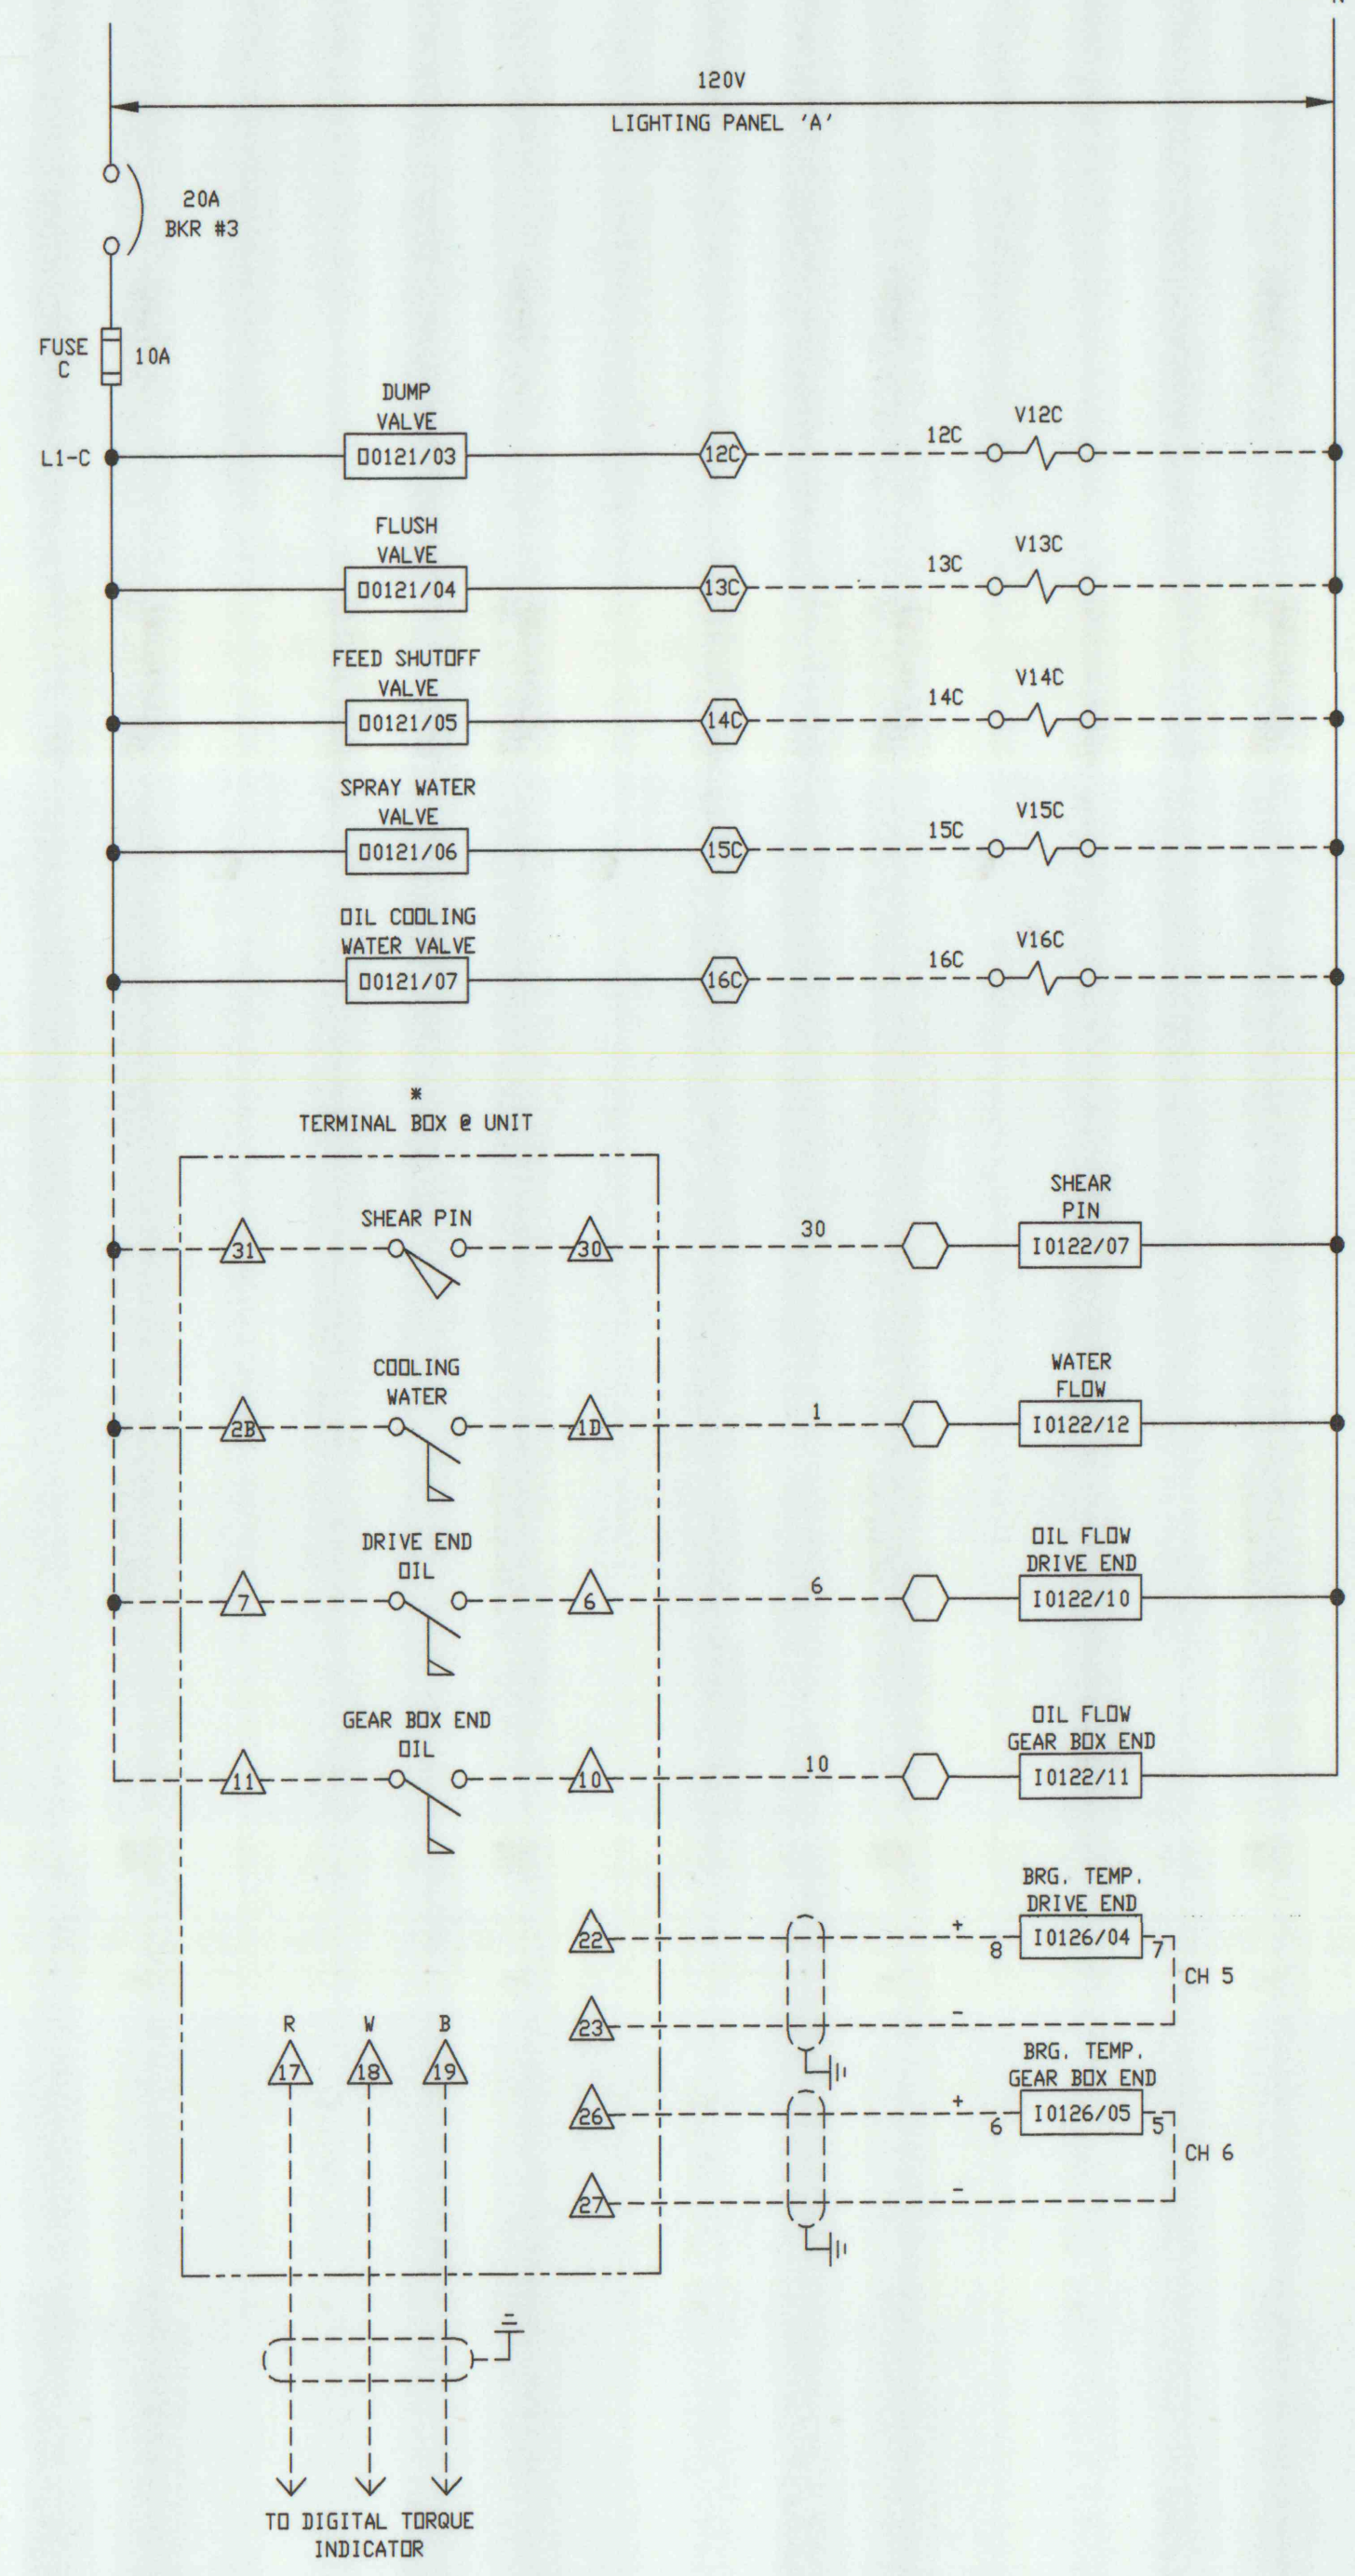

- LEGEND
- △ TERMINAL BLOCK IN VENDOR SUPPLIED EQUIPMENT
 - TERMINAL BLOCK IN STARTER
 - ⬡ TERMINAL BLOCK IN I/O RACK ENCLOSURE
 - FIELD WIRING
 - MCC & I/O RACK ENCLOSURE WIRING
 - * REMOTE DEVICE

UNIT No.	DESCRIPTION	HP	MCC
129C	SCREEN BOWL CENTRIFUGE No. 3 ROTATION	250	6

No.	DESCRIPTION	DATE	BY	CHK'D.	DATE
1	REVISED PER AS BUILT	10/27/95	COKE		
2	REVISED PER AS BUILT	12/1/95	COKE		

IMAPS # 15240

DESIGNED BY: R.F.	DATE: 5/13/95	ROCHESTER & PITTSBURGH COAL COMPANY	SCALE: NTS	PROJECT NUMBER: 94-164
CHECKED BY:	DATE:	KEYSTONE COAL MINING CORP.	DRAWING NUMBER: EL-13	FILE NUMBER: 94-164
APPROVED BY:	DATE:	PREPARATION PLANT MODIFICATIONS		
		SCHEMATICS		

THIS DRAWING IS SUPPORTED BY
AUTOCAD ELECTRONIC CAD SOFTWARE
DO NOT REVISE MANUALLY

