



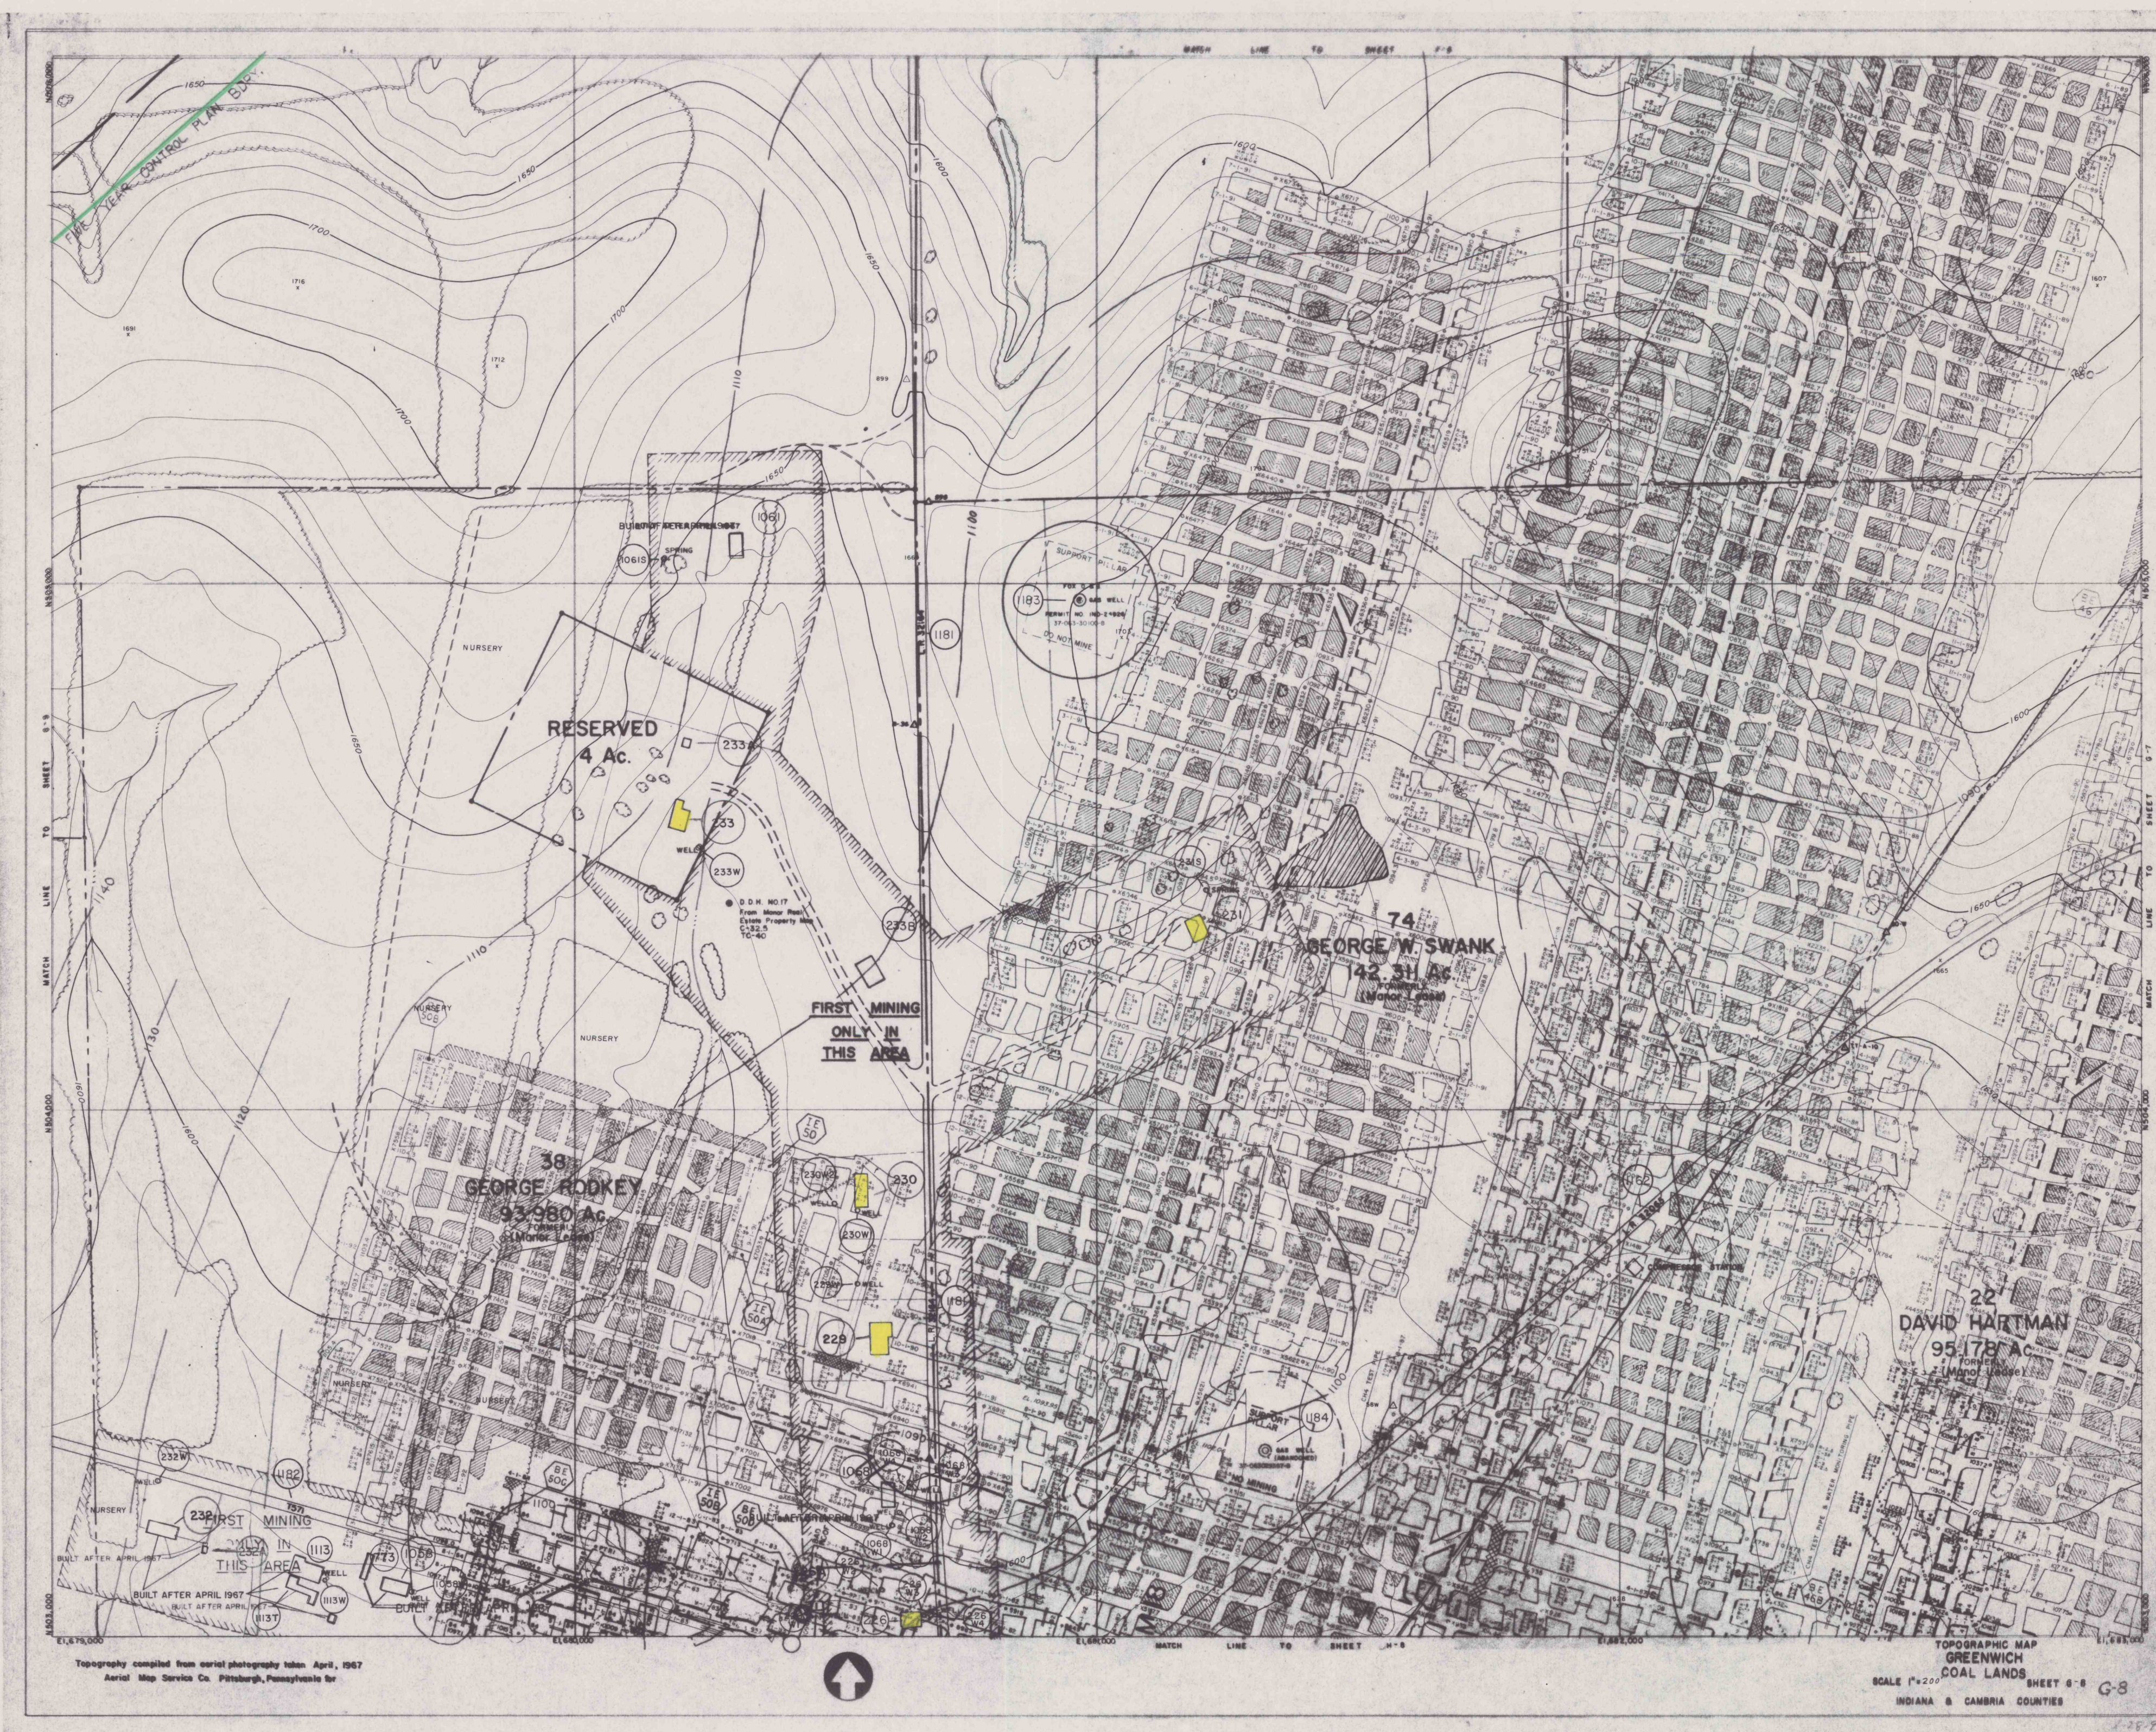

RECEIVED

APR 29 1992

Dept. of Environmental Resources
McMurray District Office

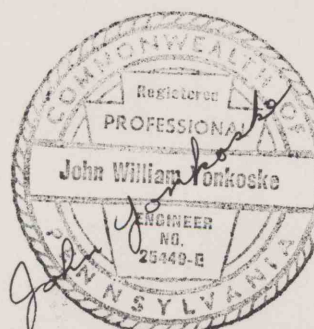

4-24-92

GREENWICH COLLIERIES
NO'S 1 AND 2 MINES
DIV. OF PENNSYLVANIA MINES CORP.

LOWER FREEPORT "D" SEAM

GREEN & MONTGOMERY TWP. INDIANA COUNTY, PA.
SCALE 1"=200' FINAL SURVEY DATE 3-28-92

- DWELLINGS & CEMETERIES (IN PLACE BEFORE 1966 ACT) [Yellow box]
- PUBLIC BUILDINGS; IMPOUNDMENTS (PLUS 20 AC. FEET) [Red box]
- BOUNDARY OF MINE [Red line]
- POLITICAL SUBDIVISION BOUNDARIES [Purple line]
- SIX MONTH SUBSIDENCE CONTROL BOUNDARY [Dashed line]
- FIVE YEAR SUBSIDENCE CONTROL BOUNDARY [Green line]
- PILLARS EXTRACTED [Hatched box]
- CALCULATED SUPPORT AREA [Dotted box]
- COAL PILLAR SUPPORT AREA [Dotted box]
- OUTCROP OF "D" SEAM [Symbol]
- FEATURE IDENTIFICATION NO. [Circle with number]
- MINING IN SUPPORT AREAS WILL BE ON PROJECTED CENTERLINES WITH ENTRY WIDTHS NOT TO EXCEED 20 FEET EXCEPT IN COMBINATION BELT/TRACK ENTRIES WITH ENTRY WIDTH NOT TO EXCEED 22 FEET
- MINERAL OWNERSHIP [Symbol]
- SURFACE OWNERSHIP (ON PROPERTY MAP PRINTS) [Symbol]

JOHN DOE
00 000 AC.
(Frac./Lease)

01-1-01