


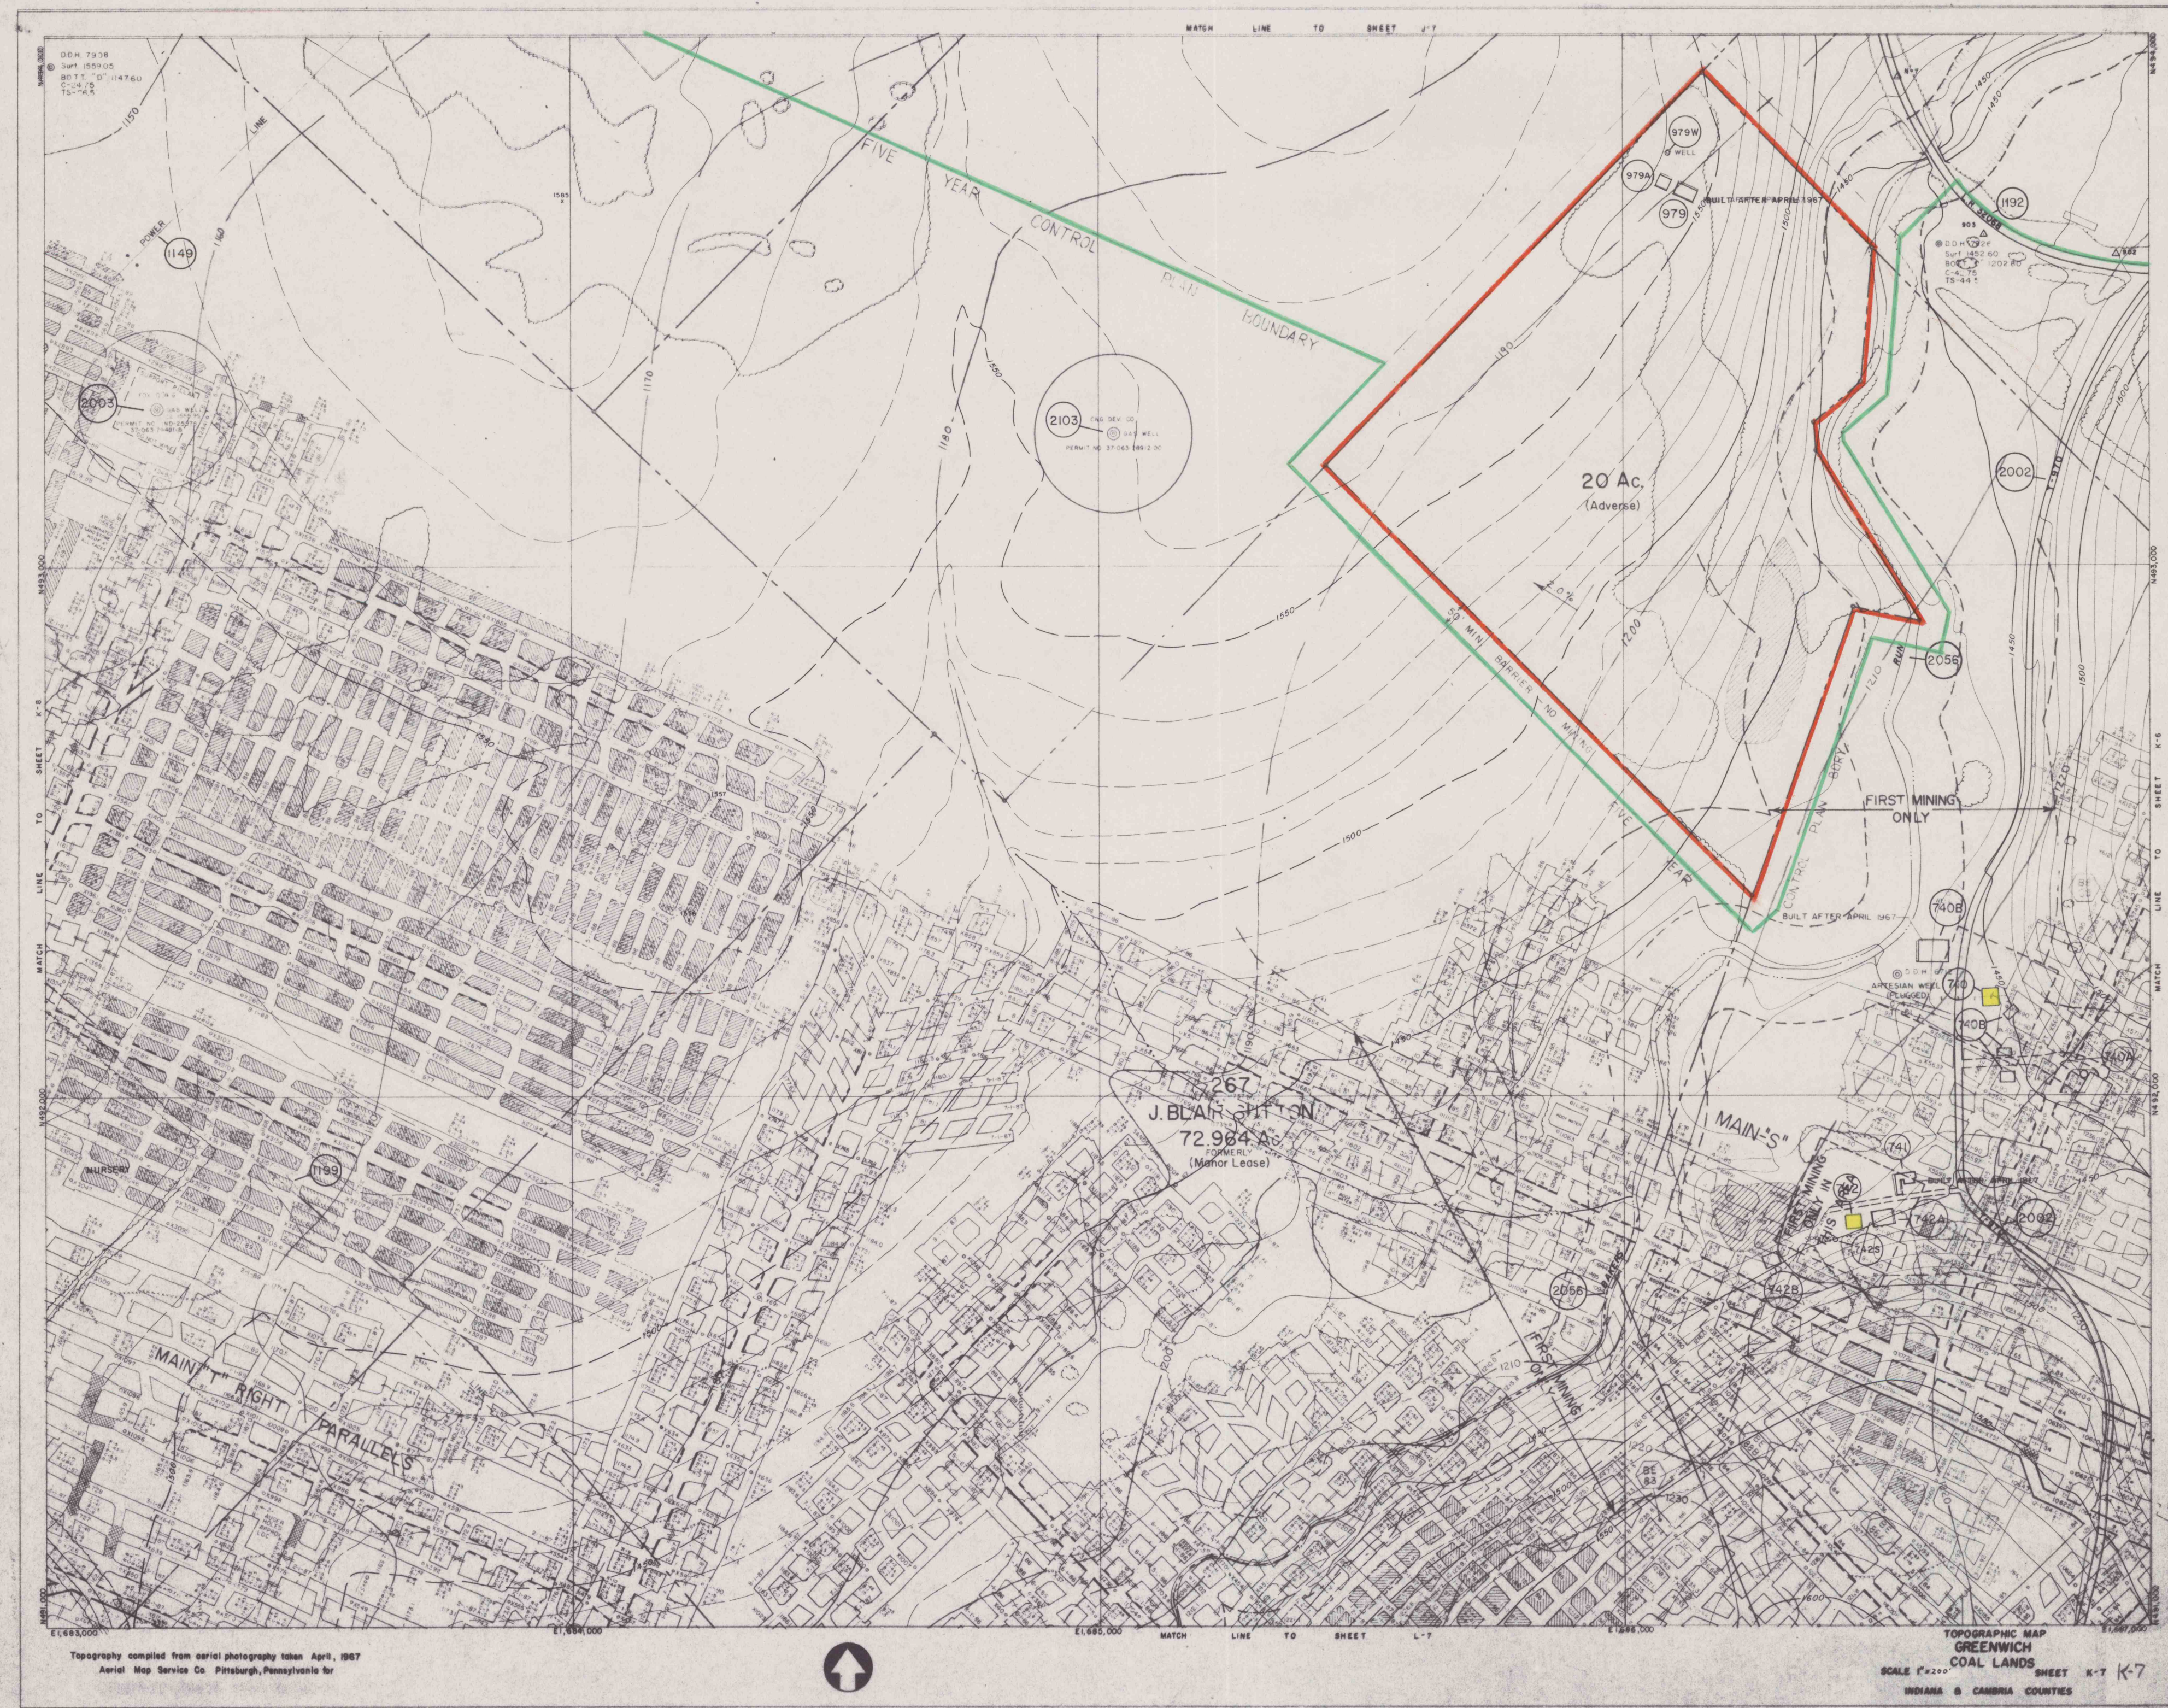

4-24-92

GREENWICH COLLIERIES
NO'S 1 AND 2 MINES
DIV. OF PENNSYLVANIA MINES CORP.
LOWER FREEPORT "D" SEAM

GREEN & MONTGOMERY TWPS. INDIANA COUNTY, PA.
SCALE 1"=200' FINAL SURVEY DATE 3-28-92

DWELLINGS & CEMETERIES (IN PLACE BEFORE 1966 ACT)
PUBLIC BUILDINGS; IMPOUNDMENTS (PLUS 20 AC. FEET)
BOUNDARY OF MINE
POLITICAL SUBDIVISION BOUNDARIES
~~SIX MONTH SUBSIDENCE CONTROL BOUNDARY~~
FIVE YEAR SUBSIDENCE CONTROL BOUNDARY
PILLARS EXTRACTED
~~CALCULATED SUPPORT AREA~~
~~COAL PILLAR SUPPORT AREA~~
OUTCROP OF "D" SEAM
FEATURE IDENTIFICATION NO.
MINING IN SUPPORT AREAS WILL BE ON PROJECTED CENTERLINES WITH ENTRY WIDTHS NOT TO EXCEED 20 FEET EXCEPT IN COMBINATION BELT/TRACK ENTRIES WITH ENTRY WIDTH NOT TO EXCEED 22 FEET
MINERAL OWNERSHIP
SURFACE OWNERSHIP (ON PROPERTY MAP PRINTS)

JOHN DOE
CO-ORD. AC.
(FEE/LEASE)
01-1-01

RECEIVED
APR 29 1992
Dept. of Environmental Resources
McMurray District Office