


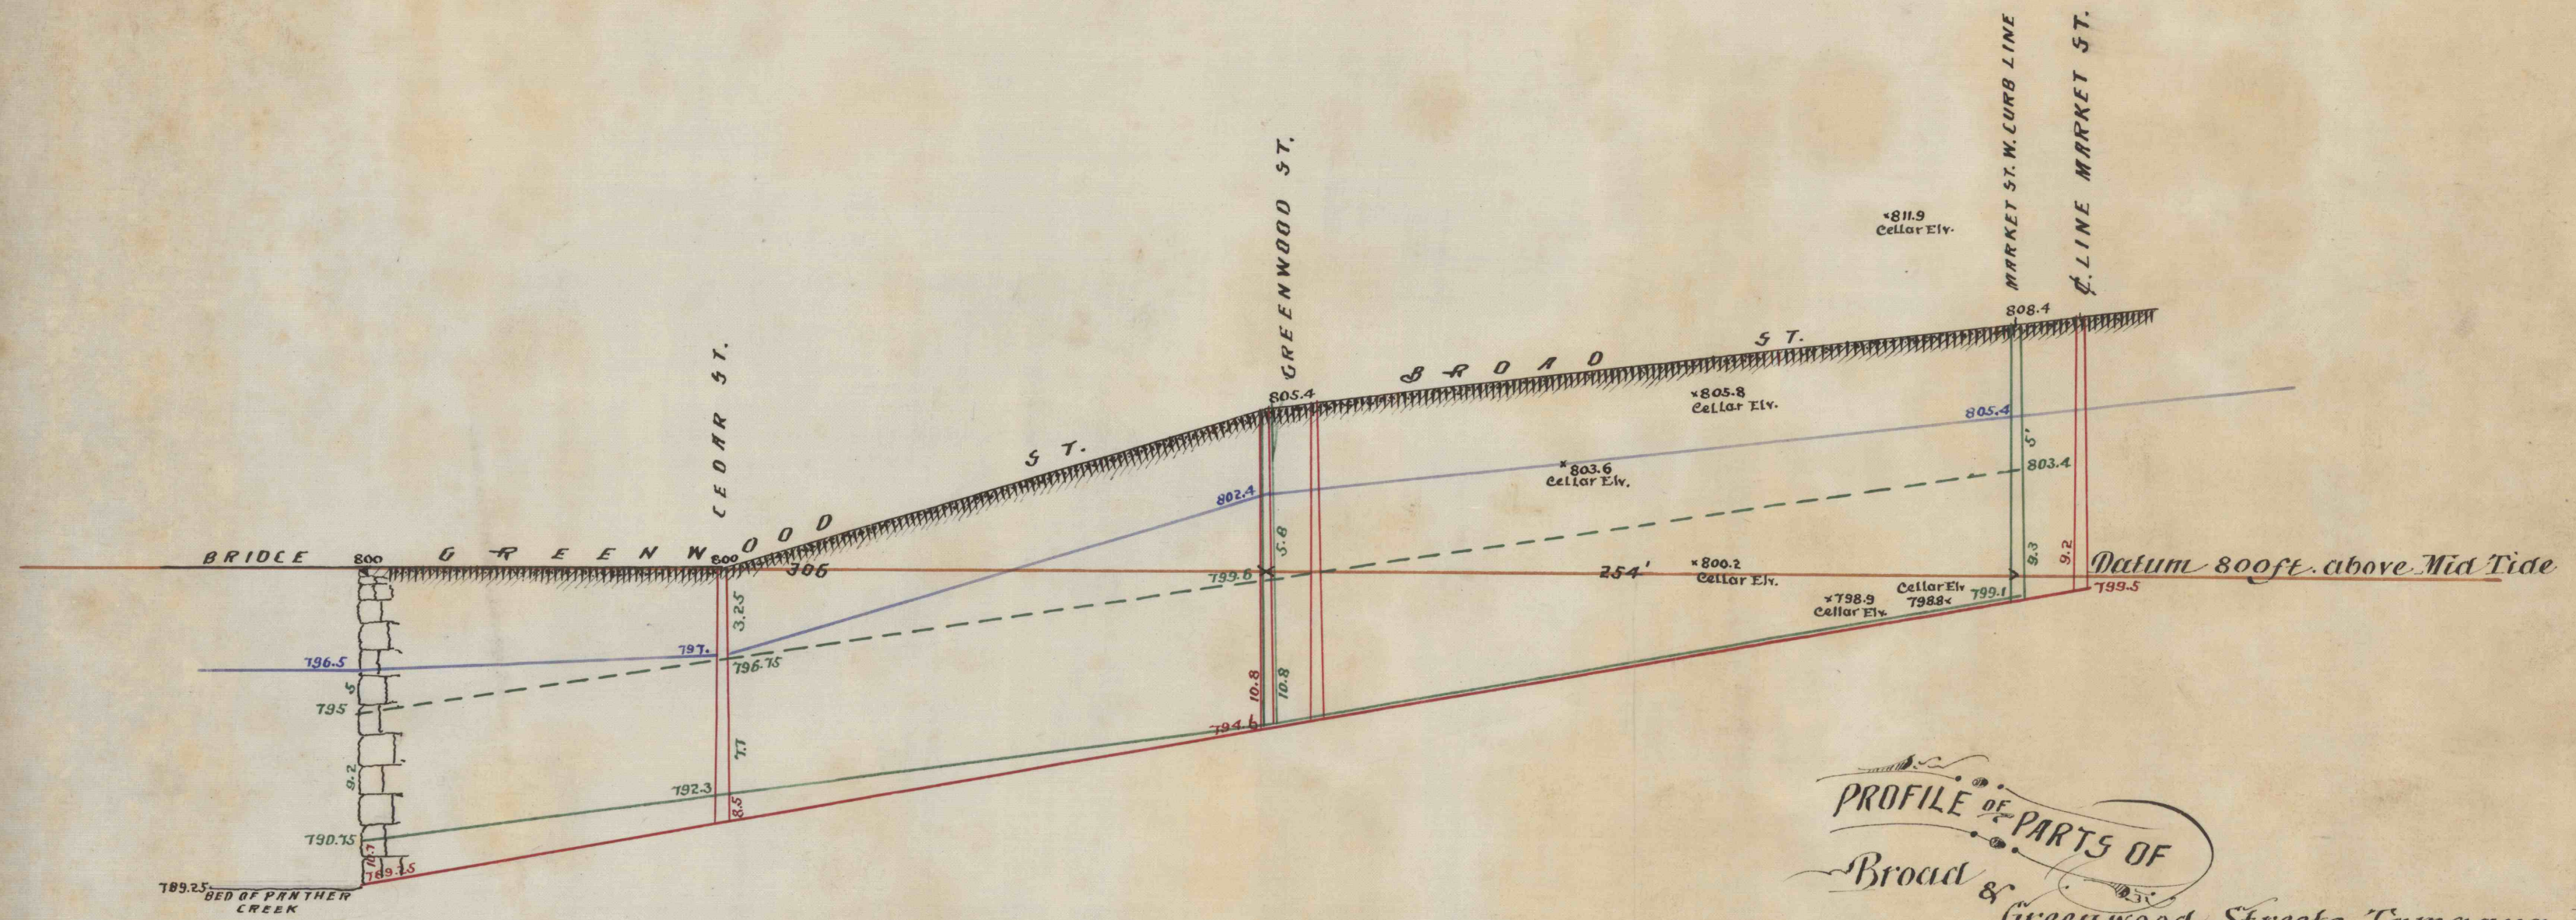

PROFILE OF PARTS OF
Broad & Greenwood Streets Tamaqua Penna.
SHOWING Proposed Sewers

Red lines showing profile of system as planned by C. P. Bassett
 Green lines solid showing profile of system proposed to be built
 " " dotted " " " possible location for draining only Houses on North
 side of Broad St. between Market & Greenwood Sts.
 Blue " " Water pipes

SCALES
 Horizontal 1"=50'
 Vertical 1"=5'

Heber S. Thompson }
 James Archbald Jr. } ENGS.
 POTTSVILLE PA.
 June 12 1900