


Sketch # 1-3-4.

JOHN BRADY TRACT

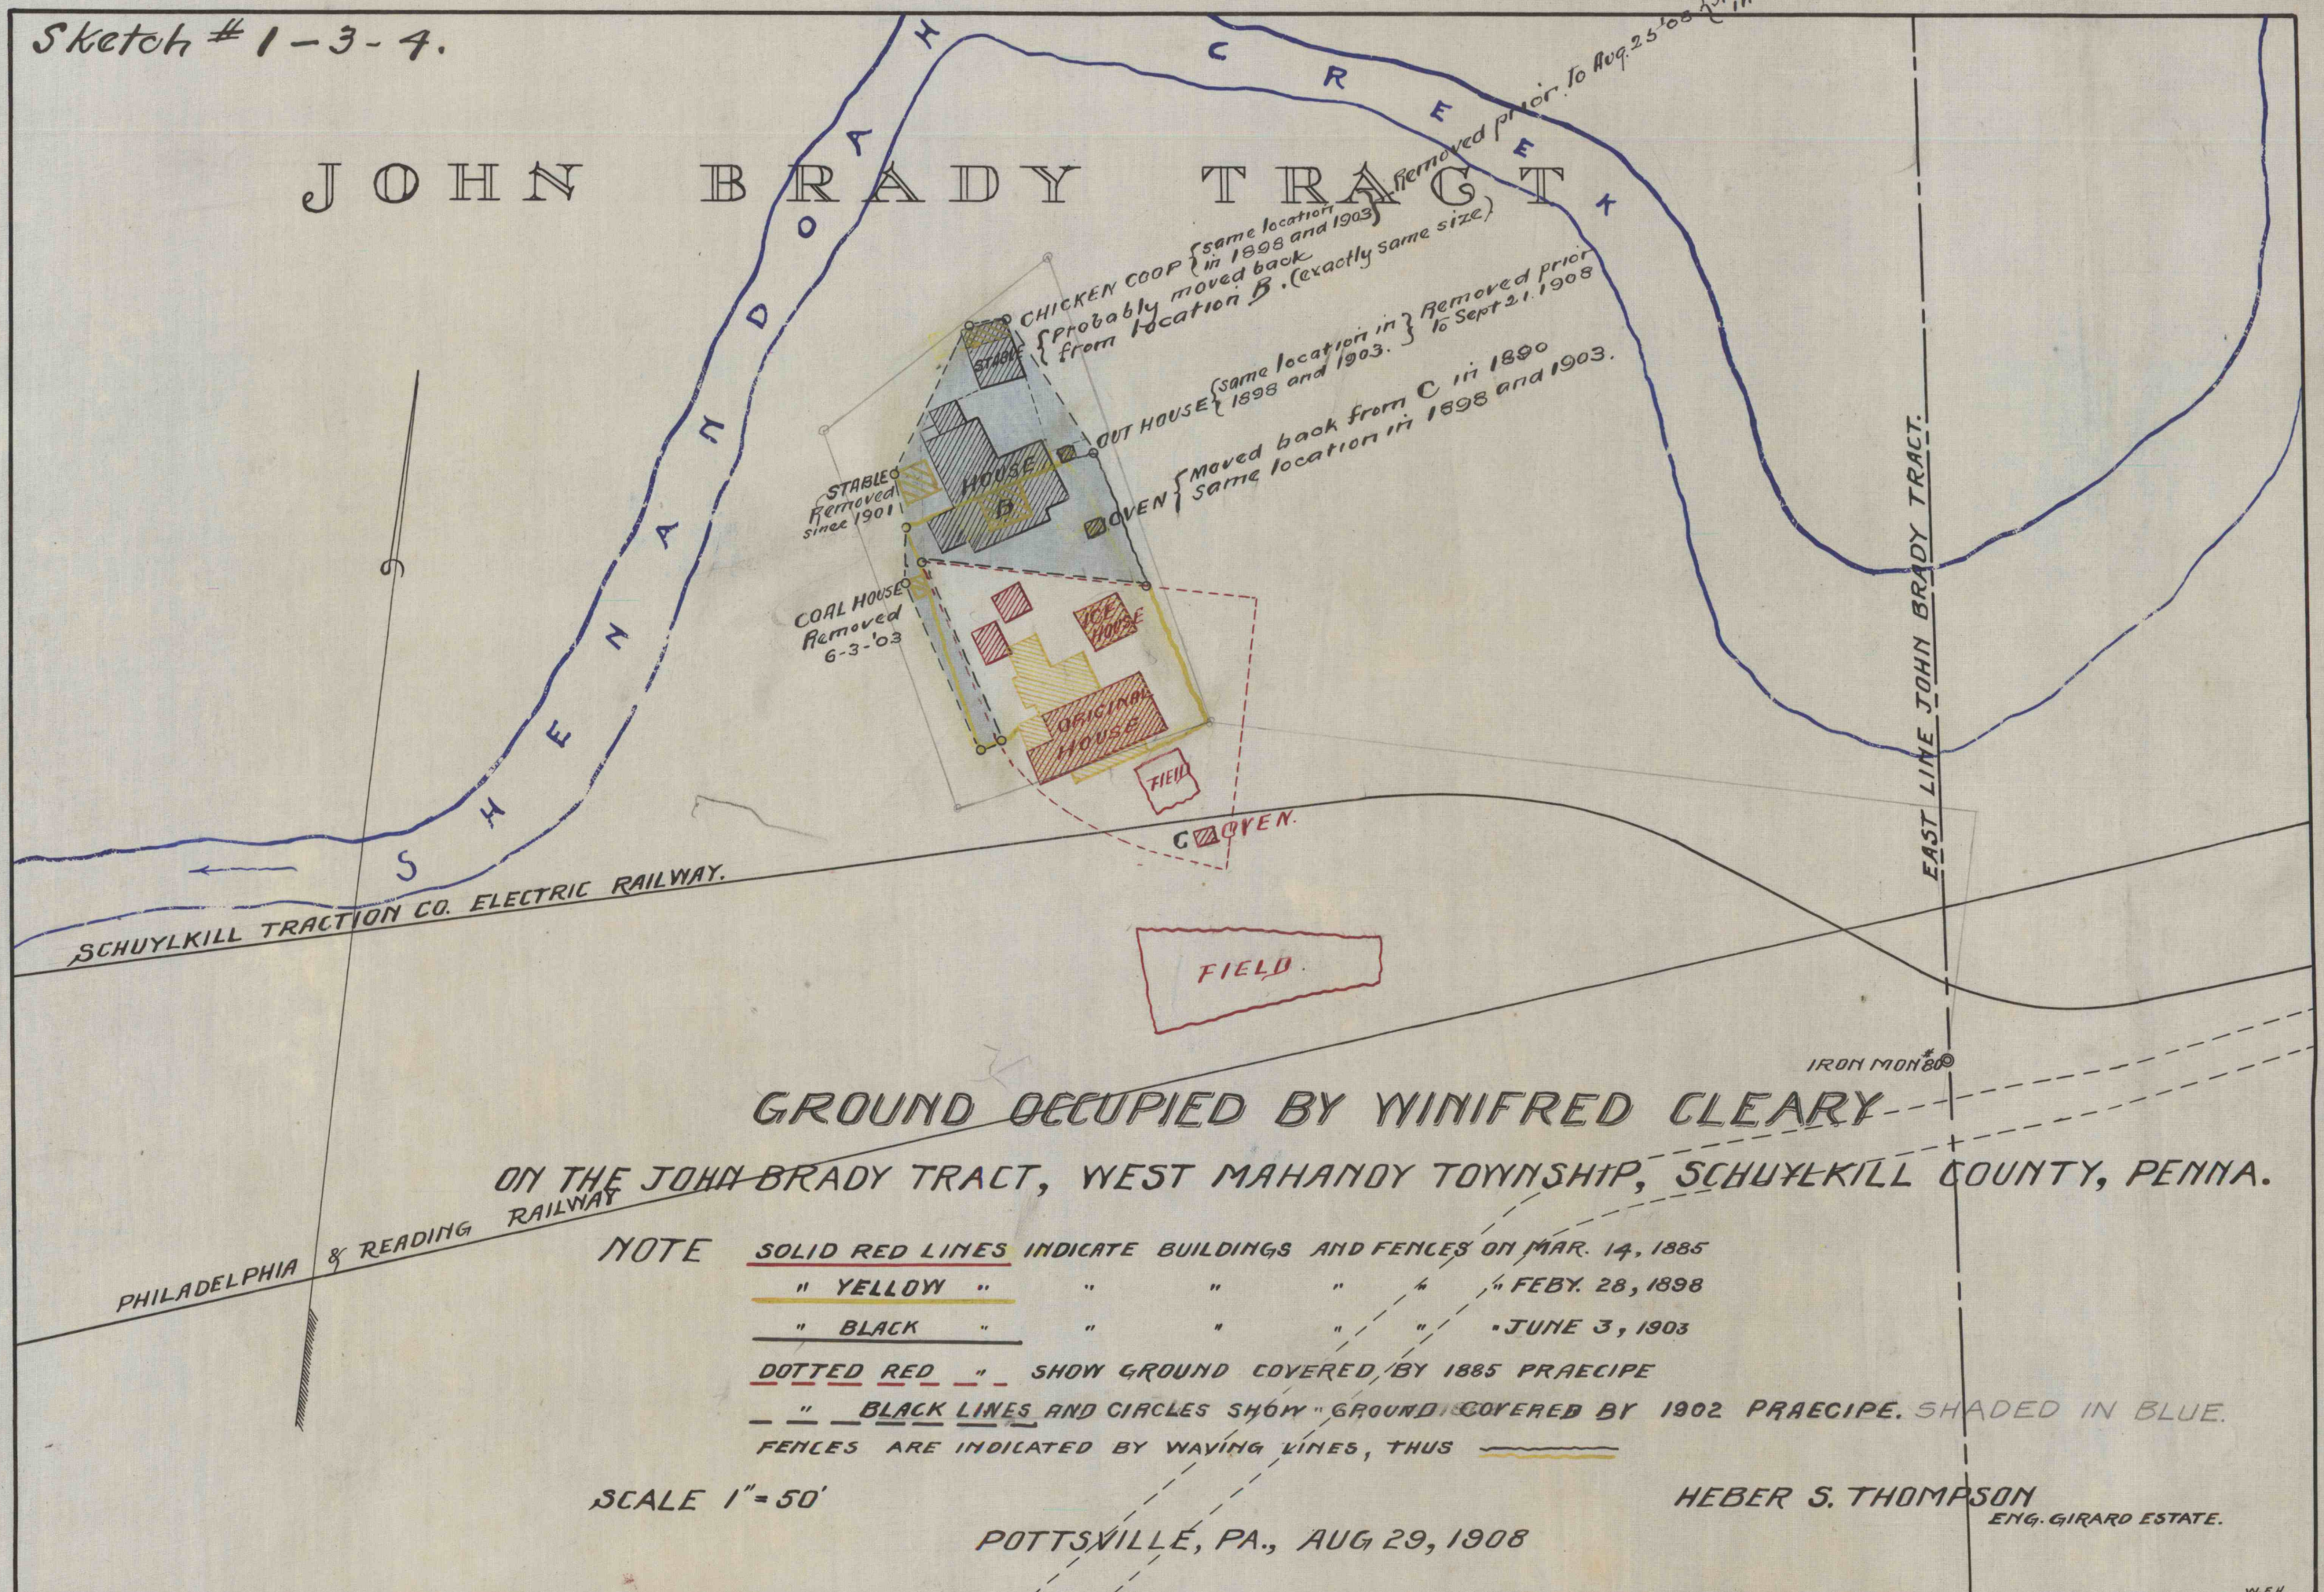

GROUND OCCUPIED BY WINIFRED CLEARY

ON THE JOHN BRADY TRACT, WEST MAHANDY TOWNSHIP, SCHUYLKILL COUNTY, PENNA.

NOTE

SOLID RED LINES INDICATE BUILDINGS AND FENCES ON MAR. 14, 1885

" YELLOW " " " " " " FEBY. 28, 1898

" BLACK " " " " " " " JUNE 3, 1903

DOTTED RED " " SHOW GROUND COVERED BY 1885 PRAECIPE

" BLACK LINES AND CIRCLES SHOW " GROUND COVERED BY 1902 PRAECIPE. SHADED IN BLUE.

FENCES ARE INDICATED BY WAVY LINES, THUS

SCALE 1" = 50'

POTTSVILLE, PA., AUG 29, 1908

HEBER S. THOMPSON

ENG. GIRARD ESTATE.