

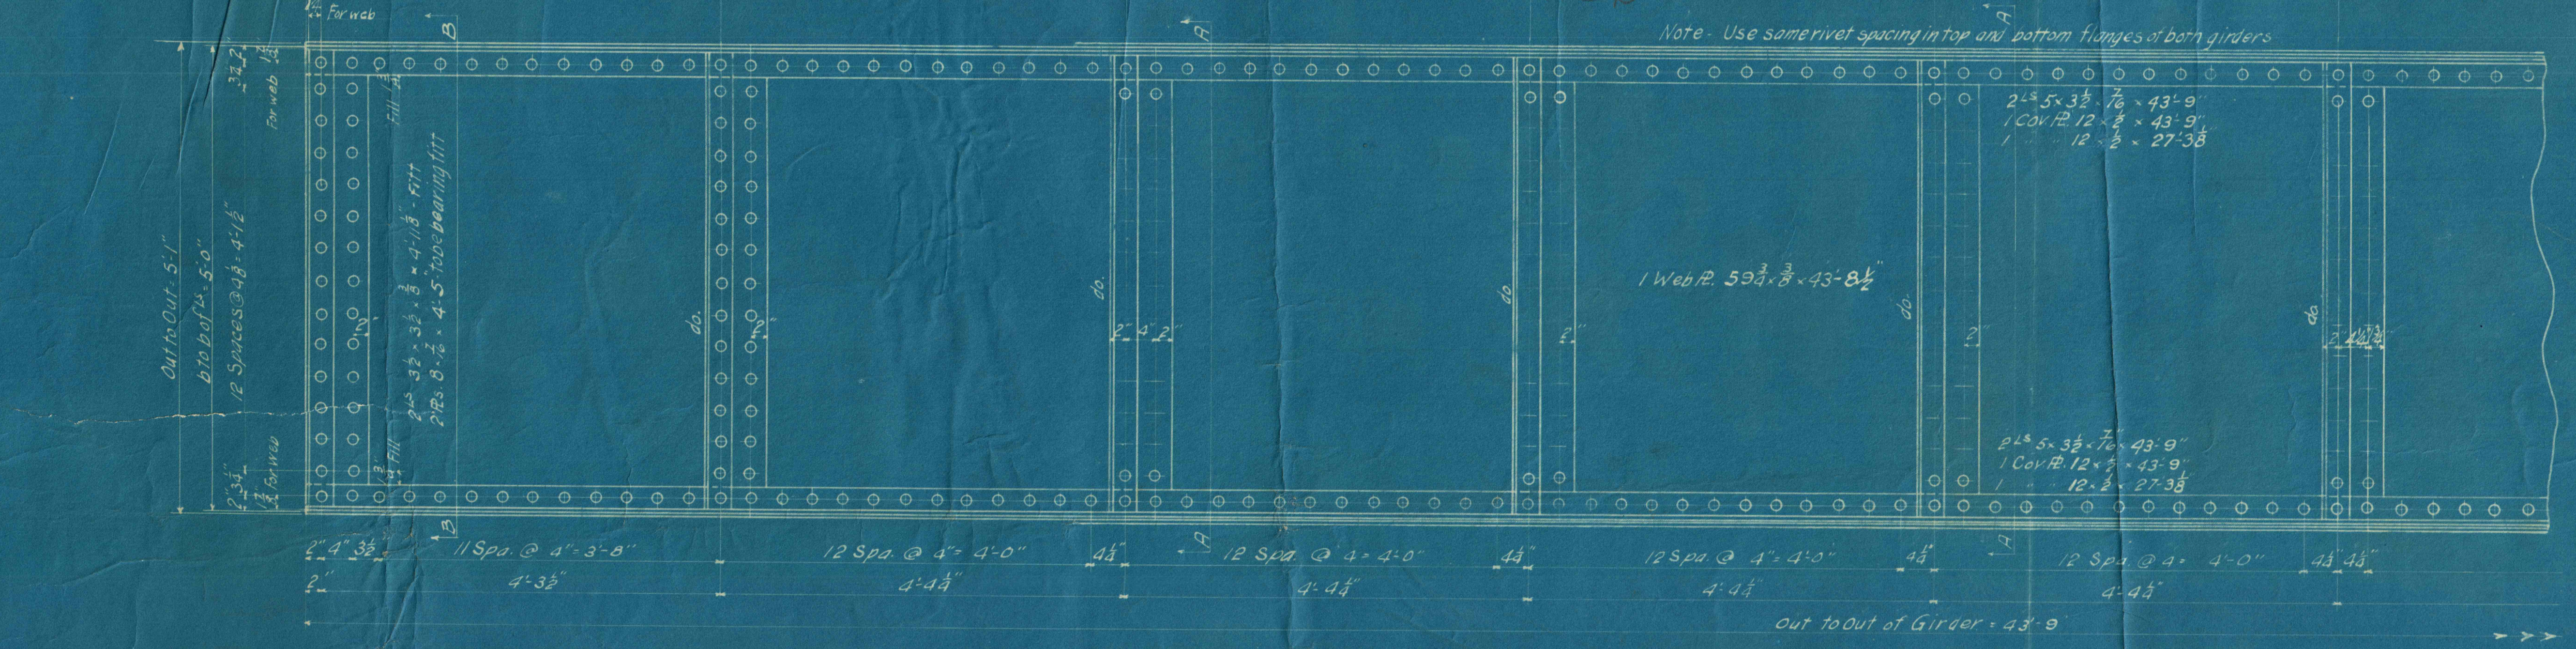
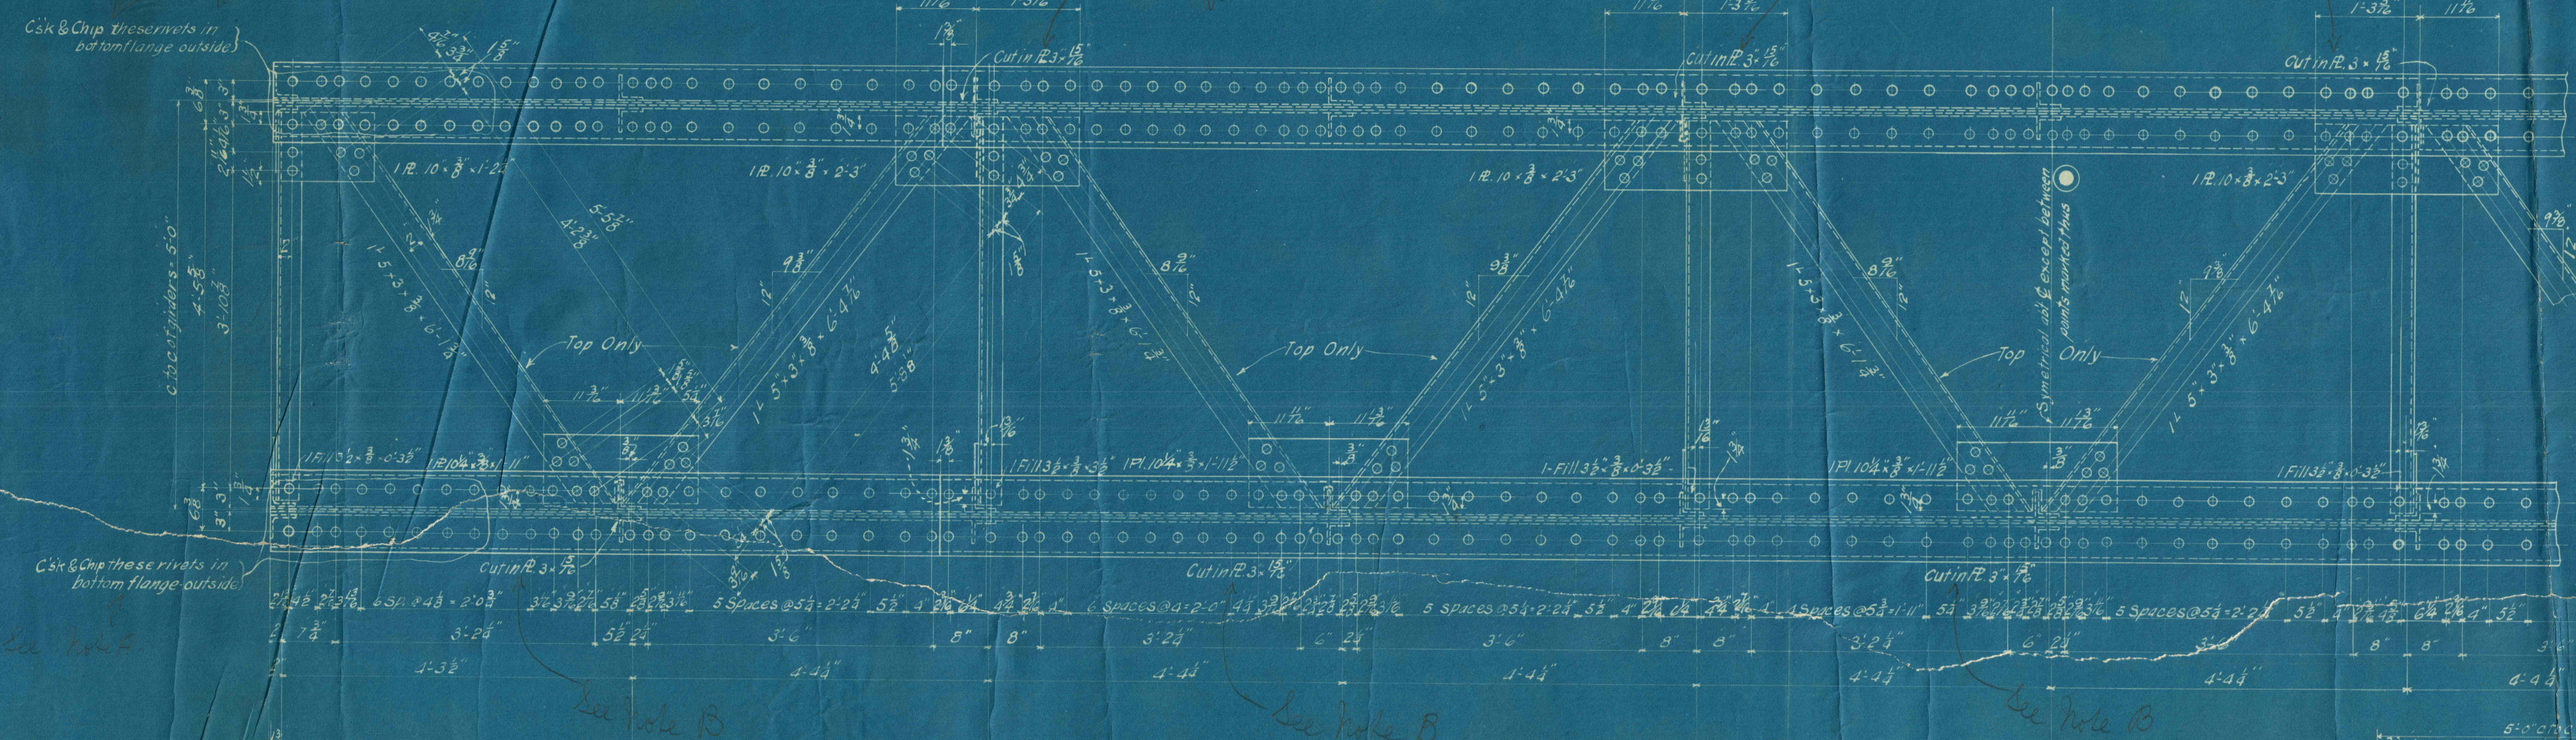


Note: Detail for an angle plate, however, should be made in accordance with the drawing and specifications. M.S. Stanley

Note B These plates need not be cut off one leg if angle is advanced joint enough to make bearing full against plate. M.S. Stanley

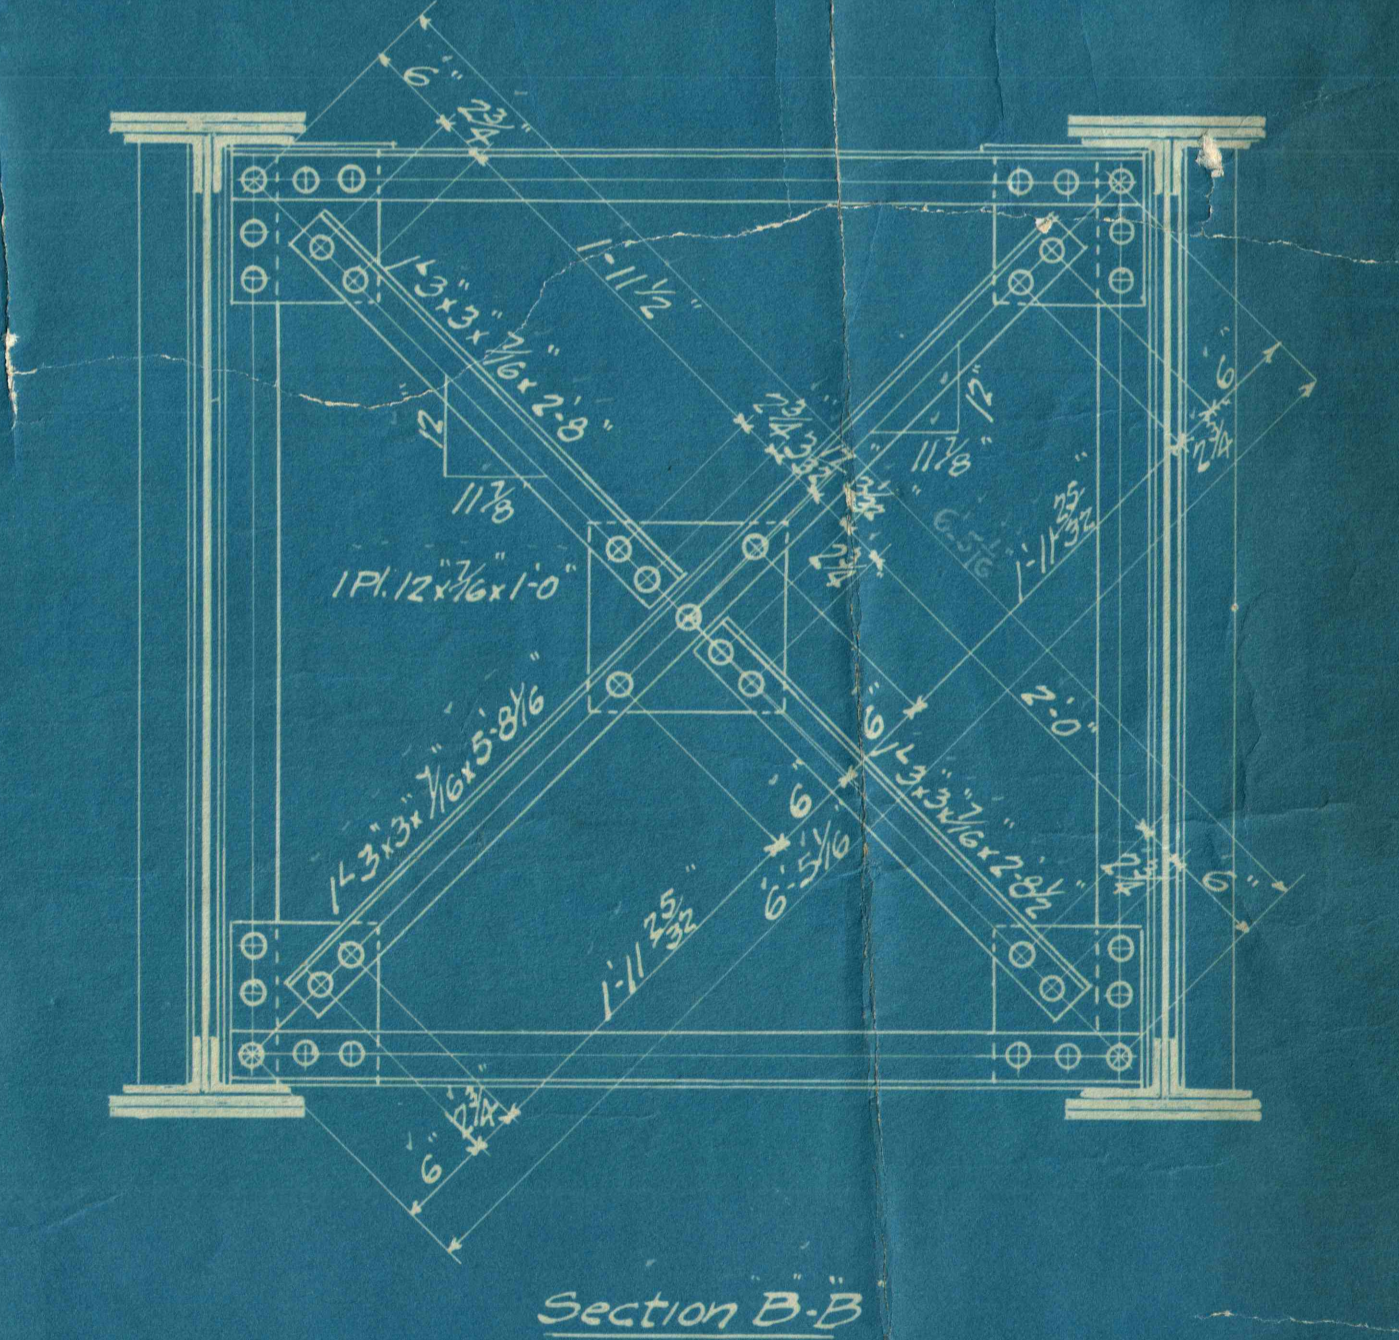

MAKE 1 GIRDER BRIDGE - MARK G I

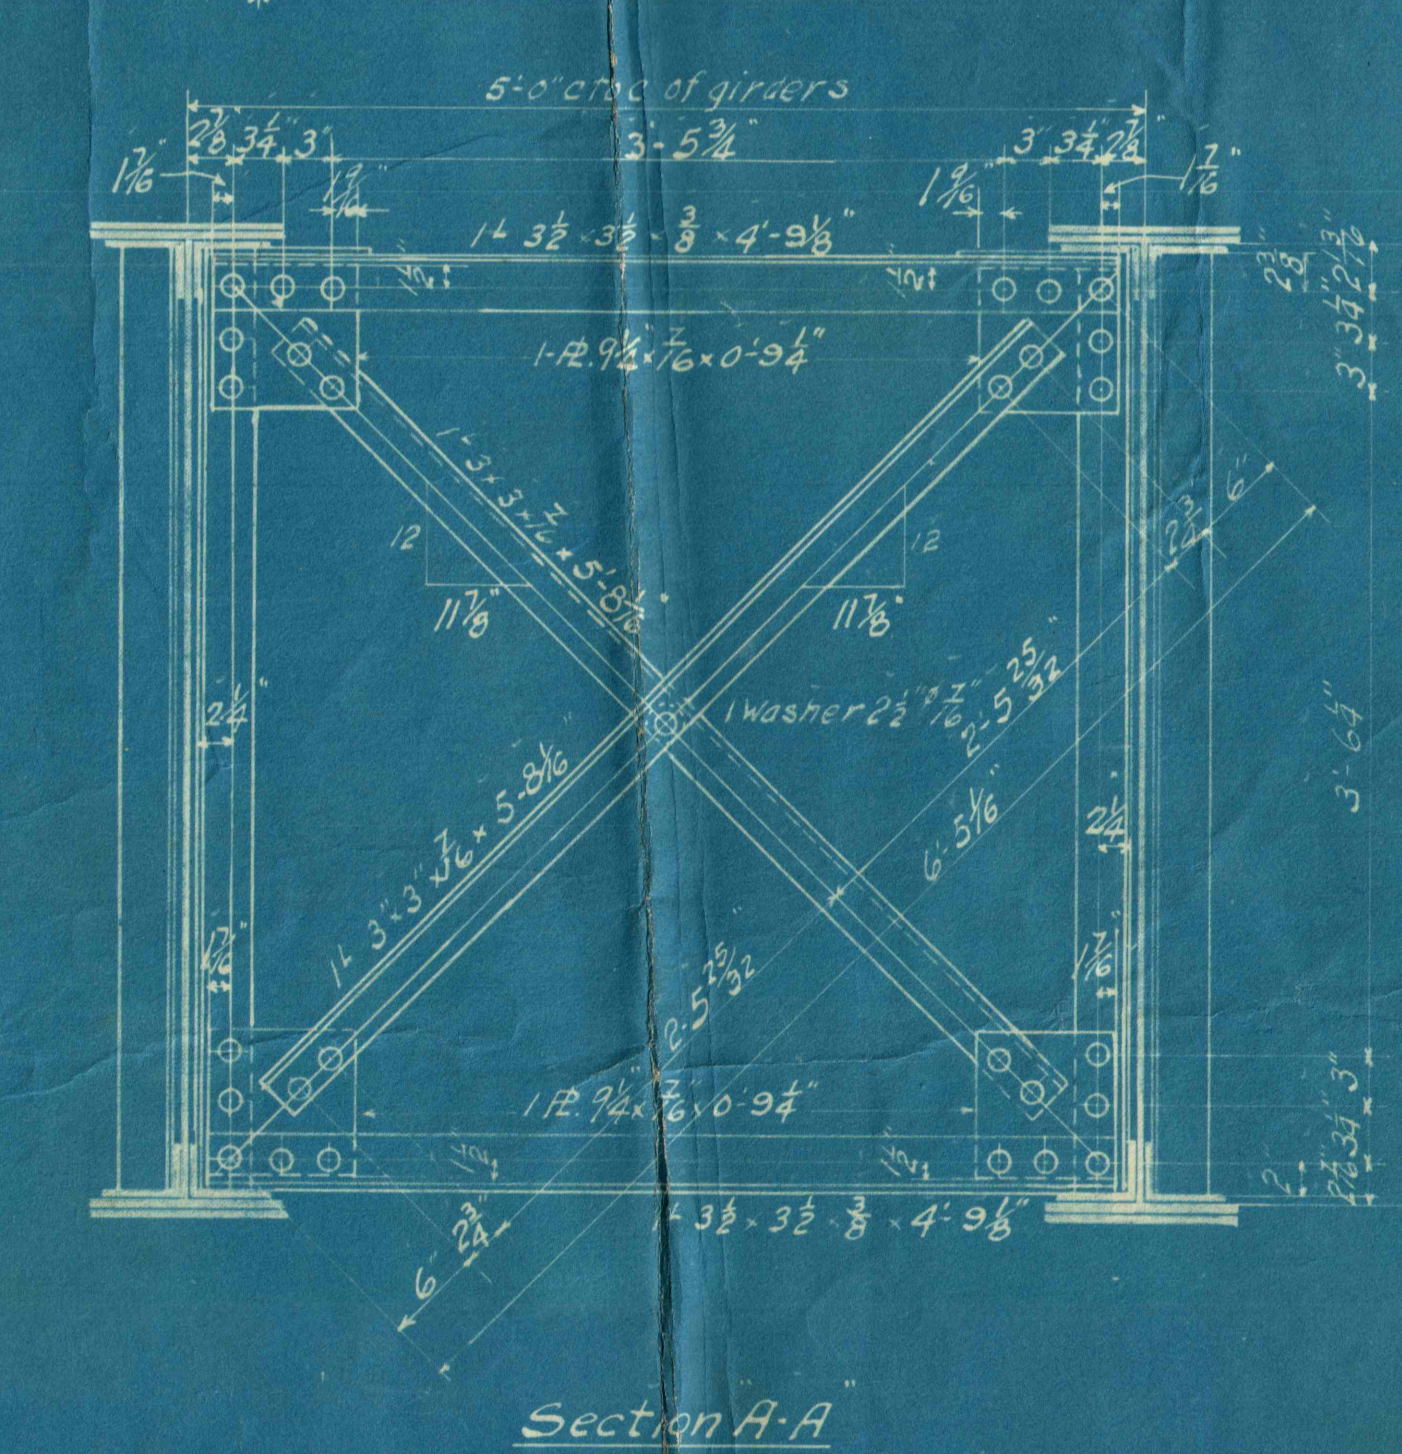

Note: Other material and dimensions not given for Section B-B - same as Section A-A

Girder Bridge for PennGas Coal Company Mine # 5 Penn Sta Westmoreland Co. Pa.

PAINT: COAT OF P.R.R. OXIDE RED + LINSEED OIL.

CAMBRIA STEEL CO., STRUCT. DEPT.
Rivets 7/8" Diam. ~~5/16"~~
Open Holes 5/8" Diam. ~~3/16"~~
In Charge of Frank M. Dr. by J.L. Tr. by A.L.B.
Date 1-5-10 Checked by J.F.
Revised
ORDER No. 6677 DRG. No. 1