
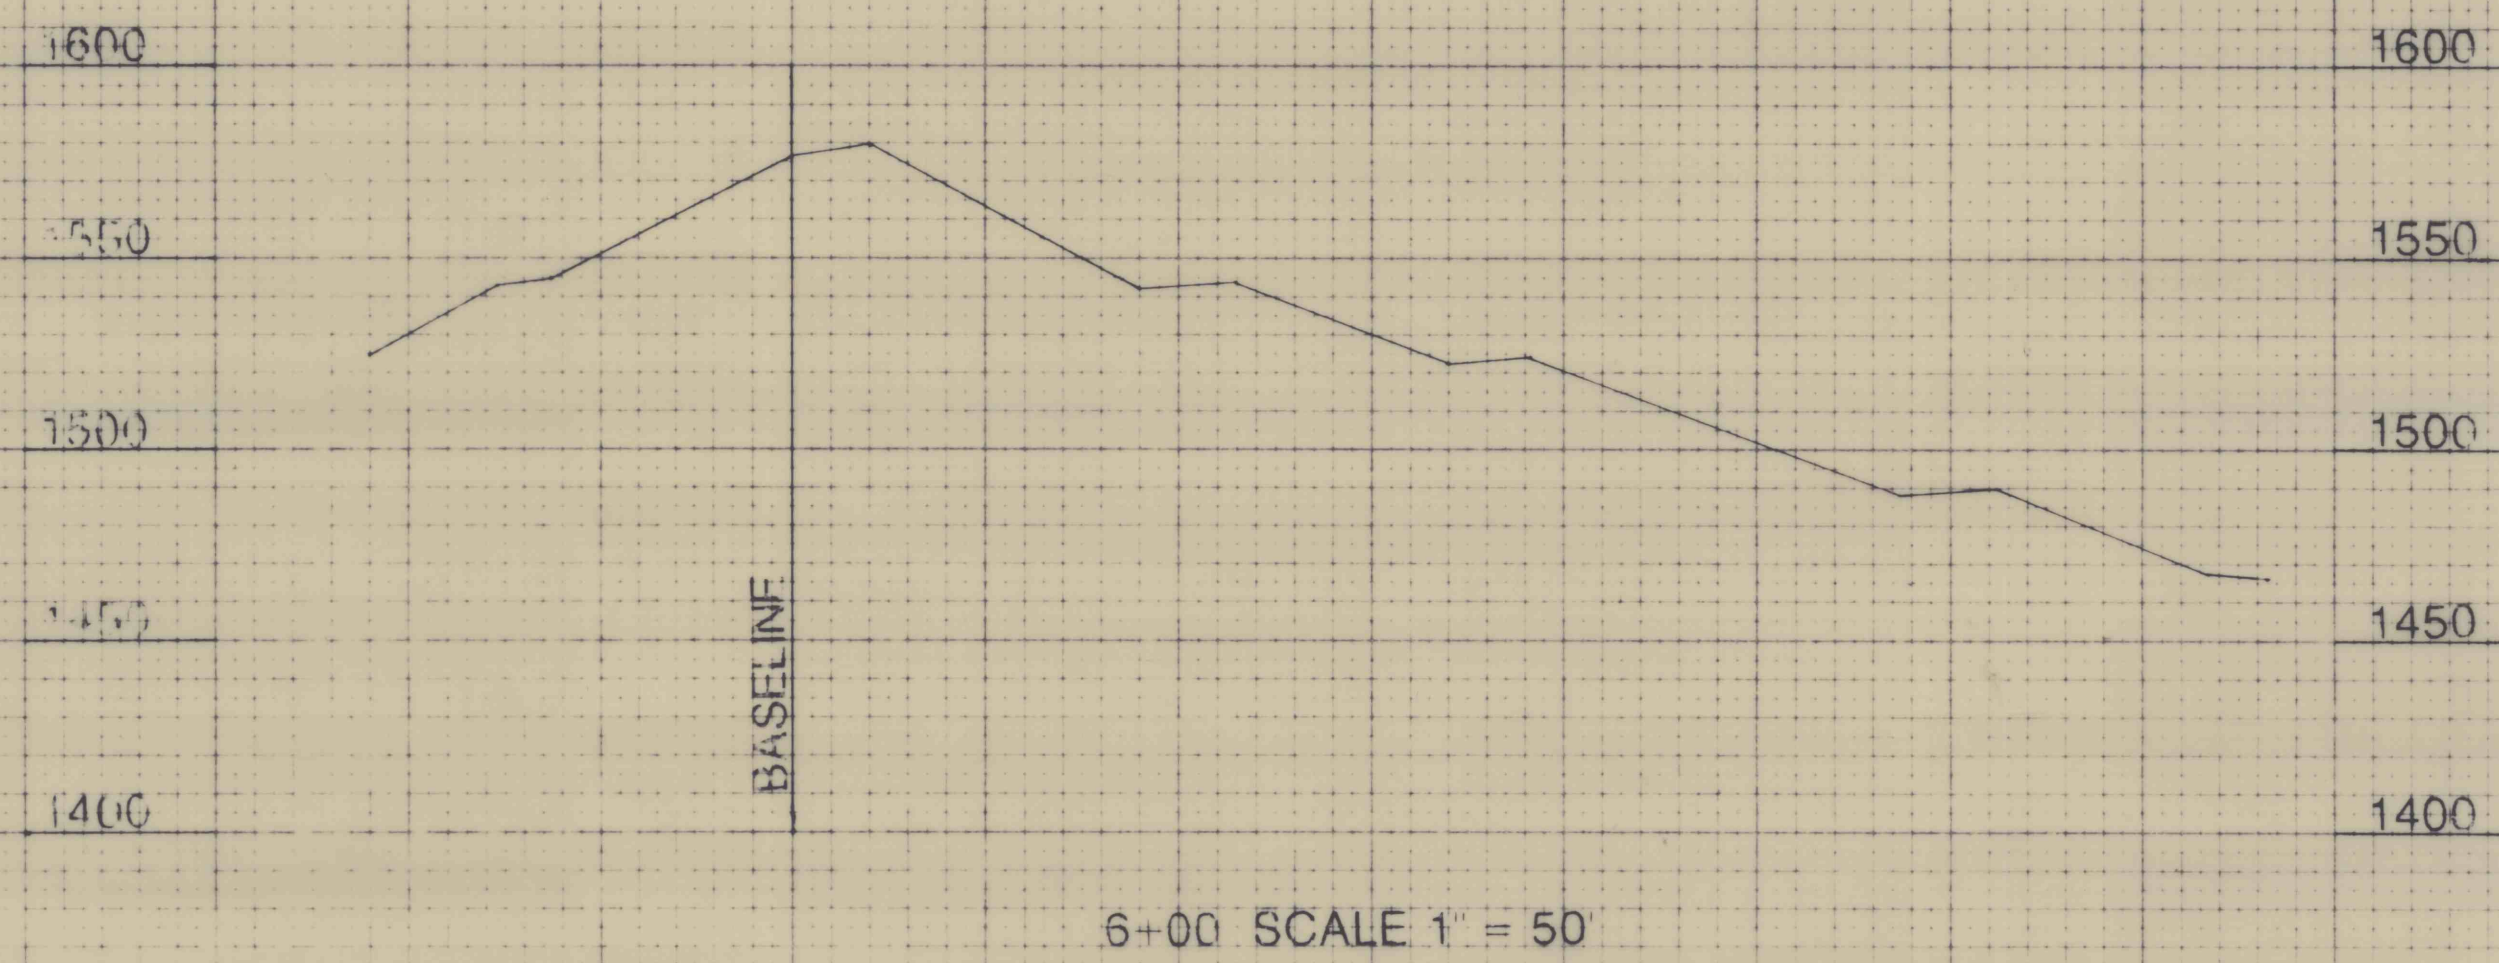


FINAL SURVEY
 DATE: _____
 BY: _____
 CHECKED: _____
 DATE: _____

ORIGINAL SURVEY
 DATE: _____
 BY: _____
 CHECKED: _____
 DATE: _____

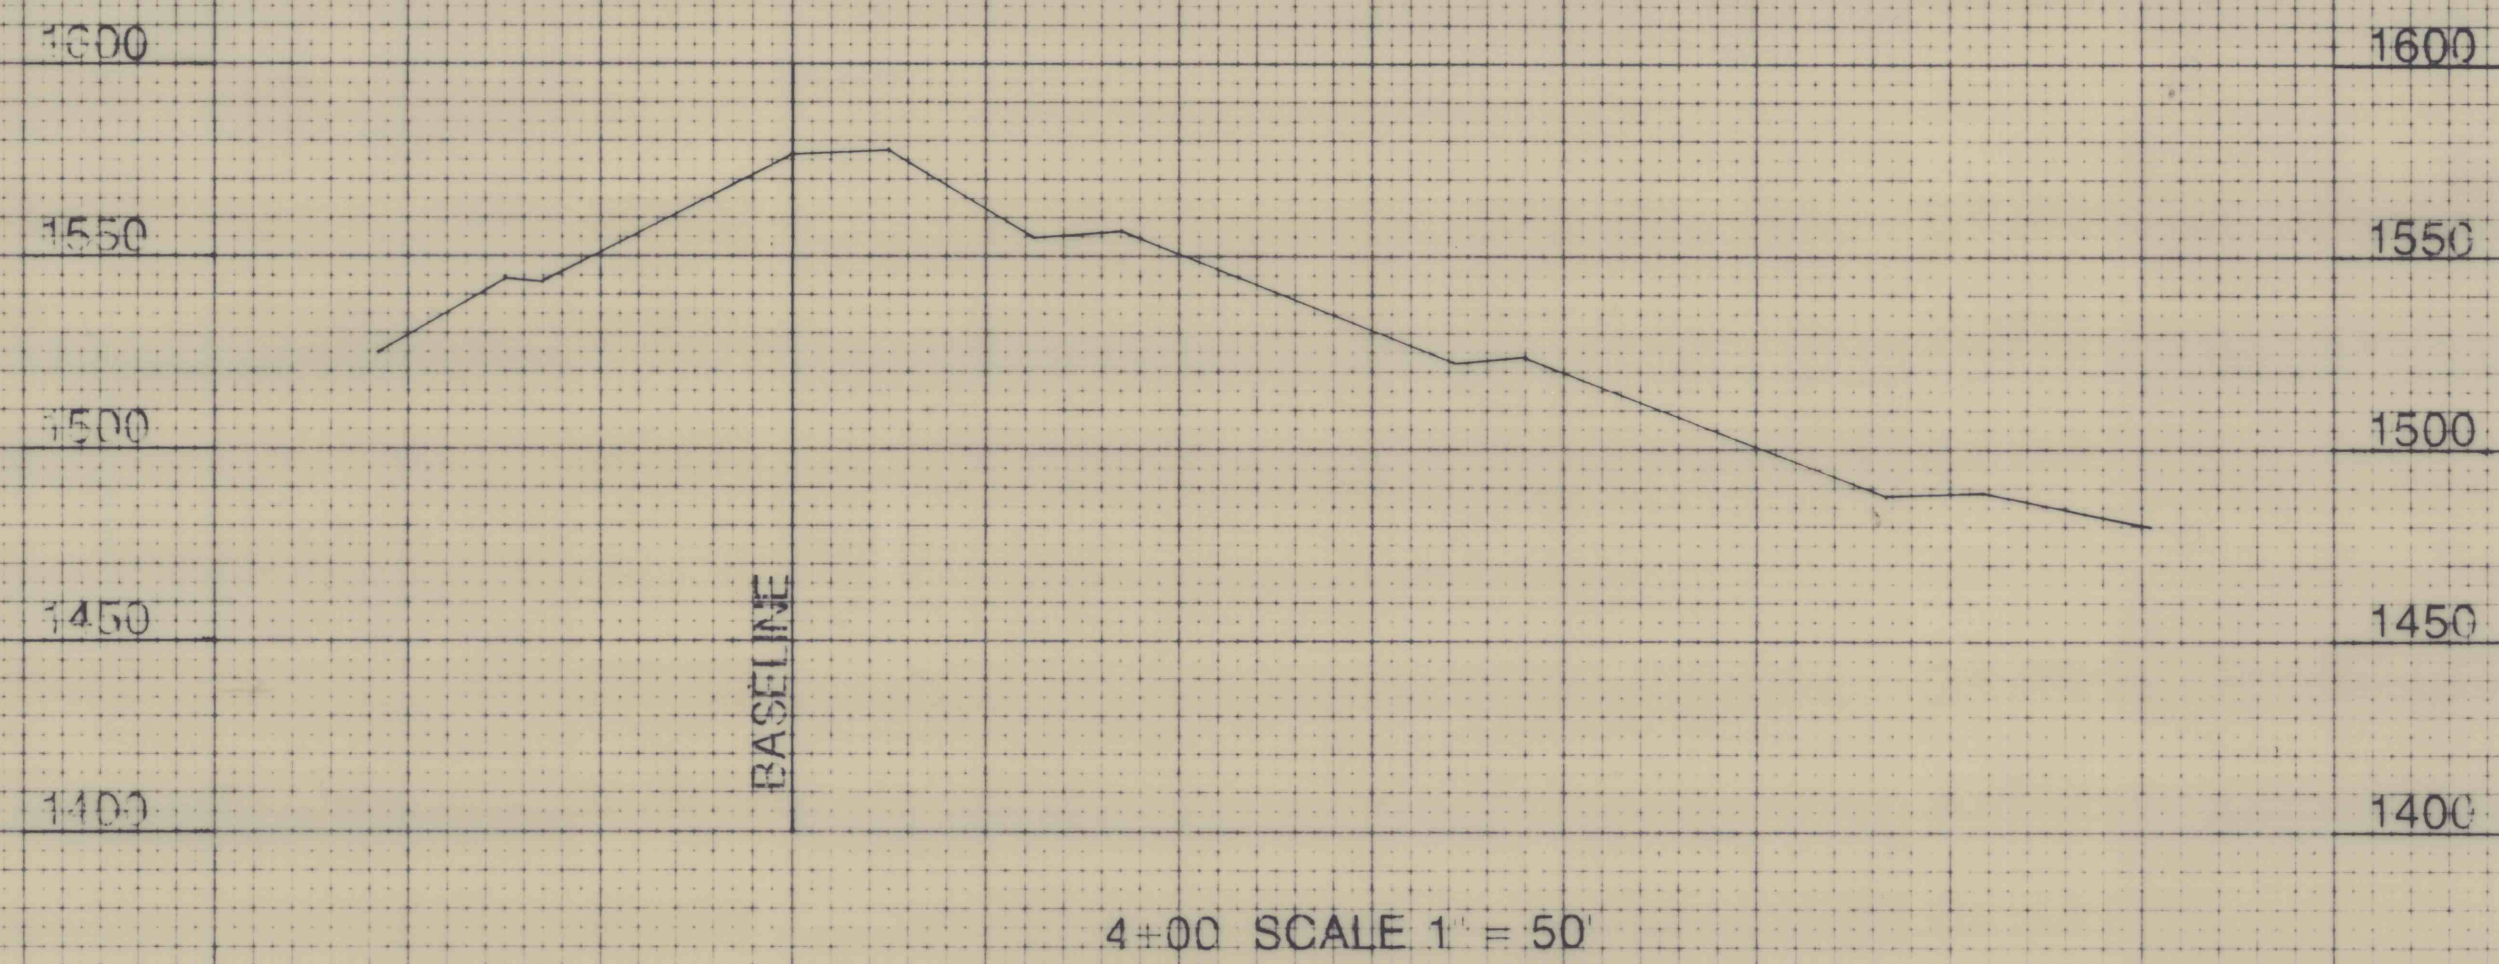

DWG. NO.	SURV. NO.	NO.	DATE	BY
NORTH HOLLOW IMPOUNDMENT AS BUILT SECTIONS				
BETHENERGY MINES INC.				
SOUTHERN DIVISION CHARLESTON, W.VA.				
DESIGN	DRAWN	CHECKED	DATE	DESP. NO.
APR. 24, 1988	1/14/88			
SCALE 1" = 50'				FILE NO. 15-15-45
APPROVED				DWG. NO. 101-R4-238
DATE				